IREDELL COUNTY HEALTH DEPARTMENT

Paid 175.00 BT

STATESVILLE 704-878-5305 MOORESVILLE 704-664-5281

IMPROVEMENT PERMIT / AUTHORIZATION TO CONSTRUCT / OPERATION PERMIT / EXISTING SYSTEM INSPECTION

PERMIT# 090810 PIN# 4677 79 7793 4677 79 7582 DATE 9/8/00

OWNER OR CONTRACTOR Eufemio Granados PHONE: Business 662-9430 Home

ADDRESS 137 Granados Ln. Mooresville, NC. 28115

LOCATION 150E TL Pineridge TL Granados, on (R) corner

SUBDIVISION No BLOCK / SECTION LOT 22 LOT AREA 2.0 AC SITE CLASS. PS DESIGN FLOW 480 L.T.A.R. .3

Septic Tank: 1000 Gallons; STB 825 Date 3/9/01
Pump Tank: 1000 Gallons; PT 362 Date 3/18/01
Pump Make: ZOELLER Model N98-B Serial No. 5/01
Nitrification Field: No Fields 1 Square Feet 1600 Linear Feet 533
No Lines 4@133' Trench Width 3' Max Trench Bottom Depth 3'


[X] New System [ ] Repair System Type: I, II, III, IV, V, VI ACCR
System Description: Pres Man. ~~Eq Dist Effluent~~
Repair System Description: Same CONV.
Maintenance Agreement Required: [ ] Yes [X] No
Gravel Depth 12"

[X] House/Mod. Home No. Bedrooms 4
[ ] Mobile Home No. Bathrooms 3
[ ] Business No. Employees
[ ] Other
[ ] Slab [ ] Crawl Space [X] Basement w/plumbing [ ] Basement wo/plumbing

Water Supply: [X] Individual [ ] Public [ ] Community

Comments:/Conditions:

INITIAL SITE SKETCH

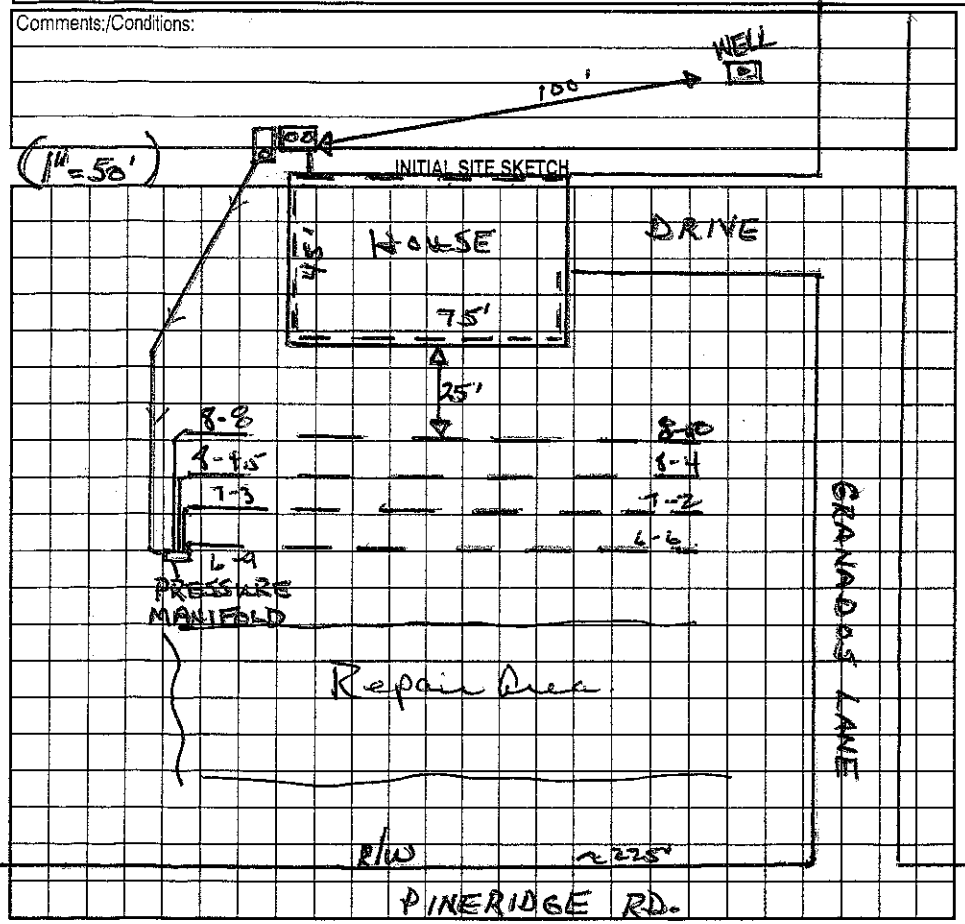

Comments:/Conditions:

AS BUILT SKETCH

Permit can be suspended or revoked if any false information is supplied toward securing the permit/any unauthorized changes are made to the site/any unauthorized changes are made in the installation of the system. Improvement Permit with plat valid without expiration. Improvement Permit with site plan valid for sixty months. Authorization to Construct is valid for a period equal to that of Improvement Permit – not to exceed sixty months.

Signed: * Eufemio Granados date

Improvement Permit by: Wesley Sparks R.S. date 9/8/00

Authorization to Construct by: Wesley Sparks R.S. date 9/8/00

Installed by: Bobs Backhoe

Operation Permit by: Maria H. Dotson R.S. date 8/10/01

Existing System Inspection by: date

HEALTH DEPT. COPY: WHITE OWNER COPY (FINAL): YELLOW OWNER COPY (INITIAL): PINK