IREDELL COUNTY HEALTH DEPARTMENT

STATESVILLE 704-878-5305 MOORESVILLE 704-664-5281

IMPROVEMENT PERMIT / AUTHORIZATION TO CONSTRUCT / OPERATION PERMIT / EXISTING SYSTEM INSPECTION

PERMIT# 125775 PIN# 4677804237 DATE 1-24-05

OWNER OR CONTRACTOR America's Home Place PHONE: Business 664-5800 Home

ADDRESS 108-D Norman Station Blvd. Mooresville, NC 28117

LOCATION Hwy 153 E TR Teeter Rd TL Magnolia Ridge at corner of Oakwood

SUBDIVISION Magnolia Ridge BLOCK / SECTION LOT 4 LOT AREA 1.0 Acre SITE CLASS. SPS DESIGN FLOW 480 gpd L.T.A.R. .3

Septic Tank: 1000 Gallons; STB 1001 Date 1-25-05

Pump Tank: Gallons; PT Date

Pump Make: Model Serial No.

Nitrification Field: No Fields 1 Square Feet 1599 Linear Feet 533'

No Lines 4@133'ea Trench Width 36" Max Trench Bottom Depth 24-36" Gravel Depth 12"

☒ New System ☐ Repair System Type: I, II, III, IV, V, VI

System Description: Gravity-Conventional

Repair System Description: Pump - 25%-50% Reduction

Maintenance Agreement Required: ☐ Yes ☒ No

☒ House/Mod. Home No. Bedrooms 4

☐ Mobile Home No. Bathrooms 3.5

☐ Business No. Employees

☐ Other

☐ Slab ☒ Crawl Space ☐ Basement w/plumbing ☐ Basement wo/plumbing


Water Supply: ☒ Individual ☐ Public ☐ Community

Comments:/Conditions: Note: Must pull out plumbing high enough to maintain gravity flow from ST to Distribution box, otherwise pump will be needed


Comments:/Conditions: Keep Septic System at least 10' from PL, 100' from well & 15' from future pool

Filter installed

INITIAL SITE SKETCH Scale 1:50

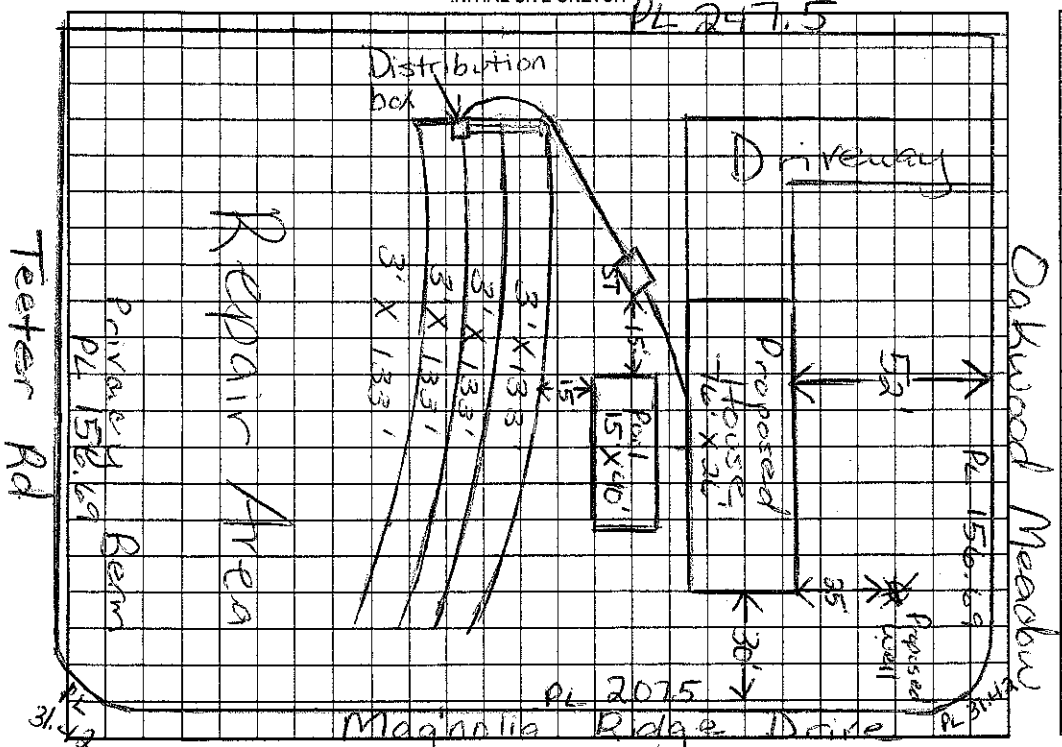

AS BUILT SKETCH

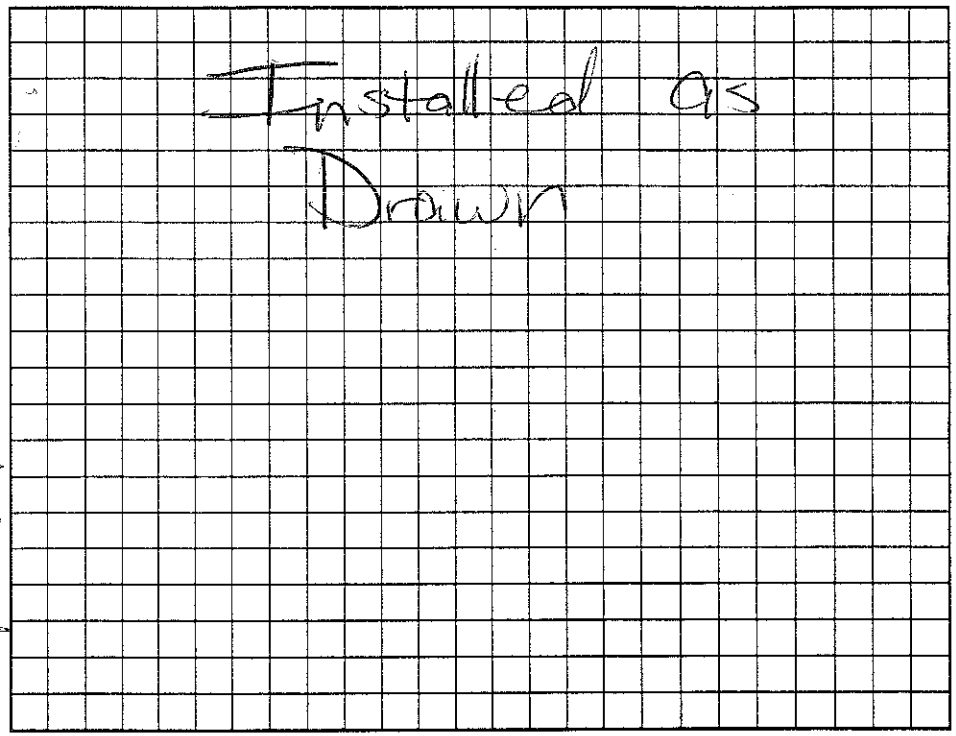

Permit can be suspended or revoked if any false information is supplied toward securing the permit/any unauthorized changes are made to the site/any unauthorized changes are made in the installation of the system. Improvement Permit with plat valid without expiration. Improvement Permit with site plan valid for sixty months. Authorization to Construct is valid for a period equal to that of Improvement Permit – not to exceed sixty months.

Signed: Garrett K McDonald date 1/27/05 Installed by: Iredell Backhoe

Improvement Permit by: Maria H Dotson RS date 1/24/05 Operation Permit by: Maria H Dotson RS date 3/10/05

Authorization to Construct by: Maria H Dotson RS date 1/24/05 Existing System Inspection by: date

HEALTH DEPT. COPY: WHITE OWNER COPY (FINAL): YELLOW OWNER COPY (INITIAL): PINK