IREDELL COUNTY HEALTH DEPARTMENT

STATESVILLE 704-878-5305 150.00 Fee MOORESVILLE 704-664-5281

IMPROVEMENT PERMIT / AUTHORIZATION TO CONSTRUCT / OPERATION PERMIT / EXISTING SYSTEM INSPECTION

PERMIT# 29239 PIN# 4677 80 4237 DATE 7/14/05

OWNER OR CONTRACTOR Amyra's Home Place PHONE: Business 664 5800 Home

ADDRESS 165-D Norman Station Blvd Mooresville NC 28117

LOCATION Linwood Rd, TL Teeter, TR Magnolia Ridge, TL Oakwood Meadow on Lt.

SUBDIVISION Magnolia Ridge BLOCK / SECTION LOT 4 LOT AREA 1.0 Ac. SITE CLASS. PS DESIGN FLOW 480 L.T.A.R. 0.3

Septic Tank: Existing Gallons: STB Date

Pump Tank: Gallons: PT Date

Pump Make: Model Serial No.

Nitrification Field: No Fields 1 Square Feet 150 Add Linear Feet 50' Add

No Lines 1 Trench Width 36" Max Trench Bottom Depth 36" Gravel Depth 12"

☐ New System ☐ Repair System Type: I, II, III, IV, V, VI

System Description: Conventional Addition

Repair System Description: 25% Reduction

Maintenance Agreement Required: ☐ Yes ☒ No

☒ House/Mod. Home No. Bedrooms 4

☐ Mobile Home No. Bathrooms

☐ Business No. Employees

☐ Other


☐ Slab ☒ Crawl Space ☐ Basement w/plumbing ☐ Basement wo/plumbing

Water Supply: ☒ Individual ☐ Public ☐ Community

Comments/Conditions: Adding 30x30 Garage
Remove gravel 10' From [illegible]. New starting point + fill + pack with soil

Comments/Conditions:

INITIAL SITE SKETCH

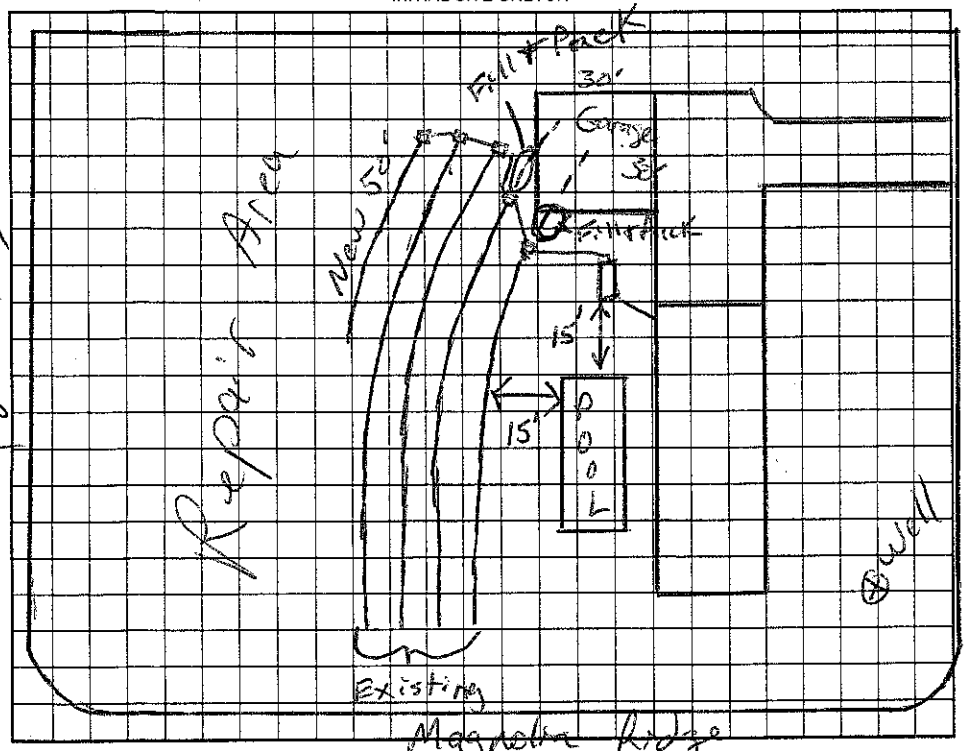

AS BUILT SKETCH

ICHD-Environmental Health Division

The proposed / ~~existing~~ Pool addition does not appear to impact the existing septic system.

**NOTE:

Judy Melville R.S.

Date: 7-16-09

ICHD-Environmental Health Division

Permit can be suspended or revoked if any false information is supplied toward securing the permit/any unauthorized changes are made to the site/any unauthorized changes are made in the installation of the system. Improvement Permit with plat valid without expiration. Improvement Permit with site plan valid for sixty months. Authorization to Construct is valid for a period equal to that of Improvement Permit – not to exceed sixty months.

Signed: date 7-21-05 Installed by: L & L construction

Improvement Permit by: RS date 7/14/05 Operation Permit by: JR date 8/10/05

Authorization to Construct by: RS date 7/14/05 Existing System Inspection by: date

HEALTH DEPT. COPY: WHITE OWNER COPY (FINAL): YELLOW OWNER COPY (INITIAL): PINK