IREDELL COUNTY HEALTH DEPARTMENT

STATESVILLE 8-5305 / MOORESVILLE 704-664-5281

IMPROVEMENT PERMIT / AUTHORIZATION TO CONSTRUCT / OP ION PERMIT / EXISTING SYSTEM INSPECTION

130.00 Lic

PERMIT# 130557 PIN# 4677 80 4975 DATE 9/20/05

OWNER OR CONTRACTOR Jeff & April Fielder PHONE: Business _____ Home _____

ADDRESS 110 Springtown Dr. Lancaster PA 17601

LOCATION Hwy 15 & TR Teeter, TL Magnolia, TL Oakwood, 2nd on Lt.

SUBDIVISION Magnolia Ridge BLOCK / SECTION _____ LOT 3 LOT AREA 1.00 Ac SITE CLASS PS DESIGN FLOW 480 L.T.A.R. 0.3

Septic Tank: 1000 Gallons; STB 312 Date 11/15/06

Pump Tank: 1000 Gallons; PT 283 Date _____

Pump Make: Zoeller Model N 153 Serial No. _____

Nitrification Field: No Fields 1 Square Feet 1200 Linear Feet 400

No Lines 3@134' Trench Width 36" Max Trench Bottom Depth 36" Gravel Depth —

☒ New System ☐ Repair System Type: I, II, III, IV, V, VI

System Description: Pump 25% Reduction

Repair System Description: LP Panel Block

Maintenance Agreement Required: ☐ Yes ☒ No

☒ House/Mod. Home No. Bedrooms 4

☐ Mobile Home No. Bathrooms ____

☐ Business No. Employees ____

☐ Other _____

☐ Slab ☒ Crawl Space ☐ Basement w/plumbing ☐ Basement wo/plumbing


Water Supply: ☒ Individual ☐ Public ☐ Community

Comments:/Conditions:


1"=50'

Comments:/Conditions:

INITIAL SITE SKETCH

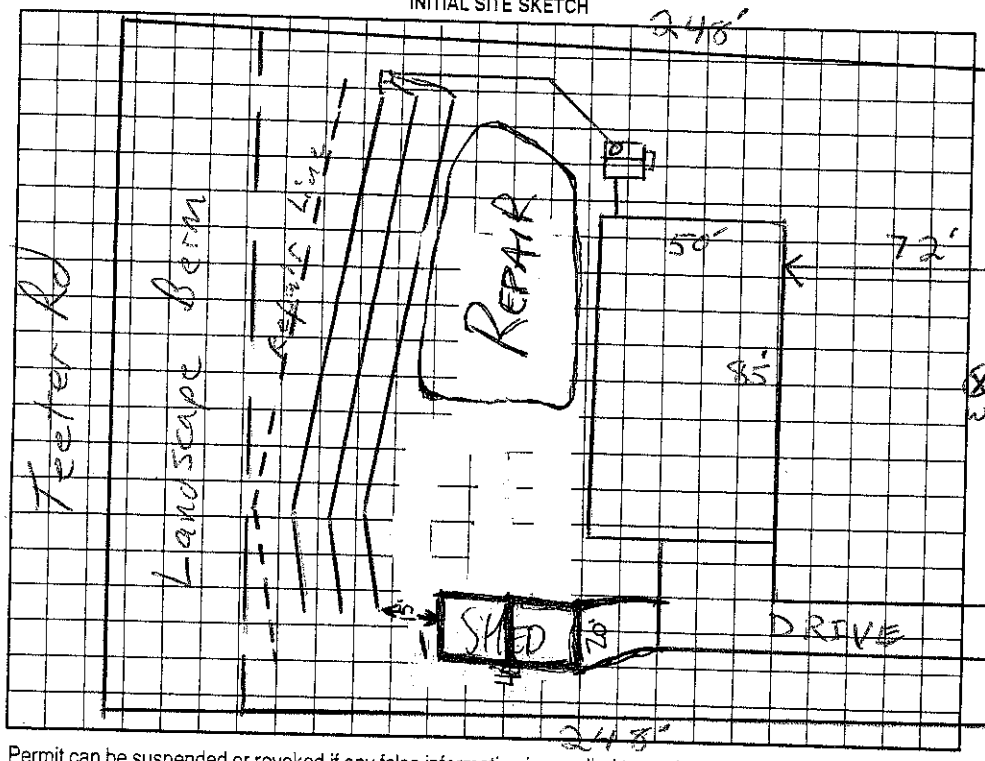

AS BUILT SKETCH

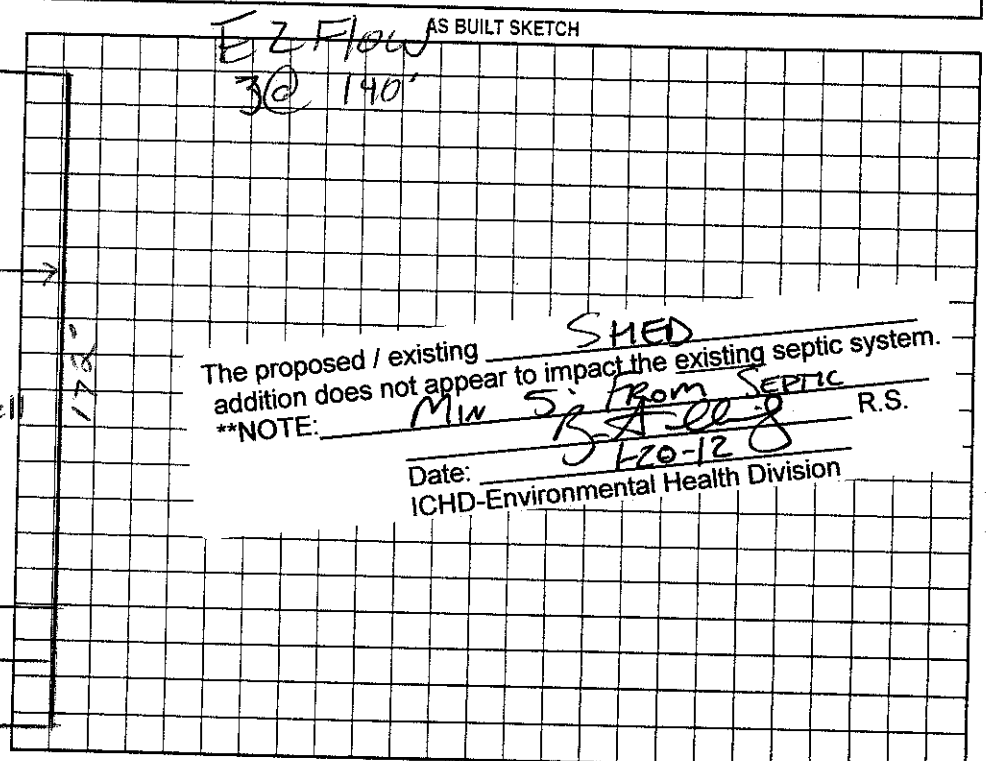

Permit can be suspended or revoked if any false information is supplied toward securing the permit/any unauthorized changes are made to the site/any unauthorized changes are made in the installation of the system. Improvement Permit with plat valid without expiration. Improvement Permit with site plan valid for sixty months. Authorization to Construct is valid for a period equal to that of Improvement Permit – not to exceed sixty months.

Signed: C. A. Corbett date 9/21/05 Installed by: Bass Grading

Improvement Permit by: _____ RS date 9/20/05 Operation Permit by: Wesley Sparks RS. date 4/20/06

Authorization to Construct by: _____ RS date 9/20/05 Existing System Inspection by: _____ date _____

HEALTH DEPT. COPY: WHITE OWNER COPY (FINAL): YELLOW OWNER COPY (INITIAL): PINK