ELL COUNTY HEALTH DEPARTMENT

STATESVILLE 704-878-5305 130.00 Paid MOORESVILLE 704-664-5281 10:30

IMPROVEMENT PERMIT / AUTHORIZATION TO CONSTRUCT / OPERATION PERMIT / EXISTING SYSTEM INSPECTION

PERMIT# 124188 PIN# 4677804683 Jordan or Jason DATE 10-20-04

OWNER OR CONTRACTOR America's Home Place PHONE: Business 664-5500 Home

ADDRESS 168-D Norman Station Blvd. Mooresville, NC 28117

LOCATION Hwy 152 TR Teeter Rd TL Magnolia Ridge TL Oakwood Meadow at end

SUBDIVISION Magnolia Ridge BLOCK / SECTION LOT 2 LOT AREA 1.0 Acre SITE CLASS PS DESIGN FLOW 480 L.T.A.R. .3

Gravity

Septic Tank: 1000 Gallons; STB 1007 Date 12-27-04
Pump Tank: ~~1000~~ Gallons; PT Date
Pump Make: Model Serial No.
Nitrification Field: No Fields 1 Square Feet 1200 Linear Feet 400'
No Lines 4@100' Trench Width 36" Max Trench Bottom Depth 20" Gravel Depth N/A


☒ New System ☐ Repair System Type: I, II, III, IV, V, VI
System Description: Pump Pm 25% Reduction
Repair System Description: Same
Maintenance Agreement Required: ☐ Yes ☒ No

☒ House/Mod. Home No. Bedrooms 4
☐ Mobile Home No. Bathrooms 3
☐ Business No. Employees
☐ Other
☐ Slab ☐ Crawl Space ☐ Basement w/plumbing ☐ Basement wo/plumbing

Water Supply:
☒ Individual
☐ Public
☐ Community

Comments:/Conditions:
Scale 1:50

INITIAL SITE SKETCH

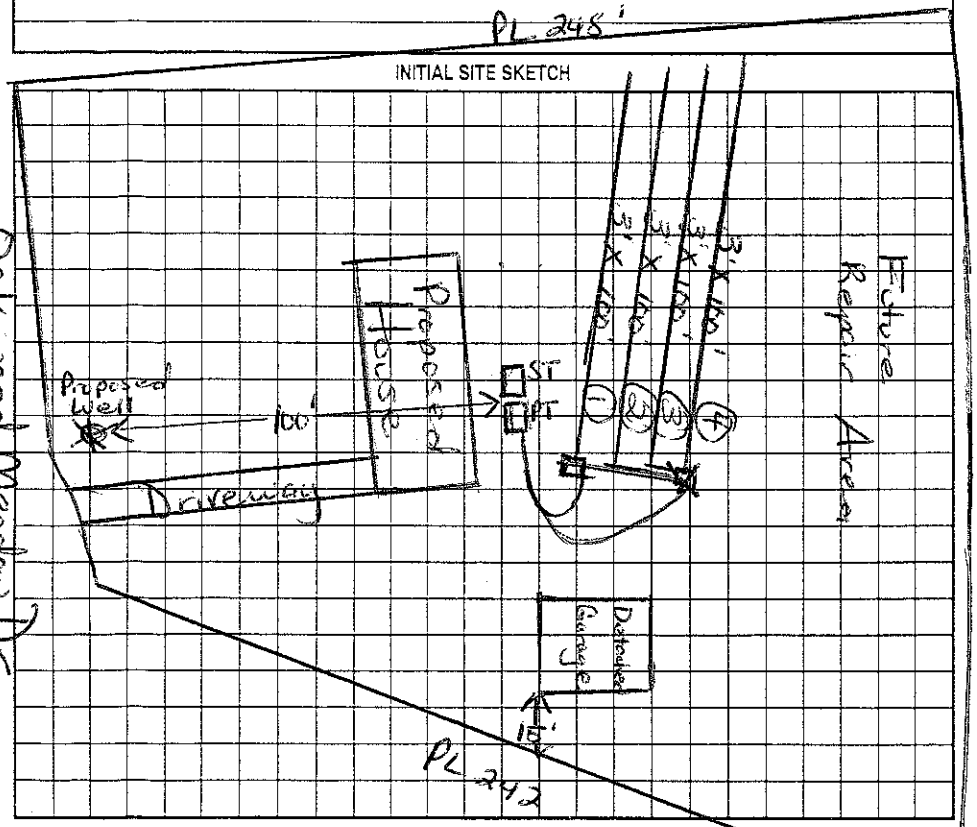

Comments:/Conditions: Keep Septic System 10' From PL @ 100' to well
Note: 100' From well to ST > 100' to Drainfield
Trench ~~Feet~~ (4) 36" to top of Chambers

AS BUILT SKETCH

Used 4-100' & Quick 4" Plastic Chambers For DrainField

Permit can be suspended or revoked if any false information is supplied toward securing the permit/any unauthorized changes are made to the site/any unauthorized changes are made in the installation of the system. Improvement Permit with plat valid without expiration. Improvement Permit with site plan valid for sixty months. Authorization to Construct is valid for a period equal to that of Improvement Permit – not to exceed sixty months.

Signed: Maurice McDonald date 10/22/04 Installed by: Tredell Beckhoe

Improvement Permit by: Maria H. Dobson R.S. date 10/21/04 Operation Permit by: Maria H. Dobson R.S. date 2/11/05

Authorization to Construct by: Maria H. Dobson R.S. date 10/21/04 Existing System Inspection by: date

HEALTH DEPT. COPY: WHITE OWNER COPY (FINAL): YELLOW OWNER COPY (INITIAL): PINK