IREDELL COUNTY HEALTH DEPARTMENT

Statesville Office (704) 878-5305 Mooresville Office (704) 660-3625 PERMIT # 211240

IMPROVEMENT PERMIT / AUTHORIZATION TO CONSTRUCT / OPERATION PERMIT / EXISTING SYSTEM

PIN # 4677-80-6933.000

APPLICANT: Kristy Coulter APPLICANT ADDRESS: 255 Teeter Rd Mooresville NC 28115

SITE ADDRESS: 255 Teeter Rd. Mooresville NC 28115 PHONE: 704-400-4529 ALT. PHONE:


SITE DIRECTIONS: Hwy 152 to Teeter Rd., ½ Mile, House on L

SUBDIVISION: — SECTION: — LOT # — LOT AREA: 1 Acre DESIGN FLOW: 240 GPD Est. L.T.A.R.: Existing

Septic Tank	1000	(gal)	STB	760	Date		☐ New System	☒ Repair	☐ Expansion	System Type: I	II	III	IV	V	VI	☒ Residence	No. Bedrooms Ex. 2	Water Supply
Pump Tank		(gal)	PT		Date		System Description: Existing Gravity Conventional									☐ Business	No. Persons Ex. 4	☒ Private
Pump Make		Model			Serial #		Repair System Description: Conventional (Existing)									☐ Other	No. Employees	☐ Public
# Nitrification Fields	Existing	# Lines	Existing		Linear Ft:	Existing	Maintenance Agreement Required: ☐ YES ☒ NO									☐ Slab	☒ Crawl Space	☐ Community
Trench Width	Existing	Max. Trench Bottom Depth	Existing		Gravel Depth	Existing	☒ GRAVITY ☐ PRESSURE									☐ Basement w/plumbing	☐ Basement w/o plumbing	


Comments / Conditions: Pump, Crush, And Fill Existing Tank. Set Bull Run Valve To Distribute To Both Lines. Maintain 50' Seperation From Well And 5' Seperation From House W/ New Tank.

INITIAL SITE SKETCH

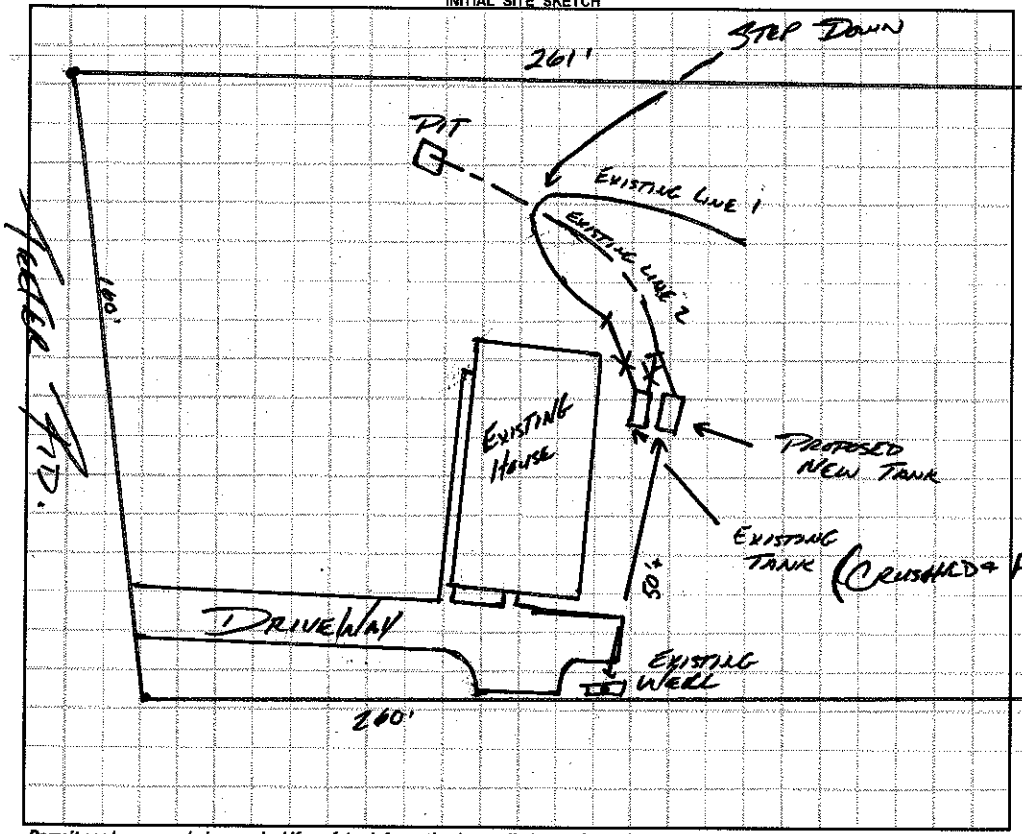

AS BUILT SKETCH

1" = 50'

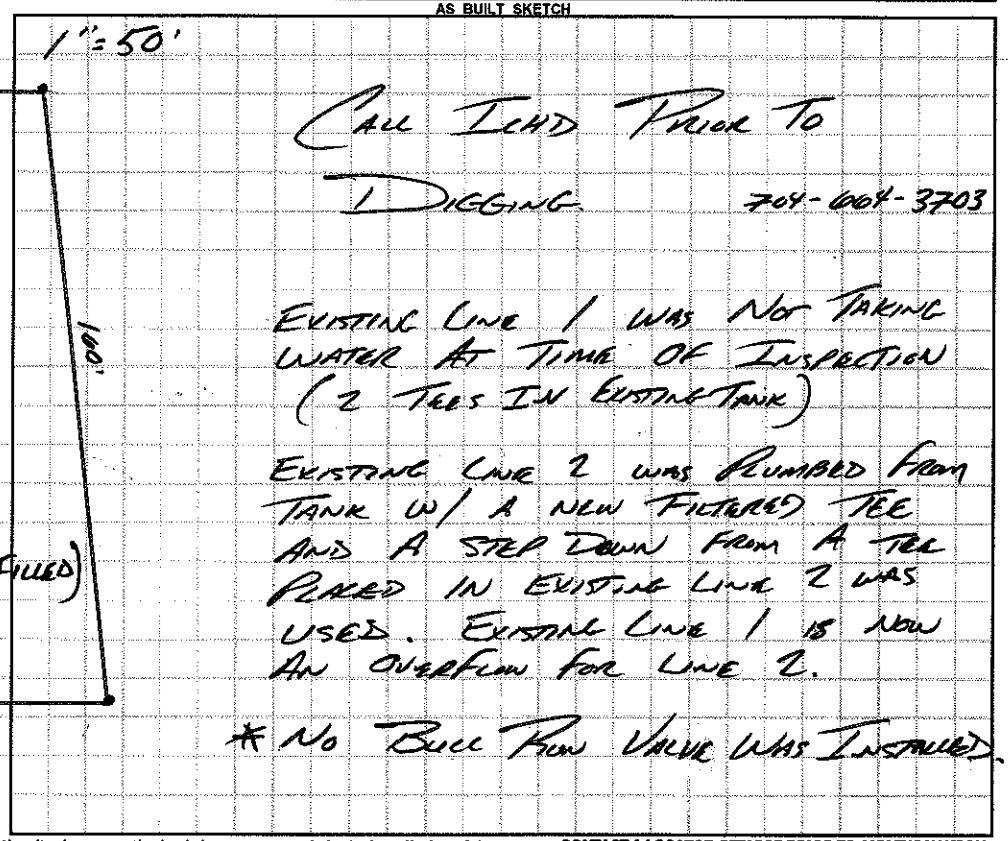

Call ICHD Prior To Digging 704-664-3703

Existing Line 1 was not taking water at time of inspection (2 tees in existing tank)

Existing Line 2 was plumbed from tank w/ a new filtered tee and a step down from a tee placed in existing line 2 was used. Existing Line 1 is now an overflow for Line 2.

* No Bull Run Valve was installed.

Permit can be suspended or revoked if any false information is supplied toward securing the permit / any unauthorized changes are made to the site / any unauthorized changes are made in the installation of the system. **CONTACT A LOCATOR SERVICE PRIOR TO ANY EXCAVATION**

☐ **IMPROVEMENT PERMIT** *with plat valid without expiration.* ☒ **IMPROVEMENT PERMIT** *with site plan valid for 60 mos.* ☒ **AUTHORIZATION TO CONSTRUCT** *valid for period equal to IMPROVEMENT PERMIT--not to exceed 60 mo.*

Owner / Applicant Signature: Date: 7/17/15 Installed by: Randy Melton (Piedmont)

IMPROVEMENT PERMIT by: APPROVED Date: JUL 17 2015 OPERATION PERMIT by: APPROVED AUG 12 2015

AUTHORIZATION TO CONSTRUCT by: APPROVED Date: JUL 17 2015 Existing System Inspected by: Date:

Health Dept. Copy - WHITE Applicant (Final Approval) - YELLOW Applicant (Conditional Approval) - PINK