IREDELL COUNTY HEALTH DEPARTMENT

Statesville Office (704) 878-5305 Mooresville Office (704) 660-3625 PERMIT # 221604

BA

IMPROVEMENT PERMIT / AUTHORIZATION TO CONSTRUCT / OPERATION PERMIT / EXISTING SYSTEM

PIN # 4677818377

APPLICANT: Fred Leazer APPLICANT ADDRESS: 239 Tester Rd Mooresville NC

SITE ADDRESS: 229 Tester Rd Mooresville, NC PHONE: ALT. PHONE: 704663-3763

SITE DIRECTIONS: Hwy 152 TR Tester Rd property 1/2 mile on left

SUBDIVISION: N/A SECTION: LOT #: LOT AREA: 1.086 Acre DESIGN FLOW: 360gpd L.T.A.R.: .3

Septic Tank 1000 (gal) STB 1012 Date 7/5/16
Pump Tank (gal) PT Date
Pump Make Model Serial #
Nitrification Fields 1 # Lines 3 Linear Ft: 300'
Trench Width 36" Max. Trench Bottom Depth 24" Gravel Depth N/A


☒ New System ☐ Repair ☐ Expansion System Type: I II ☒ III IV V VI
System Description: Gravity-25% Reduction
Repair System Description: Same
Maintenance Agreement Required: ☐ YES ☒ NO
☒ GRAVITY ☐ PRESSURE

☒ Residence ☐ Business ☐ Other ☐ Slab ☐ Basement w/plumbing
No. Bedrooms 3 No. Persons 6 No. Employees Crawl Space
☐ Basement w/o plumbing


Water Supply: ☒ Private ☐ Public ☐ Community

Comments / Conditions:

INITIAL SITE SKETCH

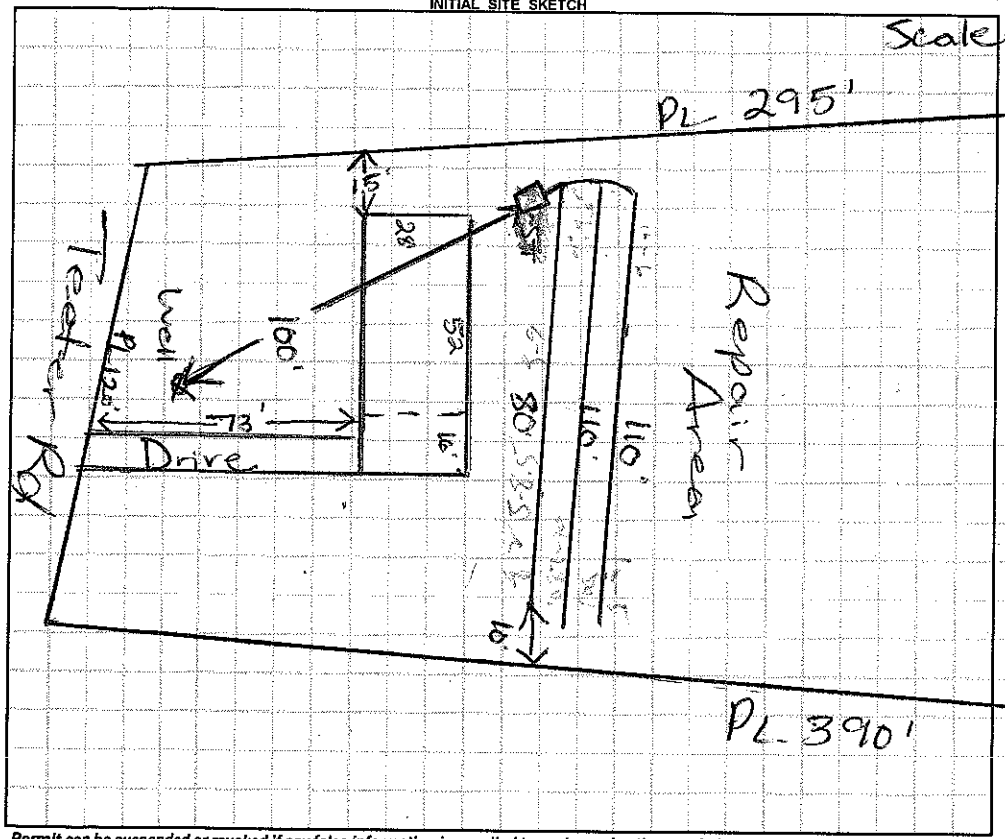

AS BUILT SKETCH

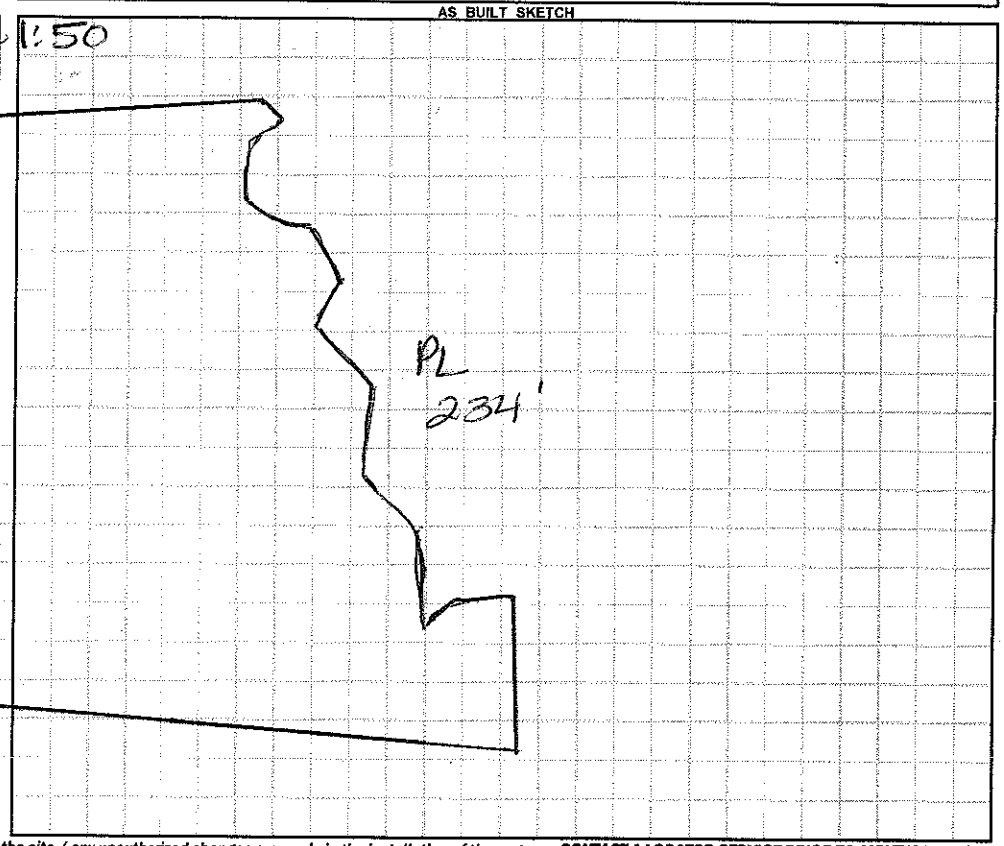

Permit can be suspended or revoked if any false information is supplied toward securing the permit / any unauthorized changes are made to the site / any unauthorized changes are made in the installation of the system. **CONTACT A LOCATOR SERVICE PRIOR TO ANY EXCAVATION**

☐ **IMPROVEMENT PERMIT** *with plat valid without expiration.* ☐ **IMPROVEMENT PERMIT** *with site plan valid for 60 mos.* ☒ **AUTHORIZATION TO CONSTRUCT** *valid for period equal to IMPROVEMENT PERMIT--not to exceed 60 mo.*

Owner / Applicant Signature: Angela McConnell Date: 10/17/16 Installed by: Craig Thompson

IMPROVEMENT PERMIT by: Maria Lotter RS Date: 10/14/16 OPERATION PERMIT by: W L Sparks Date: 11/2/16

AUTHORIZATION TO CONSTRUCT by: Maria Lotter RS Date: 10/14/16 Existing System Inspected by: Date:

Health Dept. Copy - WHITE Applicant (Final Approval) - YELLOW Applicant (Conditional Approval) - PINK