IREDELL COUNTY HEALTH DEPARTMENT

STATESVILLE 704-878-5305 MOORESVILLE 704-664-5281

IMPROVEMENT PERMIT / AUTHORIZATION TO CONSTRUCT / OPERATION PERMIT / EXISTING SYSTEM INSPECTION

PERMIT# 120507 PIN# ~~4677-88-6374~~ DATE 4/13/04

OWNER OR CONTRACTOR Susan Patterson PHONE: Business 704-663-4276 Home 4677-88-5747

ADDRESS 125 London Rd, Mooresville, NC. 28115

LOCATION 150 E TR LONDON RD, + 3RD driveway on (L)

SUBDIVISION POWERS ESTATES BLOCK / SECTION ____ LOT 12 LOT AREA EXISTING SITE CLASS. PS DESIGN FLOW 480 L.T.A.R. .3

Septic Tank: EXISTING Gallons; STB ____ Date ____

Pump Tank: ____ Gallons; PT ____ Date ____

Pump Make: ____ Model ____ Serial No. ____

Nitrification Field: No Fields 1 Square Feet 1200 Linear Feet 400

No Lines 5@80' Trench Width 3' Max Trench Bottom Depth 30" Gravel Depth No

☐ New System ☒ Repair System Type: I, II, (III), IV, V, VI

System Description: ____

Repair System Description: Type 3 - Dist Box

Maintenance Agreement Required: ☐ Yes ☒ No

☒ House/Mod. Home No. Bedrooms 4

☐ Mobile Home No. Bathrooms 2

☐ Business No. Employees ____

☐ Other ____


☐ Slab ☒ Crawl Space ☐ Basement w/plumbing ☐ Basement wo/plumbing

Water Supply: ☒ Individual ☐ Public ☐ Community

Comments:/Conditions: WELL

Comments:/Conditions: EZ Flow installed.

INITIAL SITE SKETCH

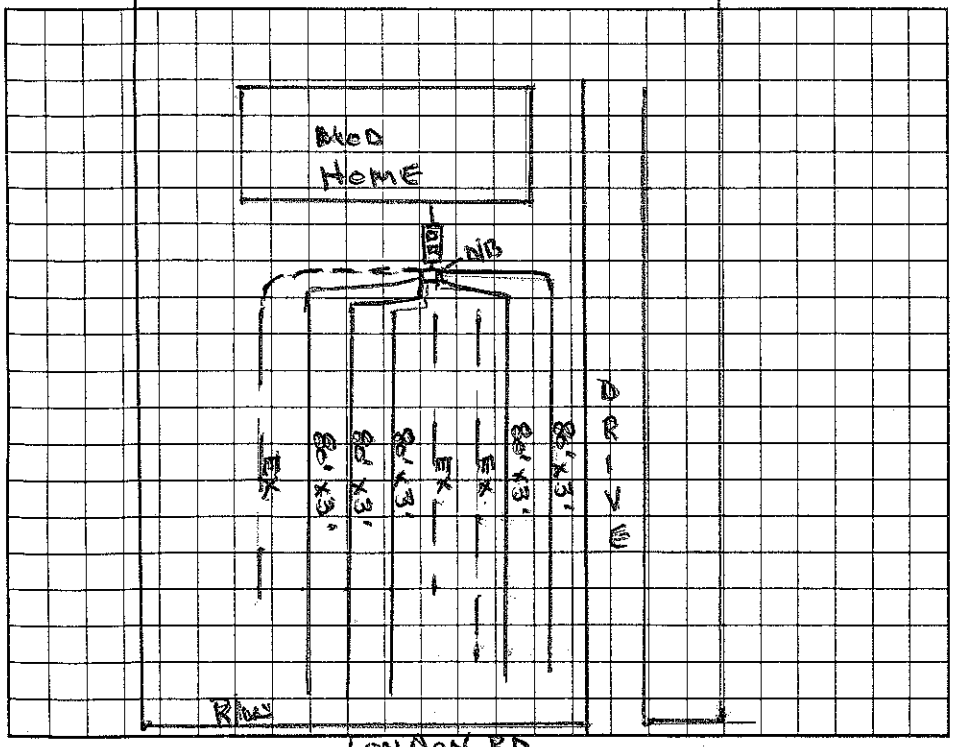

AS BUILT SKETCH

Permit can be suspended or revoked if any false information is supplied toward securing the permit/any unauthorized changes are made to the site/any unauthorized changes are made in the installation of the system. Improvement Permit with plat valid without expiration. Improvement Permit with site plan valid for sixty months. Authorization to Construct is valid for a period equal to that of Improvement Permit – not to exceed sixty months.

Signed: [signature] date 4/16/04

Improvement Permit by: Wesley Sparks RS. date 4/13/04

Authorization to Construct by: Wesley Sparks RS date 4/13/04

Installed by: Craig Thompson

Operation Permit by: Wesley Sparks RS. date 4/30/04

Existing System Inspection by: ____ date ____

HEALTH DEPT. COPY: WHITE OWNER COPY (FINAL): YELLOW OWNER COPY (INITIAL): PINK