# IREDELL COUNTY HEALTH DEPARTMENT

Owes

STATESVILLE 704-878-5305 MOORESVILLE 704-664-5281

## IMPROVEMENT PERMIT / AUTHORIZATION TO CONSTRUCT / OPERATION PERMIT / EXISTING SYSTEM INSPECTION

PERMIT# 151843 PIN# 4677890750.000

OWNER OR APPLICANT CMH Homes, Inc. DATE 8/12/08

ADDRESS PO Box 9790 Maryville TN, 37801 PHONE: Business (865) 380-3000 Home

LOCATION Hwy 150 past Hwy 152 less than a mile on Left 1521 Oakridge Farm Hwy

SUBDIVISION Power's Estate BLOCK / SECTION LOT 4 LOT AREA .99ac SITE CLASS. PS DESIGN FLOW 480 L.T.A.R. .25

Septic Tank: Exs 1000 Gallons; STB Date

Pump Tank: Gallons; PT Date

Pump Make Model Serial No.

Nitrification Field. No Fields 1 Square Feet 1440 Linear Feet 480'

No Lines 5 Trench Width 36" Max Trench Bottom Depth 18"* Gravel Depth ☐ Gravity ☐ Pressure

☑ New System ☐ Repair ☐ Expansion System Type: I (II) III IV V VI

System Description: Gravity 25% Reduction

Repair System Description: ~~Early PM~~ 25% Reduction

Maintenance Agreement Required: ☐ Yes ☑ No (Exs drain field)

☑ House/Mod. Home ☐ Mobile Home ☐ Business ☐ Other

No. Bedrooms 4 No. Persons No. Employees


Water Supply: ☑ Individual ☐ Public ☐ Community

☐ Slab ☑ Crawl Space ☐ Basement w/plumbing ☐ Basement wo/plumbing


Comments/Conditions: Disconnect Exs drainfield (To be used as repair) Connect to ~~DB~~ Drop Box or use other approved method of Serial Distribution.

Comments/Conditions: * Have Exs Septic Tank pumped ~~and install an approved outlet filter b/4 connecting to drainfield.~~ OK to use Exs Tank built in Toutlet

INITIAL SITE SKETCH

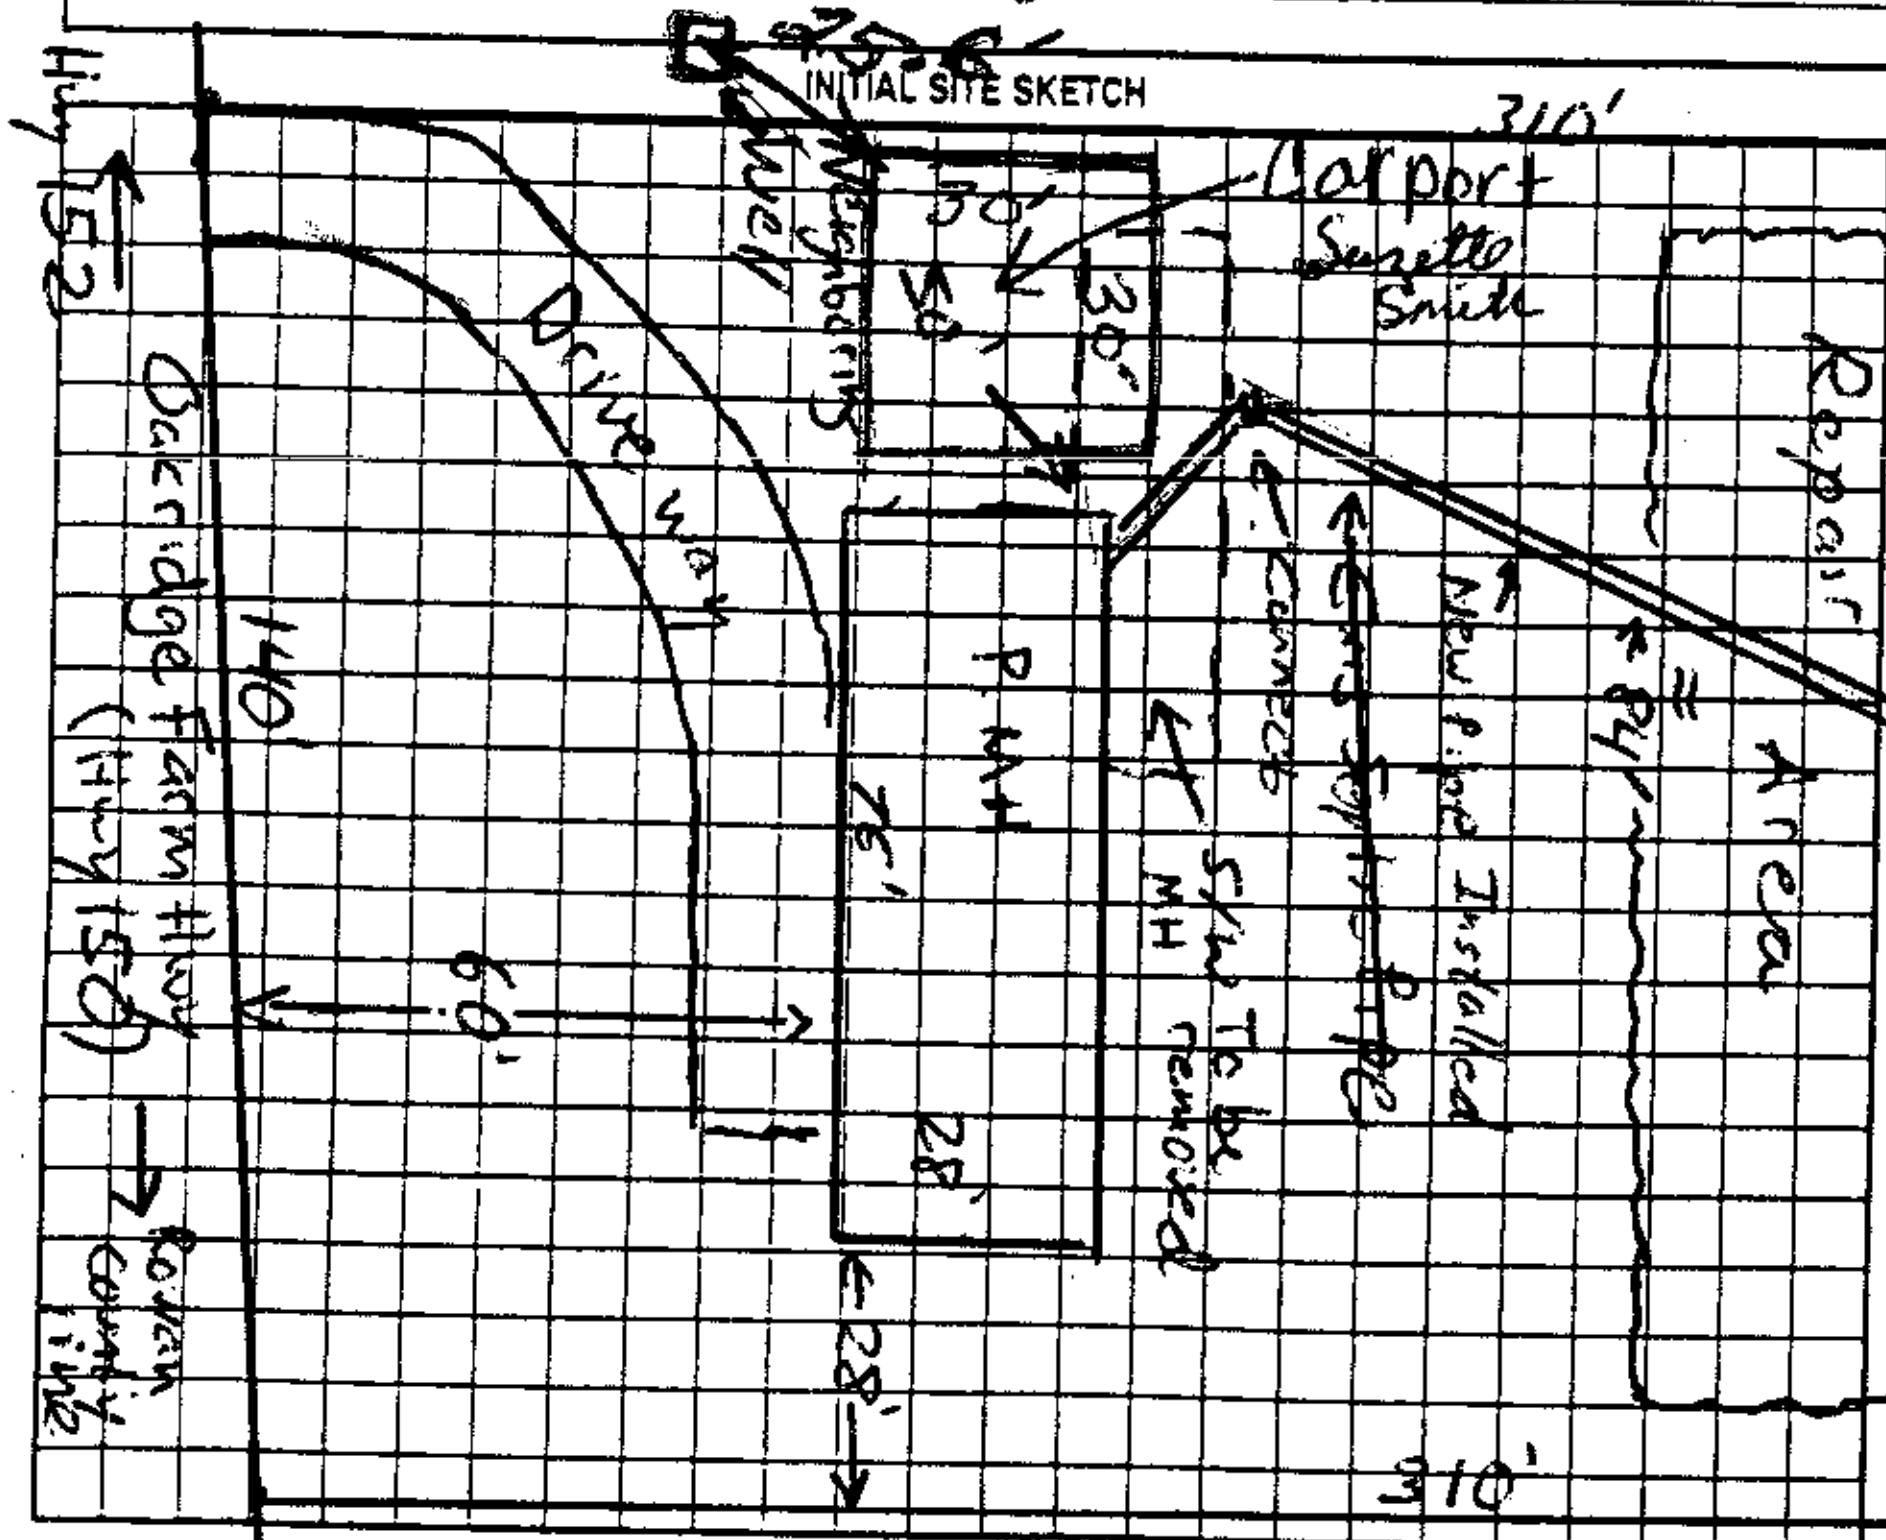


AS BUILT SKETCH

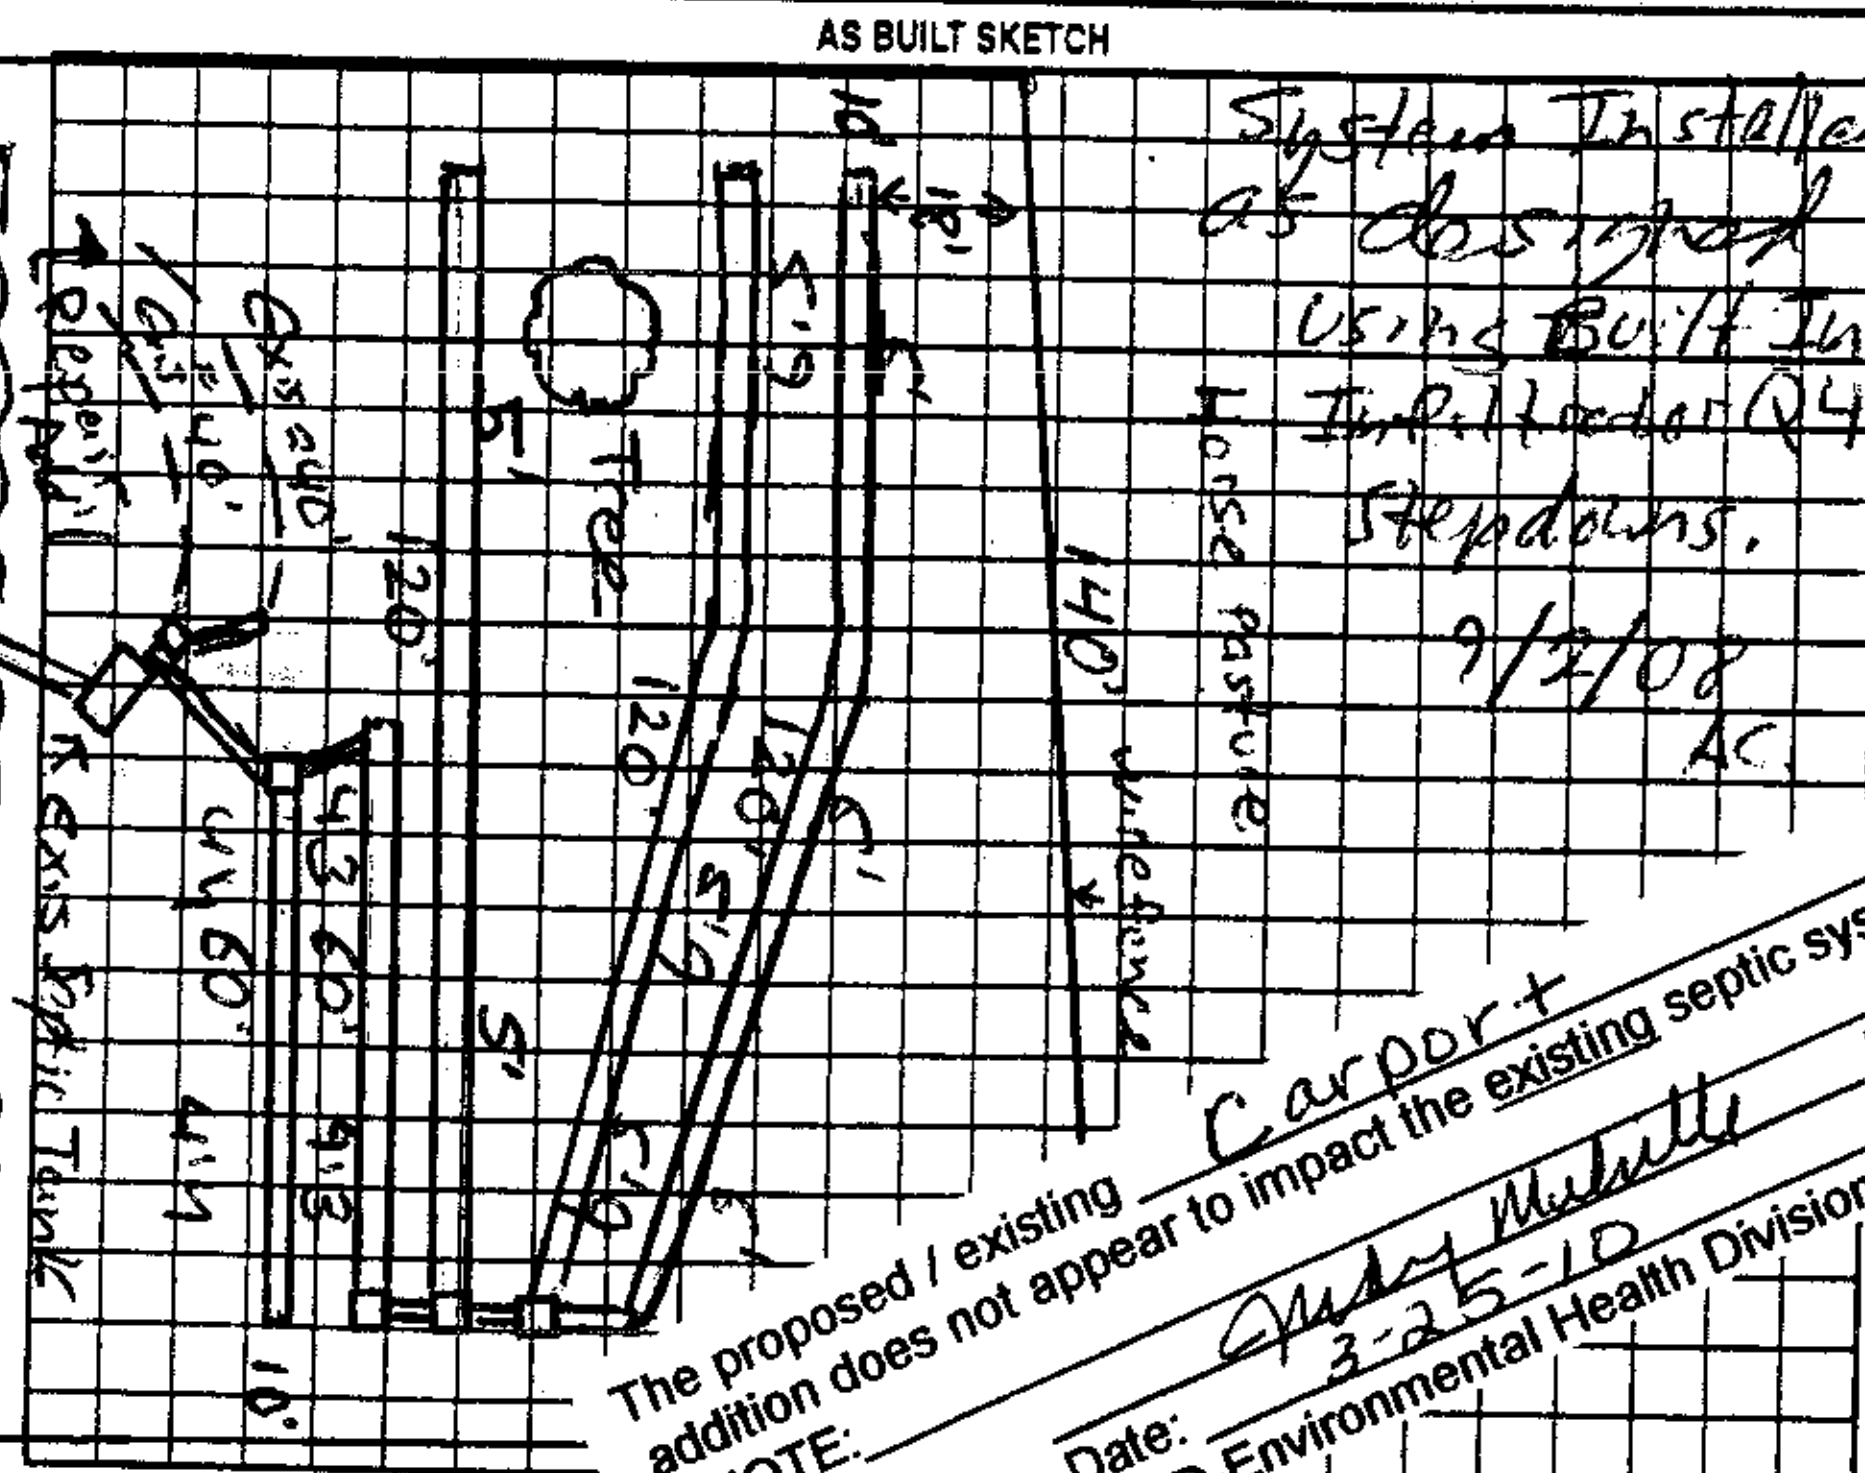


**NOTE: The proposed / existing Carport + addition does not appear to impact the existing septic system.

Judy Mitchell REHS

Date: 3-25-10

ICHD-Environmental Health Division

Permit can be suspended or revoked if any false information is supplied toward securing the permit/any unauthorized changes are made to the site/any una... the installation of the system. Improvement

Permit with plat valid without expiration ☐ Improvement Permit with site plan valid for sixty months ☑ Authorization to Construct is valid for a ... Improvement Permit – not to exceed sixty months.

Signed: [signature] date 8-13-08 Installed by:

Improvement Permit by: Anthony Coles Jr R.S. date 8/12/08 Operation Permit by: Anthony Coles Jr R.S. date 9/2/08

Authorization to Construct by: Anthony Coles Jr. R.S. date 8/13/08 Existing System Inspection by: date

HEALTH DEPT. COPY: WHITE OWNER COPY (FINAL): YELLOW OWNER COPY (INITIAL): PINK