IREDELL COUNTY HEALTH DEPARTMENT

STATESVILLE 704-878-5305 MOORESVILLE 704-664-5281

IMPROVEMENT PERMIT / AUTHORIZATION TO CONSTRUCT / OPERATION PERMIT / EXISTING SYSTEM INSPECTION

PERMIT # REPAIR PIN # 4677-89-0855 DATE 4-13-11

OWNER or APPLICANT RALPH GRAHAM / WAYNE ERVIN PHONE: Business 704-663-9734 Home:

OWNER or APPLICANT ADDRESS

LOCATION / DIRECTIONS 1527 OAKRIDGE HWY

SUBDIVISION POWERS ESTATES BLOCK / SECTION LOT # 3 LOT AREA .99AC DESIGN FLOW 360 L.T.A.R. .35

Septic Tank EX.1000 Gallons: STB Date

Pump Tank Gallons: P T Date

Pump Make Model Serial #

Nitrification Field No Fields 1 No Lines Linear Feet 20X66 RED

Trench Width 20' Max. Trench Bottom Depth Gravel Depth 12"

☐ New System ☒ Repair ☐ Expansion System Type I (II) III IV V VI

System Description:

Repair System Description: GRAVEL BED

Maintenance Agreement Required ☐ YES ☒ NO

☒ GRAVITY ☐ PRESSURE


☒ Residence No. Bedrooms 3 ☐ Business No. Persons ☐ Other No. Employees ☐ Slab ☒ Crawl Space ☐ Basement w/plumbing ☐ Basement w/o plumbing

Water Supply: ☒ Private ☐ Public ☐ Community


Comments / Conditions

Comments / Conditions CALL BEN ALDRIDGE W/ QUESTIONS 704-6660-3632

INITIAL SITE SKETCH

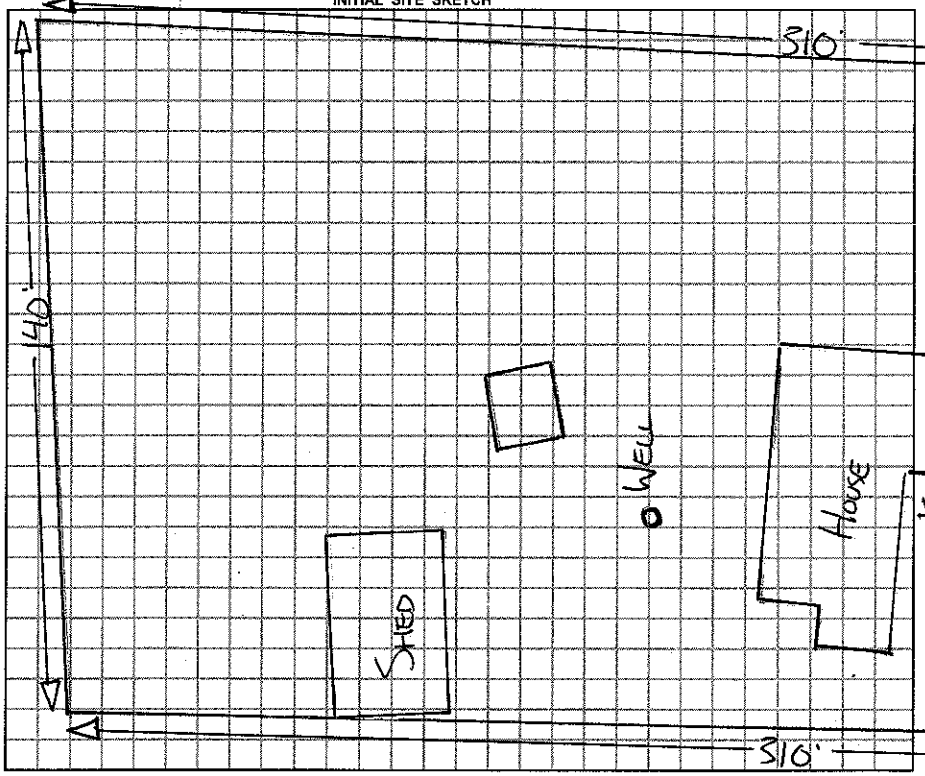

AS BUILT SKETCH

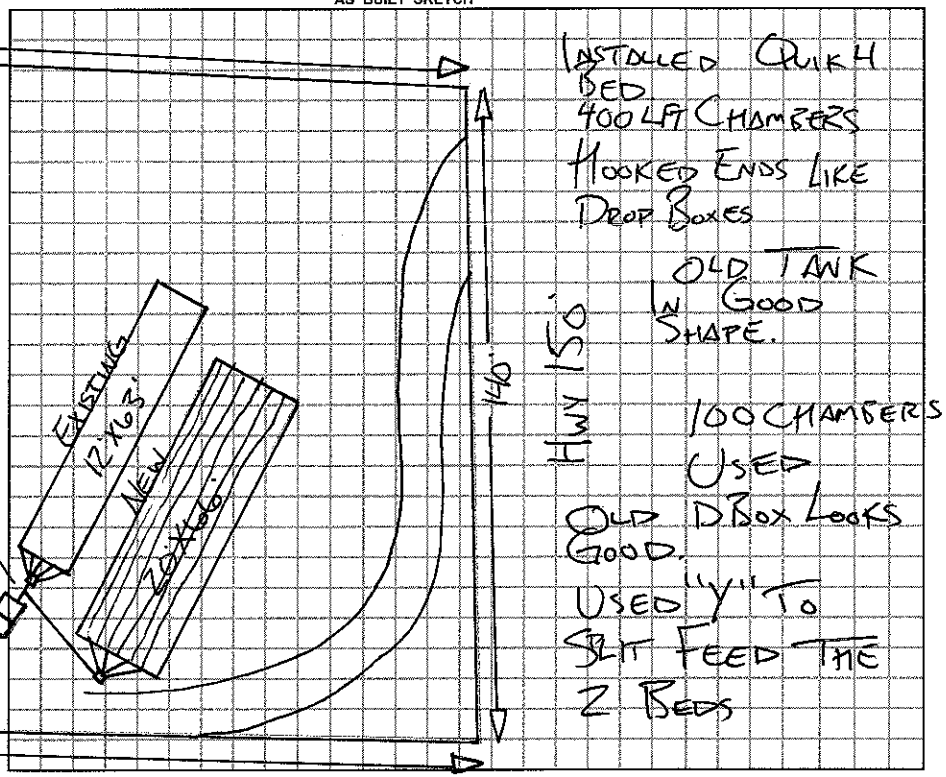

Permit can be suspended or revoked if any false information is supplied toward securing the permit / any unauthorized changes are made to the site / any unauthorized changes are made in the installation of the system.

☐ *IMPROVEMENT PERMIT w / plat valid without expiration.* ☐ *IMPROVEMENT PERMIT w / site plan valid for 60 mos.* ☐ *AUTHORIZATION TO CONSTRUCT valid for period equal to IMPROVEMENT PERMIT-not to exceed 60 mo.*

Owner / Applicant Signature: Wayne Ervin Date 4-14-11

Improvement Permit by: R. A. Reis Date 4-13-11

Authorzation to Construct by: R. A. Reis Date 4-13-11

YOU SHOULD CONTACT A LOCATOR SERVICE PRIOR TO ANY EXCAVATION.

Installed by: ROWAN SEPTIC

Operation Permit by: R. A. Reis Date: 4-26-11

Existing System Inspected by: Date:

WHITE COPY Environmental Health YELLOW COPY (Final) Owner / Applicant PINK COPY (Initial) Owner / Applicant