IREDELL COUNTY HEALTH DEPARTMENT

AUTHORIZATION TO CONSTRUCT

STATESVILLE 704-878-5305 MOORESVILLE 704-664-5281

IMPROVEMENT PERMIT / CERTIFICATE OF COMPLETION / OPERATION PERMIT / EXISTING SYSTEM INSPECTION

PROPERTY DESCRIPTION NO. 068 255 DATE 7/23/97 TAX MAP NO. 4617893997 Watershed: ☑ Yes ☐ No

OWNER OR CONTRACTOR TERESA GRIFFIN PHONE: Business Home 663-5873

ADDRESS 377 SHARPE ST MOORESVILLE NC 28115 4617-89-3908

LOCATION 150E - 2nd LOT ON RT PAST ASHCRAFT

SUBDIVISION POWERS EST BLOCK / SECTION LOT 15 LOT AREA - SITE CLASS. A5 DESIGN FLOW 360.00 L.T.A.R. .3

Septic Tank: 1000 Gallons; STB 160 Date 10/31/97

Pump Tank: Gallons; PT Date

Pump Make: Model Serial No.

Nitrification Field: No Fields 1 Square Feet 1200 Linear Feet 400

No Lines 4 @ 100' Trench Width 36" Max Trench Bottom Depth 18" Gravel Depth 12"

☑ New System ☐ Repair System Type: I, II, III, IV, V, VI

System Description: GRAVITY CONVENTIONAL

Repair System Description: SAME

Maintenance Agreement Required: ☐ Yes ☑ No

☐ House/Mod. Home No. Bedrooms 3

☑ Mobile Home No. Bathrooms 3

☐ Business No. Employees

☐ Other

☐ Slab ☑ Crawl Space ☐ Basement w/plumbing ☐ Basement wo/plumbing


Water Supply: ☑ Individual ☐ Community ☐ Public

Comments:


* APPROVED FOR DROP BOXES 1/2/97 CF

Comments:

INITIAL SITE SKETCH

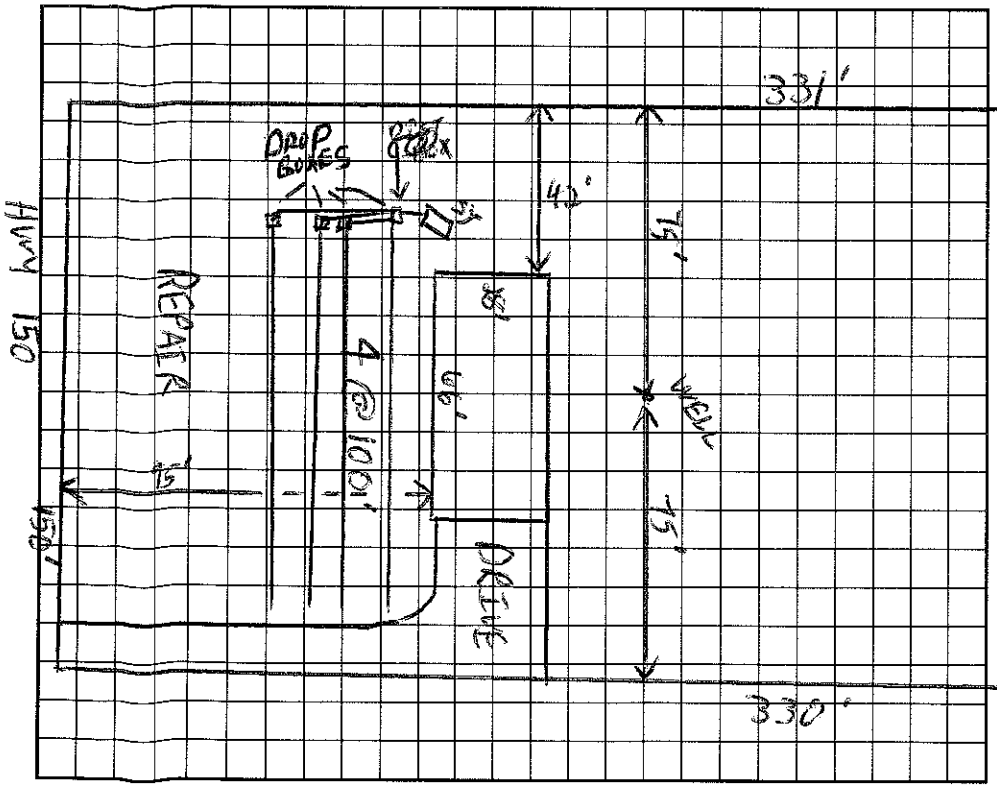

AS BUILT SKETCH

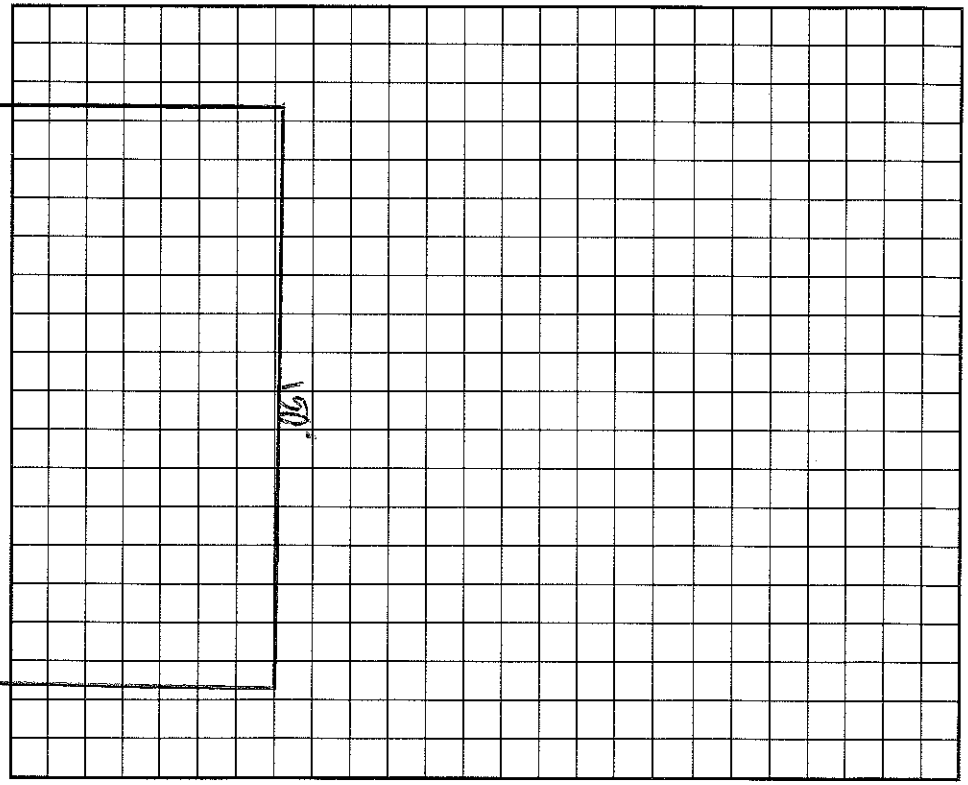

I understand that this permit can be suspended or revoked if any false information is supplied toward securing the permit/any unauthorized changes are made to the site/any unauthorized changes are made in the installation of the system. Improvement Permit is valid for 60 months from date of issuance.

Signed Teresa Griffin

Improvement Permit by: C. Kelly Teem date 7/23/97

AUTHORIZATION TO CONSTRUCT

Existing System Inspection by: C. Kelly Teem date 7/23/97

Installed by: TWEED GRADING

Certificate of Completion by: date

Operation Permit by: C. Kelly Teem date 2/24/98

HEALTH DEPT. COPY: WHITE INSPECTION COPY (FINAL): GREEN OWNER COPY (FINAL): YELLOW INSPECTION COPY (INITIAL): PINK OWNER COPY (INITIAL): GOLD