IREDELL COUNTY HEALTH DEPARTMENT

STATESVILLE 704-878-5305 MOORESVILLE 704-664-5281

IMPROVEMENT PERMIT / AUTHORIZATION TO CONSTRUCT / OPERATION PERMIT / EXISTING SYSTEM INSPECTION

PERMIT# 95508 PIN# 4677 91 67 99 DATE 5/23/01

OWNER OR CONTRACTOR Ryan Powers PHONE: Business _____ Home 662 8304

ADDRESS 310 Dodge DR. Mooresville NC 28115

LOCATION 152 E, past Tecter Rd on Rt Dodge Dr.

SUBDIVISION _____ BLOCK / SECTION _____ LOT _____ LOT AREA 5.6 AC SITE CLASS. PS DESIGN FLOW 360 L.T.A.R. .03

Septic Tank: 1000 Gallons; STB 1072 Date 4/28/01
Pump Tank: _____ Gallons; PT _____ Date _____
Pump Make: _____ Model _____ Serial No. _____
Nitrification Field: No Fields 1 Square Feet 1200 Linear Feet 400
No Lines 3@133' Trench Width 36" Max Trench Bottom Depth 36" Gravel Depth 12"

☒ New System ☐ Repair System Type: I II III IV V VI
System Description: Gravity Conv.
Repair System Description: Same
Maintenance Agreement Required: ☐ Yes ☒ No

☐ House/Mod. Home No. Bedrooms 3
☒ Mobile Home No. Bathrooms 2
☐ Business No. Employees ____
☐ Other _____

☐ Slab ☒ Crawl Space ☐ Basement w/plumbing ☐ Basement wo/plumbing


Water Supply: ☒ Individual ☐ Public ☐ Community

Comments:/Conditions: Install Lines on Contour - Keep well 50' minimum from septic system

Comments:/Conditions:

Not to scale

INITIAL SITE SKETCH

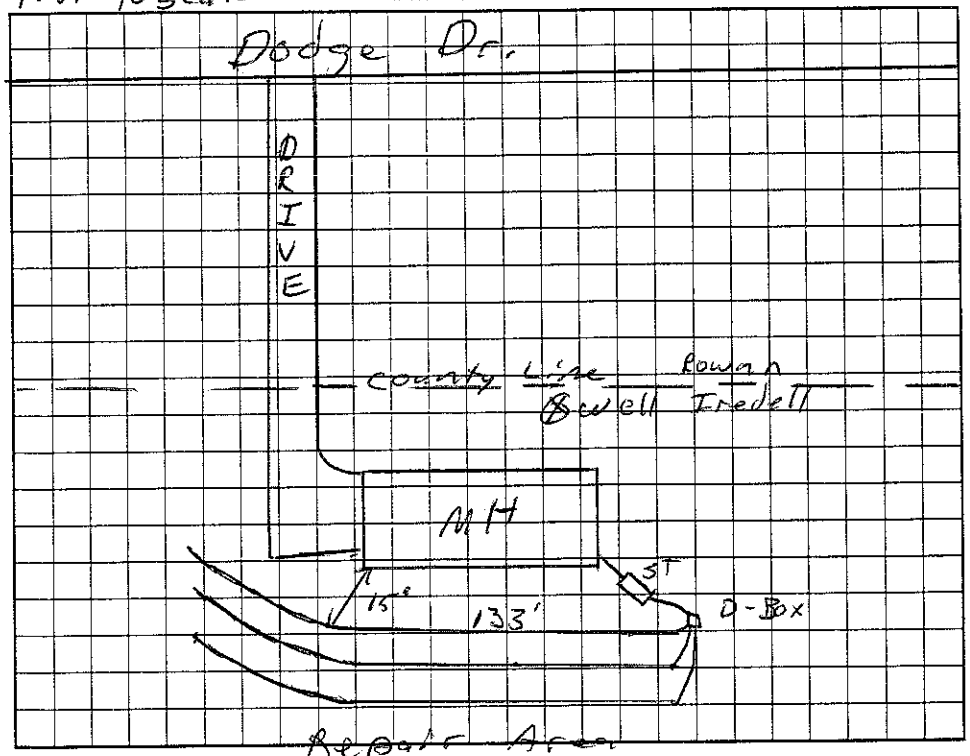

AS BUILT SKETCH

Permit can be suspended or revoked if any false information is supplied toward securing the permit/any unauthorized changes are made to the site/any unauthorized changes are made in the installation of the system. Improvement Permit with plat valid without expiration. Improvement Permit with site plan valid for sixty months. Authorization to Construct is valid for a period equal to that of Improvement Permit – not to exceed sixty months.

Signed: Andy Dalton date _____

Improvement Permit by: _____ RSI date 5/23/01

Authorization to Construct by: _____ RSI date 5/23/01

Installed by: A1 Backhoe

Operation Permit by: _____ RSI date 7/20/01

Existing System Inspection by: _____ date _____

HEALTH DEPT. COPY: WHITE OWNER COPY (FINAL): YELLOW OWNER COPY (INITIAL): PINK