Repair 11:50

IREDELL COUNTY HEALTH DEPARTMENT

STATESVILLE 704-878-5305 MOORESVILLE 704-664-5281

IMPROVEMENT PERMIT / AUTHORIZATION TO CONSTRUCT / OPERATION PERMIT / EXISTING SYSTEM INSPECTION

PERMIT # N/A PIN # 4678003398 DATE 12-12-08

OWNER or APPLICANT Don West PHONE: Business Home:

OWNER or APPLICANT ADDRESS 1037 Oakridge Hwy Mooresville, NC

LOCATION / DIRECTIONS Main St TL Hwy 801 TR Hwy 150 (East) on left #1037 btw Cherry Grove ent.

SUBDIVISION BLOCK / SECTION LOT # LOT AREA DESIGN FLOW 360 gpd L.T.A.R. .35+

Repair

Septic Tank 1000 Gallons: STB 312 Date 8-27-08

Pump Tank Gallons: P T Date

Pump Make Model Serial #

Nitrification Field No Fields 1 No Lines 3 Linear Feet 240'

Trench Width 36" Max. Trench Bottom Depth 36"+ Gravel Depth N/A

☐ New System ☒ Repair ☐ Expansion System Type I II III IV V VI

System Description: AS Gravity Conventional

Repair System Description Gravity 25% Reduction

Maintenance Agreement Required ☐ YES ☒ NO

☒ GRAVITY ☐ PRESSURE


☒ Residence No. Bedrooms 3 ☐ Business No. Persons ☐ Other No. Employees ☐ Slab ☐ Crawl Space ☐ Basement w/plumbing ☐ Basement w/o plumbing

Water Supply ☒ Private ☐ Public ☐ Community


Comments / Conditions * Replace existing Septic Tank with new ST in same location if possible

Comments / Conditions 12/15/08 Checked ST 30 @ 80' Quick 4 lines installed

INITIAL SITE SKETCH

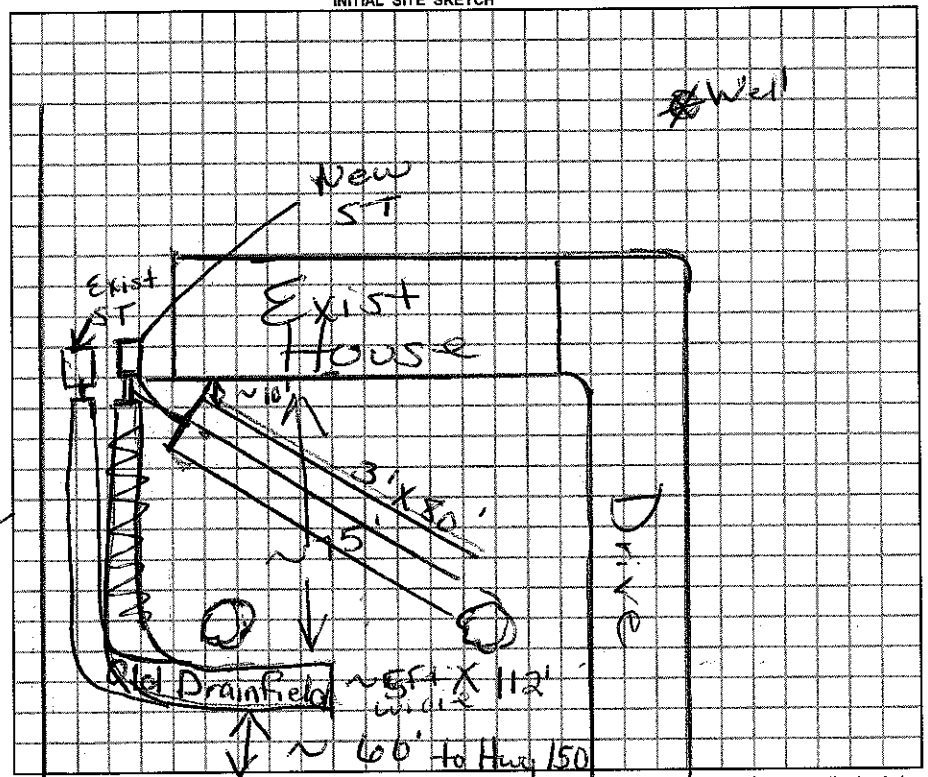

AS BUILT SKETCH

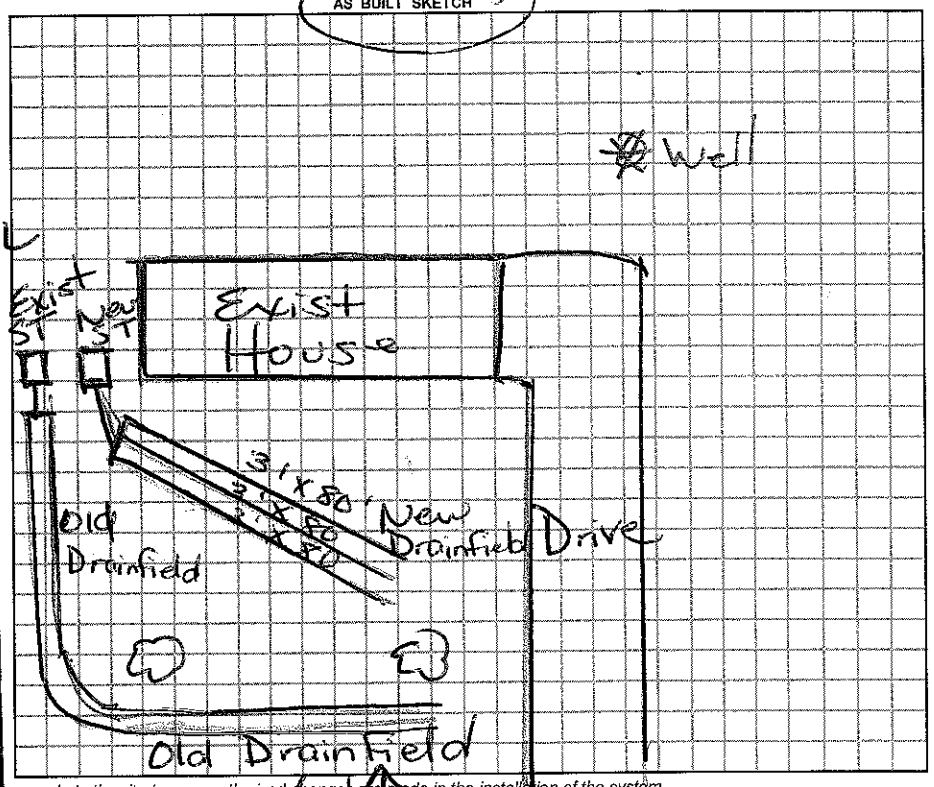

Permit can be suspended or revoked if any false information is supplied toward securing the permit / any unauthorized changes are made to the site / any unauthorized changes are made in the installation of the system.

☐ IMPROVEMENT PERMIT w / plat valid without expiration. ☐ IMPROVEMENT PERMIT w / site plan valid for 60 mos. ☐ AUTHORIZATION TO CONSTRUCT valid on period equal to IMPROVEMENT PERMIT-not to exceed 60 mo.

Owner / Applicant Signature: Donald West Date

Improvement Permit by: Marion H Dotson RS Date 12/12/08

Authorization to Construct by: Marion H Dotson RS Date 12/12/08

Installed by: Larry Beam Grading

Operation Permit by: Marion H Dotson RS Date 12/16/08

Existing System Inspected by: Date:

YOU SHOULD CONTACT A LOCATOR SERVICE PRIOR TO ANY EXCAVATION.

WHITE COPY Environmental Health YELLOW COPY (Final) Owner / Applicant PINK COPY (Initial) Owner / Applicant