IREDELL COUNTY HEALTH DEPARTMENT

Statesville Phone TR 3-7271 Mooresville Phone NO 3-1271

PERMIT TO INSTALL SEPTIC TANK

Permit No. _____ Permit Date 15 Aug 1965

Owner Donald West Address Mooresville N.C.

Installed By Smith & Blanton Address Clint Grove N.C.


Location of Property 156 By-Pass

Tank		Capacity		Length of Lines		Fixtures	
Block	( )	1000	( )	225'	( )	No. of Baths	( )
Precast	(✓)	1250	( )	250'	(✓)	Dishwasher	( )
		1500	( )	Other _____		Garbage Grdr.	( )
		Other _____				Other _____	

NOTIFY HEALTH DEPARTMENT AT LEAST EIGHT HOURS BEFORE TANK IS TO BE INSPECTED.

Final Inspection 15 Aug 1965 Approved (✓) Disapproved ( )

Remarks _____

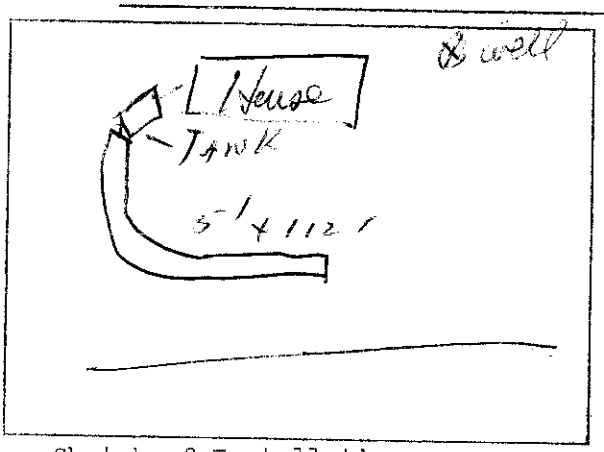

Sketch of Installation

Ray Sawyer RS

Sanitarian