IREDELL COUNTY HEALTH DEPARTMENT

Statesville Office (704) 878-5305 Mooresville Office (704) 660-3625 PERMIT # 210909

IMPROVEMENT PERMIT / AUTHORIZATION TO CONSTRUCT / OPERATION PERMIT / EXISTING SYSTEM

PIN # 4678-05-1667

APPLICANT: Lennie & Craig Lyon APPLICANT ADDRESS: 1164 Mt Ulla Hwy, Mooresville NC

SITE ADDRESS: 1164 Mt. Ulla Hwy PHONE: 704-877-4754 ALT. PHONE:

SITE DIRECTIONS: Hwy 801 E, Past Mooresville Business Park on R

SUBDIVISION: SECTION: LOT # LOT AREA: 1.0 ac DESIGN FLOW: 360 gpd L.T.A.R.: 0.35

Septic Tank EXISTING (gal) STB Date

Pump Tank (gal) PT Date

Pump Make Model Serial #

Nitrification Fields 1 # Lines 6 Linear Ft: 254

Trench Width 36" Max. Trench Bottom Depth 36" Gravel Depth N/A

☐ New System ☑ Repair ☐ Expansion System Type: I II ⓘ IV V VI

System Description:

Repair System Description: 25% REDUCTION

Maintenance Agreement Required: ☐ YES ☑ NO

☑ GRAVITY ☐ PRESSURE

☑ Residence No. Bedrooms 3

☐ Business No. Persons 6

☐ Other No. Employees


☐ Slab ☑ Crawl Space

☐ Basement w/plumbing ☐ Basement w/o plumbing


Water Supply: ☑ Private ☐ Public ☐ Community

Comments / Conditions: * Install Bull Run Valve to Allow switching between systems. Call with questions

INITIAL SITE SKETCH

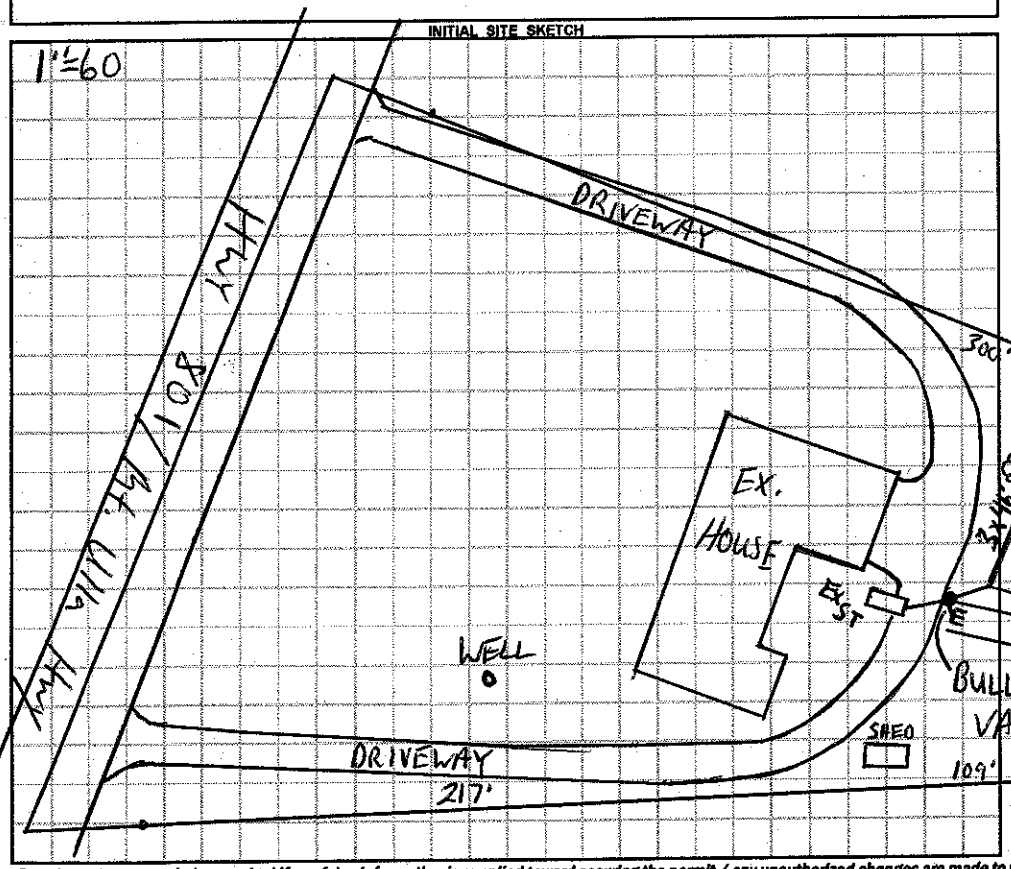

AS BUILT SKETCH

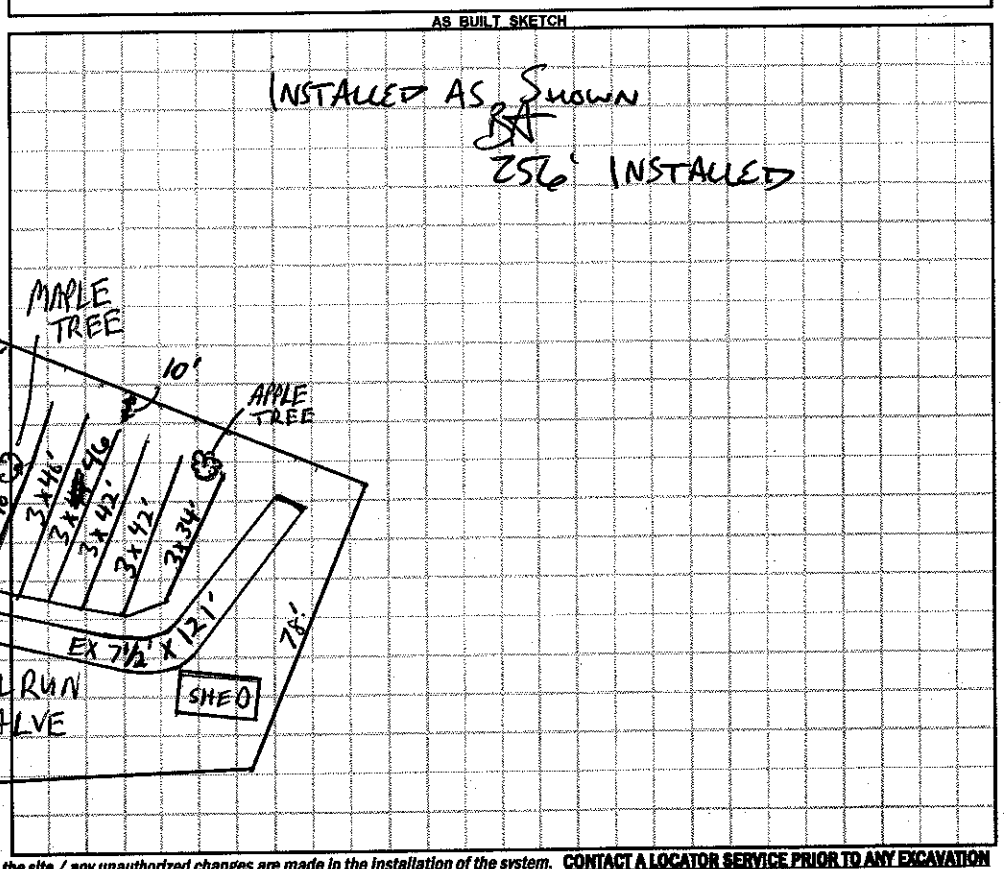

Permit can be suspended or revoked if any false information is supplied toward securing the permit / any unauthorized changes are made to the site / any unauthorized changes are made in the installation of the system. **CONTACT A LOCATOR SERVICE PRIOR TO ANY EXCAVATION**

☐ **IMPROVEMENT PERMIT** *with plat valid without expiration.* ☑ **IMPROVEMENT PERMIT** *with site plan valid for 60 mos.* ☑ **AUTHORIZATION TO CONSTRUCT** *valid for period equal to IMPROVEMENT PERMIT--not to exceed 60 mo.*

Owner / Applicant Signature: Date: 6-10-15 Installed by: GUNTER

IMPROVEMENT PERMIT by: Date: 6-10-15 OPERATION PERMIT by: Date: 6-12-15

AUTHORIZATION TO CONSTRUCT by: Date: 6-10-15 Existing System Inspected by: Date:

Health Dept. Copy - WHITE Applicant (Final Approval) - YELLOW Applicant (Conditional Approval) - PINK