Authorization to Construct 4078053704

IREDELL COUNTY HEALTH DEPARTMENT

STATESVILLE 704-878-5305 MOORESVILLE 704-664-5281

IMPROVEMENT PERMIT / ~~CERTIFICATE OF COMPLETION~~ / OPERATION PERMIT / EXISTING SYSTEM INSPECTION

PROPERTY DESCRIPTION NO. 23938 DATE 7/16/96 TAX MAP NO. 4C-A-80 Watershed: ☑ Yes ☐ No

OWNER OR CONTRACTOR Mark Mitchell PHONE: Business Home 664-9413 WSIV-BCU

ADDRESS 2061 Sta. Hwy. Mooresville NC 28115

LOCATION Hwy 801 N - 500' on Pt past Industrial Blvd.

SUBDIVISION — BLOCK / SECTION — LOT — LOT AREA +- 1ac SITE CLASS. PS DESIGN FLOW 360gpd L.T.A.R. .3gpd/ft²

Septic Tank: 1000 Gallons; STB 1012 Date 4/13/97

Pump Tank: Gallons; PT Date

Pump Make: Model Serial No.

Nitrification Field: No Fields 1 Square Feet 1200 Linear Feet 400

No Lines 4 Trench Width 36" Max Trench Bottom Depth 36" Gravel Depth 12"

☑ New System ☐ Repair System Type: I, II, III, IV, V, VI

System Description: Gravity Conventional

Repair System Description: Gravity Chambered

Maintenance Agreement Required: ☐ Yes ☑ No

☑ House/Mod. Home No. Bedrooms 3

☐ Mobile Home No. Bathrooms 2

☐ Business No. Employees

☐ Other


☐ Slab ☐ Crawl Space ☑ Basement w/plumbing ☐ Basement wo/plumbing

Water Supply: ☑ Individual ☐ Community ☐ Public


Comments:

Comments:

INITIAL SITE SKETCH (1" = 60')

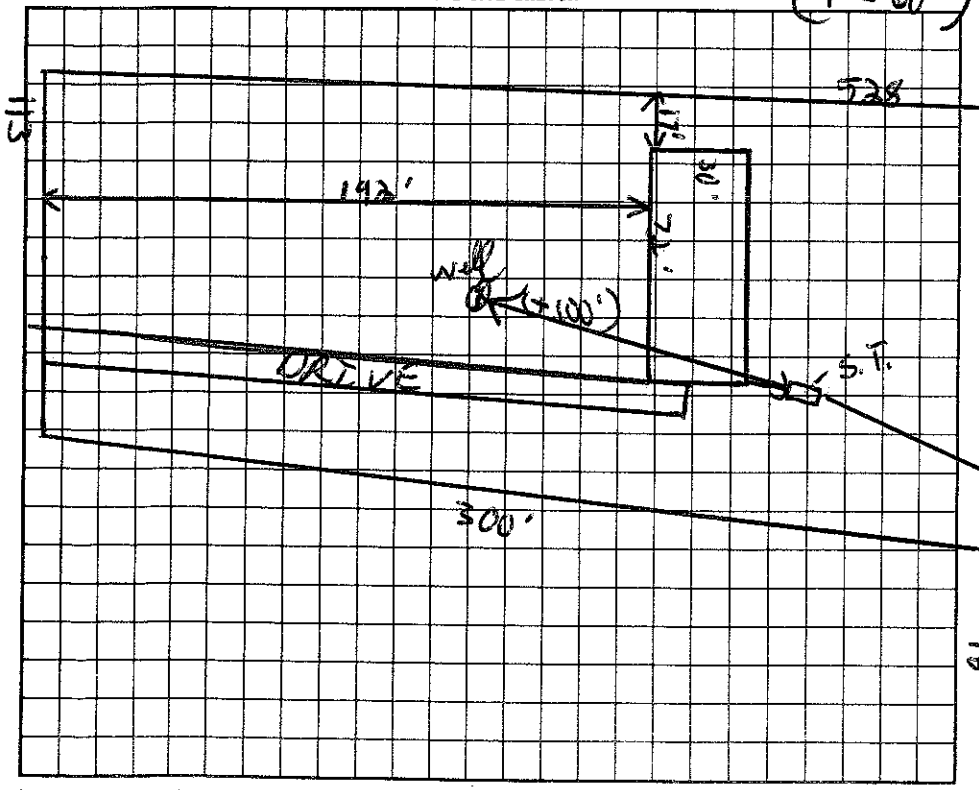

AS BUILT SKETCH

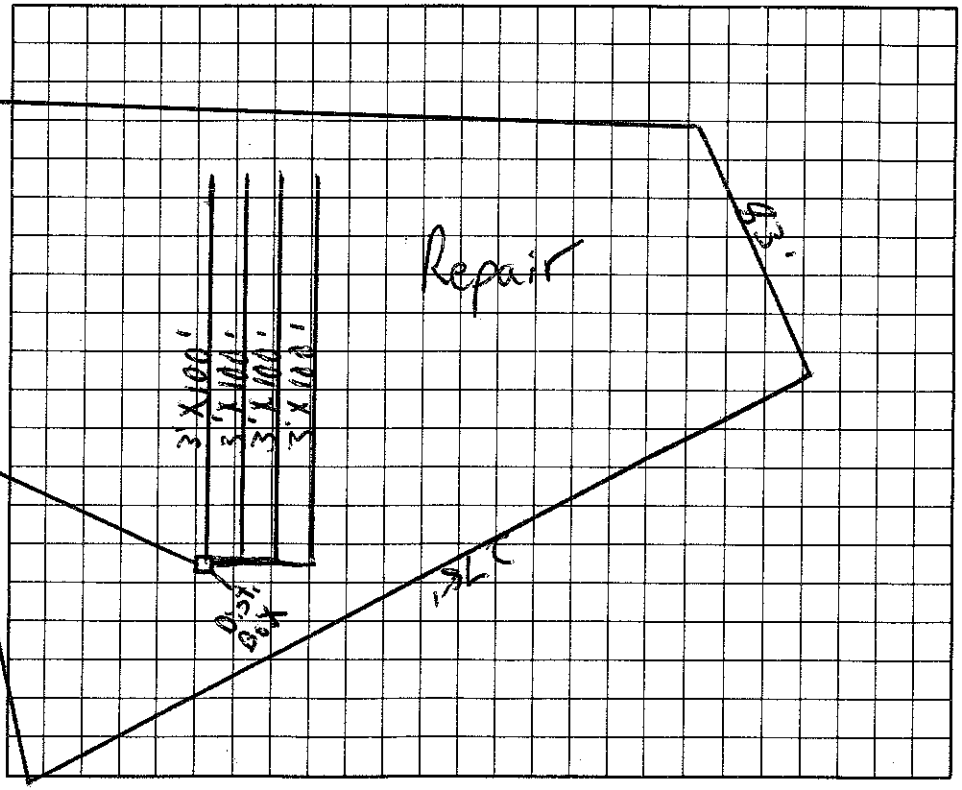

I understand that this permit can be suspended or revoked if any false information is supplied toward securing the permit/any unauthorized changes are made to the site/any unauthorized changes are made in the installation of the system.

Signed: Mark L Mitchell

Improvement Permit by: C. Ruby Thomas EHSI date 7/16/96

~~Existing System Inspection~~ by: C. Ruby Thomas EHSI date 7/16/96

Installed by: A-1 Backhoe

Certificate of Completion by: date

Operation Permit by: C. Ruby Thomas date 6/12/97

HEALTH DEPT. COPY: WHITE INSPECTION COPY (FINAL): GREEN OWNER COPY (FINAL): YELLOW INSPECTION COPY (INITIAL): PINK OWNER COPY (INITIAL): GOLD

Authorization to Construct (Improvements Permit is valid forever) Auth. to Constr. is valid for 60 month