IREDELL COUNTY HEALTH DEPARTMENT

Statesville Office (704) 878-5305 Mooresville Office (704) 660-3625 PERMIT # 177337

IMPROVEMENT PERMIT / AUTHORIZATION TO CONSTRUCT / OPERATION PERMIT / EXISTING SYSTEM

PIN # 4678-06-4001

APPLICANT: MARKNESS BUILDERS APPLICANT ADDRESS: 242 TEMPLETON RD

SITE ADDRESS: 000 MT. ULLA HWY PHONE: 704-622-3074 ALT. PHONE:


SITE DIRECTIONS: HWY 801

SUBDIVISION: SECTION: LOT # LOT AREA: ~1.7 AC DESIGN FLOW: 360 L.T.A.R.: .3


Septic Tank	1000	(gal)	STB	1012	Date	10-19-12	☒ New System	☐ Repair	☐ Expansion	System Type: I II III IV V VI	☒ Residence	No. Bedrooms	3	Water Supply
Pump Tank		(gal)	PT		Date		System Description:	25% REDUCTION			☐ Business	No. Persons		☒ Private
Pump Make			Model		Serial #		Repair System Description:	SAME			☐ Other	No. Employees		☐ Public
# Nitrification Fields	1		# Lines	3 @ 100'	Linear Ft:	300	Maintenance Agreement Required:	☐ YES	☒ NO		☐ Slab	☒ Crawl Space		☐ Community
Trench Width	36"		Max. Trench Bottom Depth	36"	Gravel Depth			☒ GRAVITY	☐ PRESSURE		☐ Basement w/ plumbing		☐ Basement w/o plumbing	

Comments / Conditions:

INITIAL SITE SKETCH

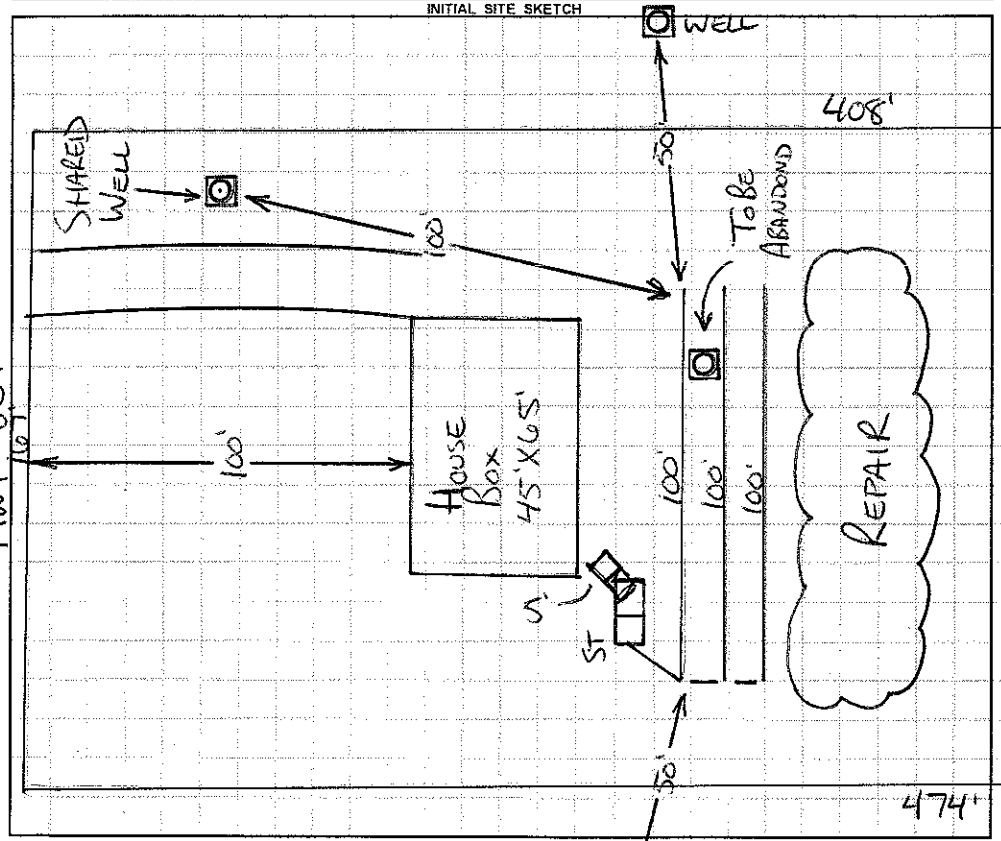

AS BUILT SKETCH

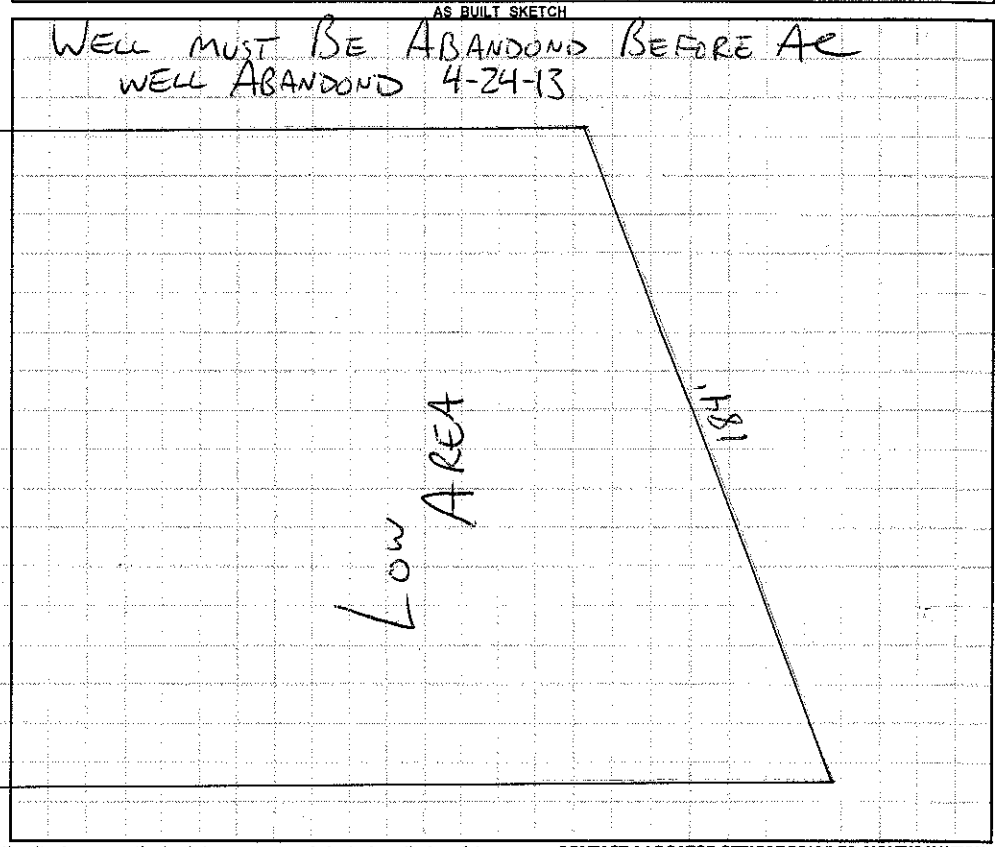

Permit can be suspended or revoked if any false information is supplied toward securing the permit / any unauthorized changes are made to the site / any unauthorized changes are made in the installation of the system. **CONTACT A LOCATOR SERVICE PRIOR TO ANY EXCAVATION**

☐ **IMPROVEMENT PERMIT** *with plat valid without expiration*

☒ **IMPROVEMENT PERMIT** *with site plan valid for 60 mos.*

☒ **AUTHORIZATION TO CONSTRUCT** *valid for period equal to IMPROVEMENT PERMIT--not to exceed 60 mo.*

Owner / Applicant Signature: Date: Installed by: PIEDMONT BACKHOE

IMPROVEMENT PERMIT by: R A Ellis Date: 4-22-13 OPERATION PERMIT by: T A Ellis Date: 7-10-13

AUTHORIZATION TO CONSTRUCT by: R A Ellis Date: 4-25-13 Existing System Inspected by: Date:

Health Dept. Copy - WHITE Applicant (Final Approval) - YELLOW Applicant (Conditional Approval) - PINK