BB

ICHD - ENVIRONMENTAL HEALTH DIVISION

Statesville Office (704) 878-5305 | Mooresville Office (704) 660-3625 | PERMIT # AP OSWP 2022-9583

SEPTIC: IMPROVEMENT PERMIT / AUTHORIZATION TO CONSTRUCT / OPERATION PERMIT / EXISTING SYSTEM

PIN # 4678 -- 08 -- 5216

APPLICANT/OWNER: Freedom Homes LLC | APPLICANT ADDRESS: 1124 Charlotte Hwy, 28166

SITE ADDRESS: 133 Wallaces Grant Dr. Mooresville, 28115 | PHONE: 704-881-2326 | ALT. PHONE

SITE DIRECTIONS: Mooresville Blvd - (L) W. Park Ave - (L) Wallaces Grant DR.

SAP CONTROLLED: ☐ YES ☐ NO

SUBDIVISION: | SECTION: — | LOT # — | LOT AREA: 1 acre | DESIGN FLOW: 240gpd | L.T.A.R.: Ex.

Septic Tank: Ex. (gal) | STB | Date
Pump Tank (gal) | PT | Date
Pump Make | Model | Serial #
Nitrification Fields | # Lines | Linear Ft
Trench Width | Trench Bottom Depth(Low side) | Gravel Depth

EXISTING


☐ New System ☐ Repair ☐ Expansion System Type: I (II) III IV V VI
System Description: Existing
Repair System Description: Existing
Maintenance Agreement Required: ☐ YES ☑ NO
☑ GRAVITY ☐ PRESSURE

☑ Residence | No. Bedrooms 2
☐ Business | No. Persons 4
☐ Other | No. Employees
☐ Slab | ☑ Crawl Space
☐ Basement w/plumbing | ☐ Basement w/o plumbing

Water Supply: ☑ Private ☐ Public ☐ Community

Comments / Conditions: System functioning correctly at time of inspection. Keep all building foundations 10' off septic.

INITIAL SITE SKETCH

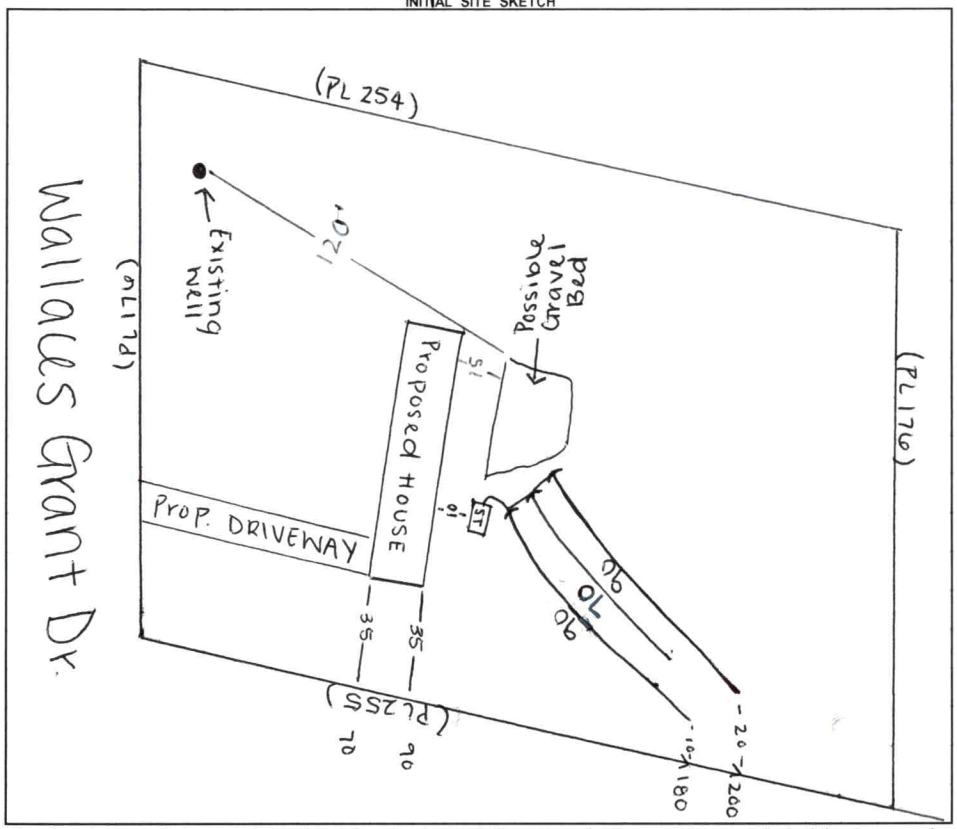

AS BUILT SKETCH

FOR SEPTIC FINAL INSPECTION CALL: 704-664-3703 between 8am-9am
the day the inspection is needed. Be sure to speak with an inspector to confirm your time.

Permit can be suspended or revoked if any false information is supplied toward securing the permit / any unauthorized changes are made to the site / any unauthorized changes are made in the installation of the system. **CONTACT A LOCATOR SERVICE PRIOR TO ANY EXCAVATION**


☐ **IMPROVEMENT PERMIT** ***with plat*** *valid without expiration.* ☐ **IMPROVEMENT PERMIT** ***with site plan*** *valid for 60 mos.* ☐ **AUTHORIZATION TO CONSTRUCT** *valid for period equal to IMPROVEMENT PERMIT--not to exceed 60 mo.*

Owner / Applicant Signature: | Date: | Installed by:


IMPROVEMENT PERMIT by: | Date: | OPERATION PERMIT by: | Date:

AUTHORIZATION TO CONSTRUCT by: | Date: | Existing System Inspected by: Sydney Holland | Date: 12-15-22

FOR SEPTIC FINAL INSPECTION: CALL 704-664-3703 between 8am-9am the day the inspection is needed.

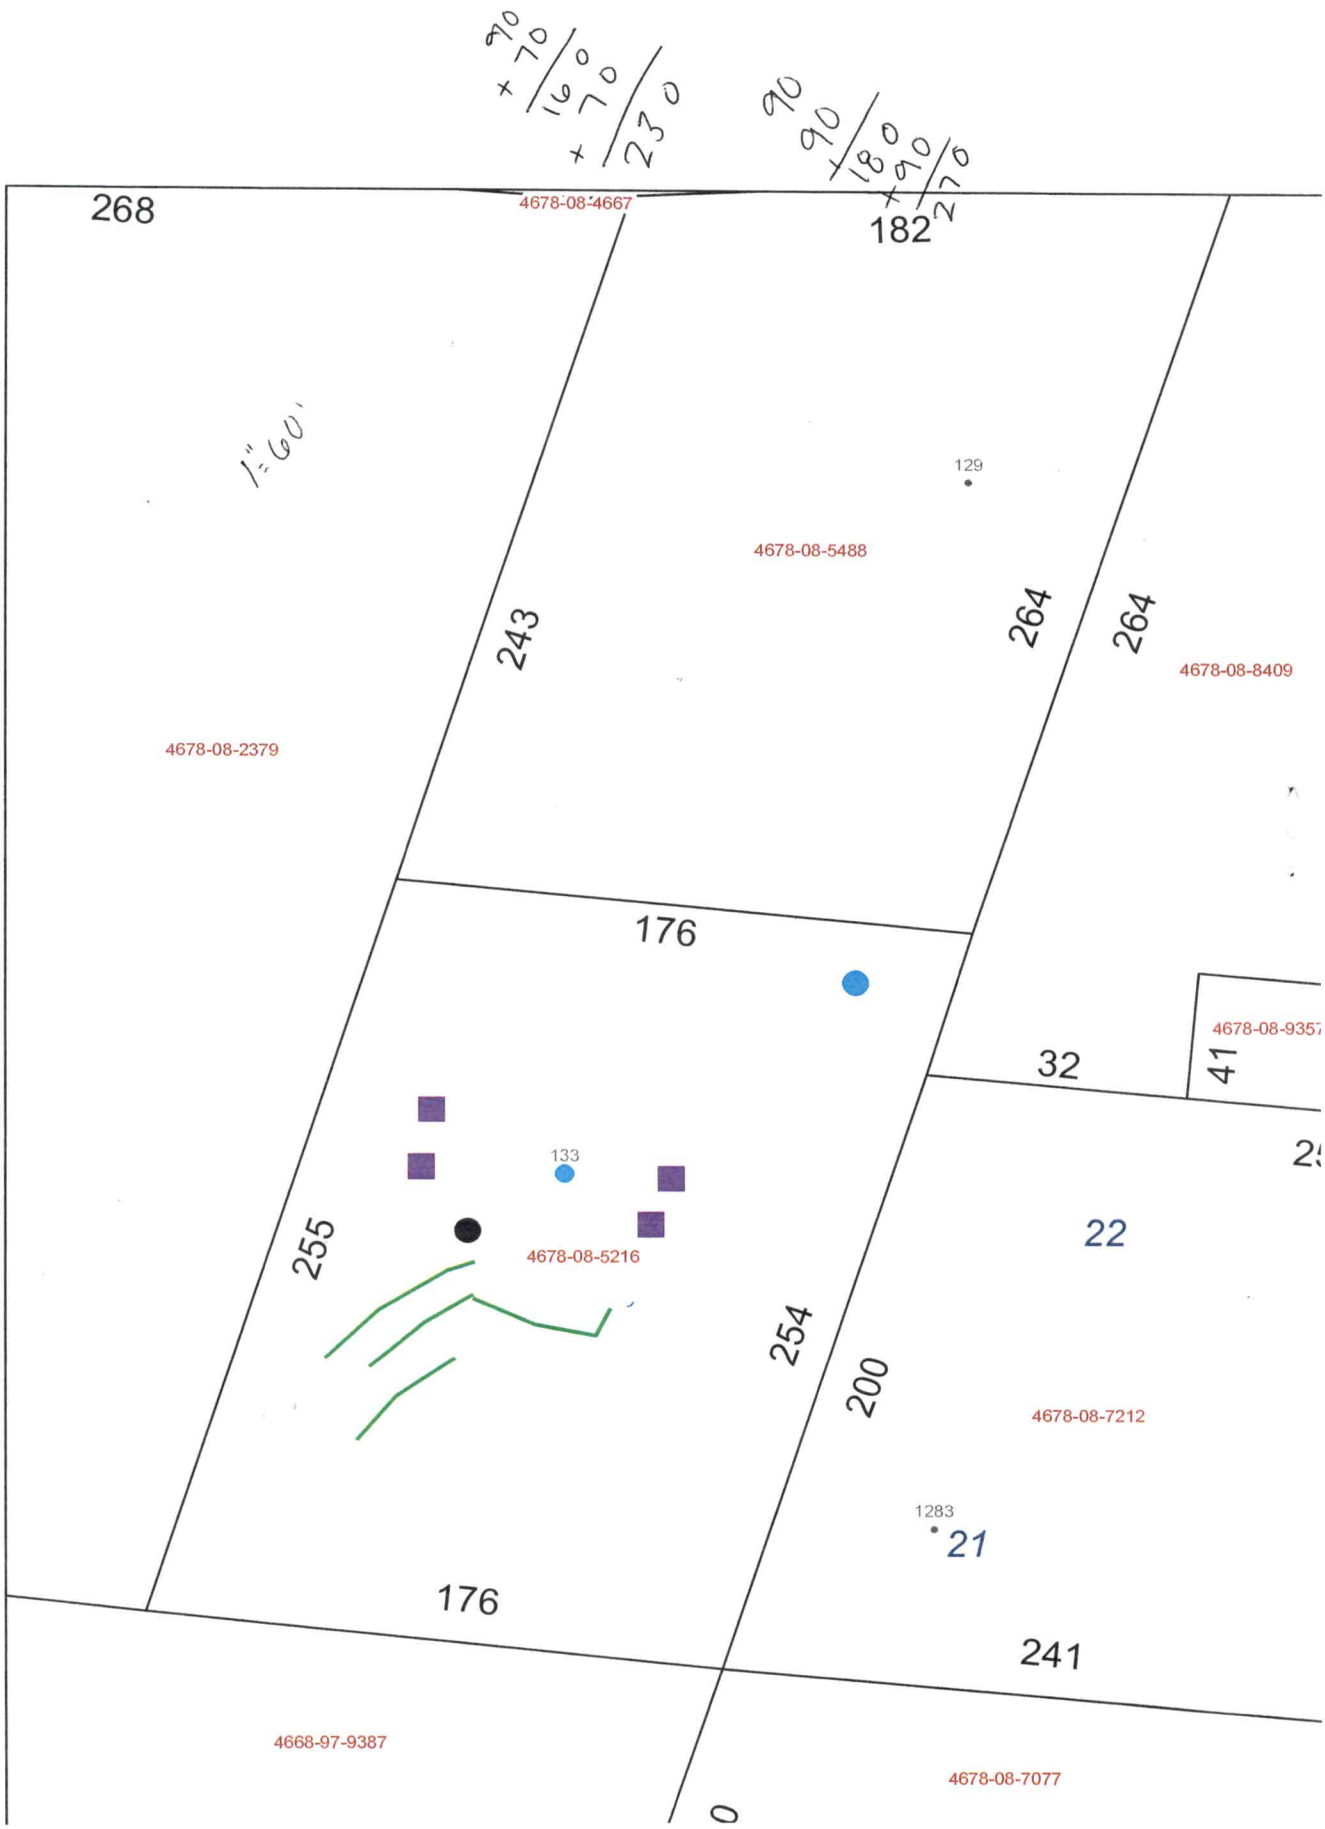
90
+ 70
160
+ 70
230
90
90
180
+ 90
270
268
4678-08-4667
182
1"=60'
129
4678-08-5488
243
264
264
4678-08-8409
4678-08-2379
176
4678-08-9357
32
41
133
255
4678-08-5216
22
254
200
4678-08-7212
1283
21
176
241
4668-97-9387
4678-08-7077
0

133 Wallace Grant DR
Mooresville, NC

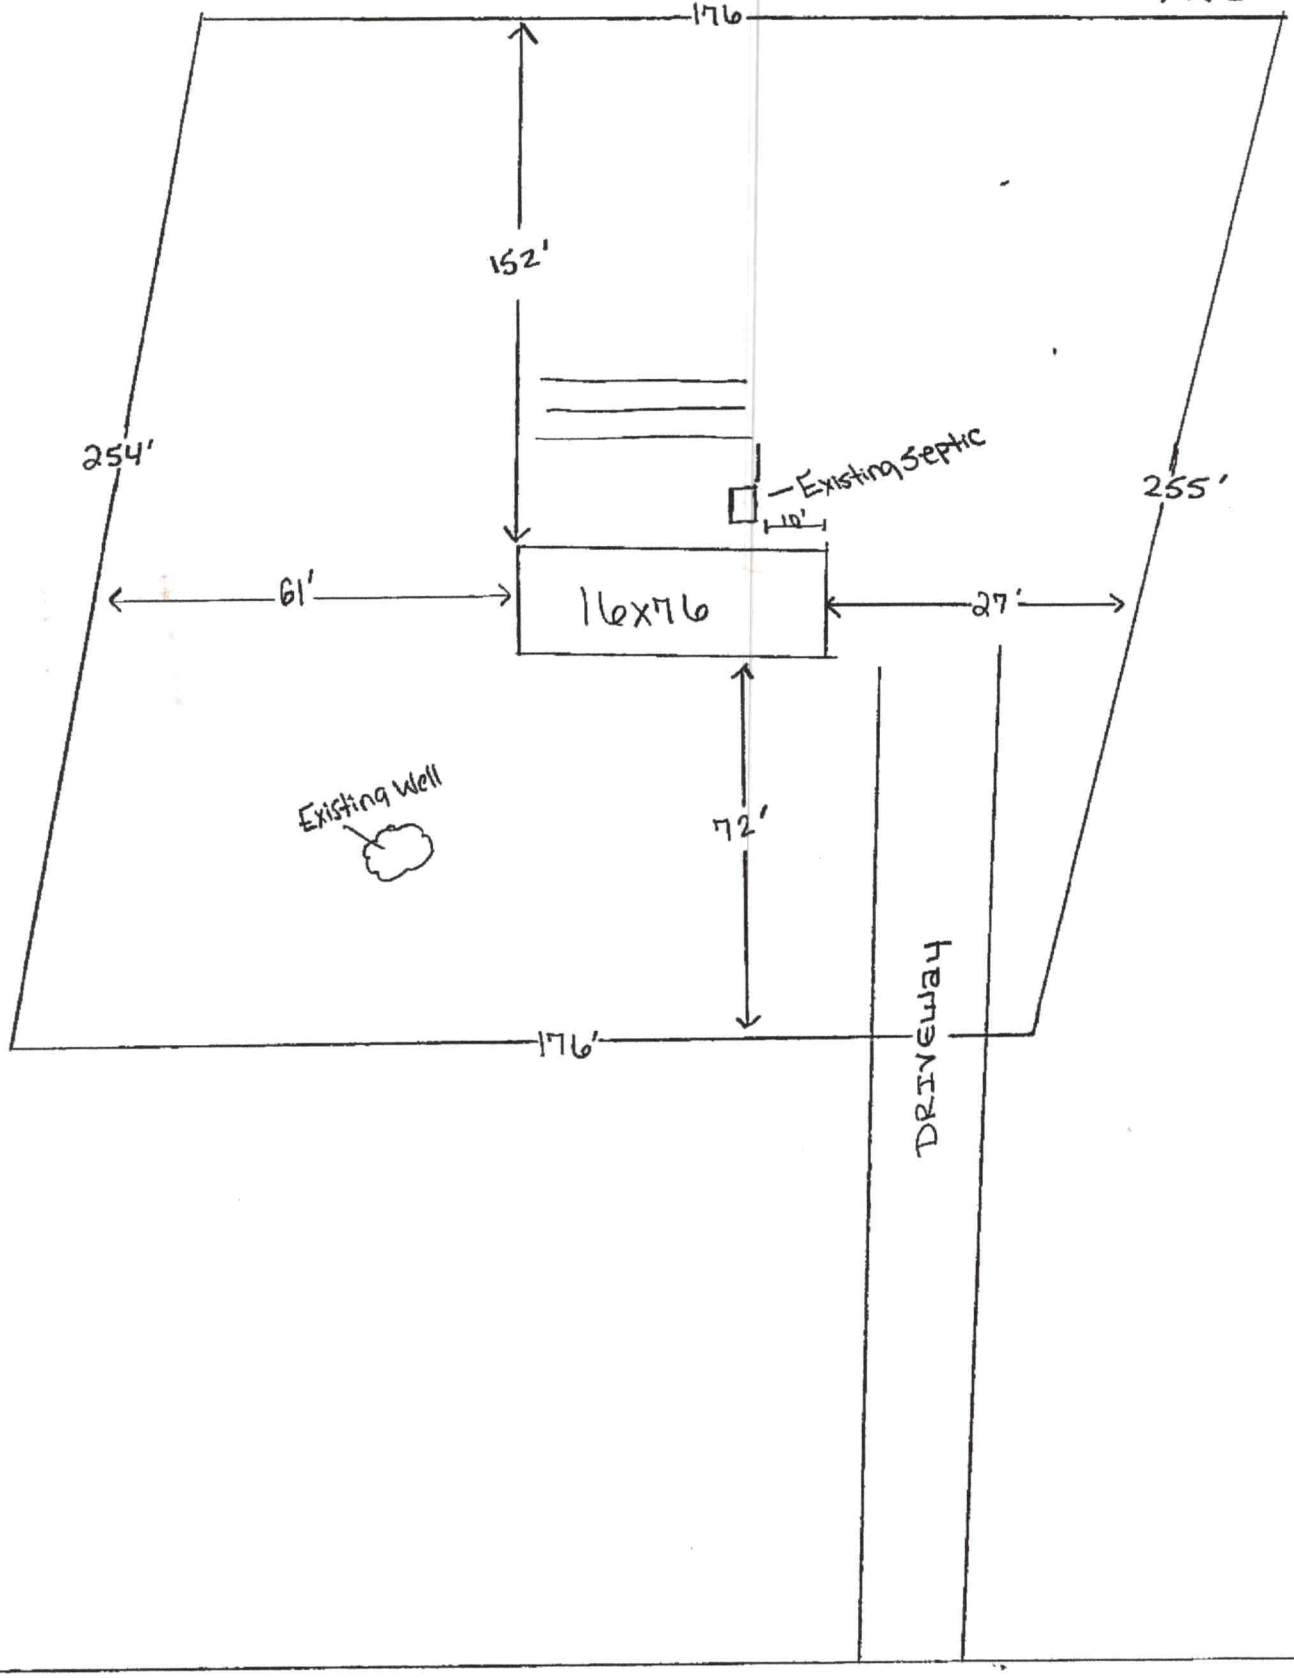

Wallace Grant Drive