1.30

IREDELL COUNTY HEALTH DEPARTMENT

STATESVILLE 704-878-5305 MOORESVILLE 704-664-5281

IMPROVEMENT PERMIT / AUTHORIZATION TO CONSTRUCT / OPERATION PERMIT / EXISTING SYSTEM INSPECTI

PERMIT# 144480 PIN# 4678088924 DATE 8/17/07

OWNER OR APPLICANT Todd Waugh PHONE: Business 704 651-9131 Home

ADDRESS 124 Wallaces Grant Dr. Mooresville NC

LOCATION Hwy 150 TL on 801 Hwy TL on Wallaces Grant lot behind 124 Wallaces Grant.

SUBDIVISION N/A BLOCK / SECTION 1 LOT LOT AREA 1.0 ac. SITE CLASS. PS DESIGN FLOW 360 L.T.A.R. .275

Septic Tank: 1000 Gallons: STB 760 Date 8-11-07

Pump Tank: Gallons: PT Date

Pump Make: Model Serial No.

Nitrification Field: No Fields 1 Square Feet 990 Linear Feet 330'

No Lines 6 Trench Width 36" Max Trench Bottom Depth 36" Gravel Depth NA

☐ New System ☐ Repair ☐ Expansion System Type: I (II) III IV V VI

System Description: Gravity 25% Reduction

Repair System Description: Conventional or 25% Red.

Maintenance Agreement Required: ☐ Yes ☒ No

☑ House/Mod. Home No. Bedrooms 3

☐ Mobile Home No. Persons

☐ Business No. Employees

☐ Other

Water Supply: ☑ Individual ☐ Public ☐ Community


☐ Gravity ☐ Pressure ☐ Slab ☑ Crawl Space ☐ Basement w/plumbing ☐ Basement wo/plumbing

Comments/Conditions: If using equal distribution = 213'
use 2 flow dividers and 2
Drop boxes to serial distribution
use drop boxes w/ flow levelers


Comments/Conditions: Polylok filter installed

1" = 50'

INITIAL SITE SKETCH

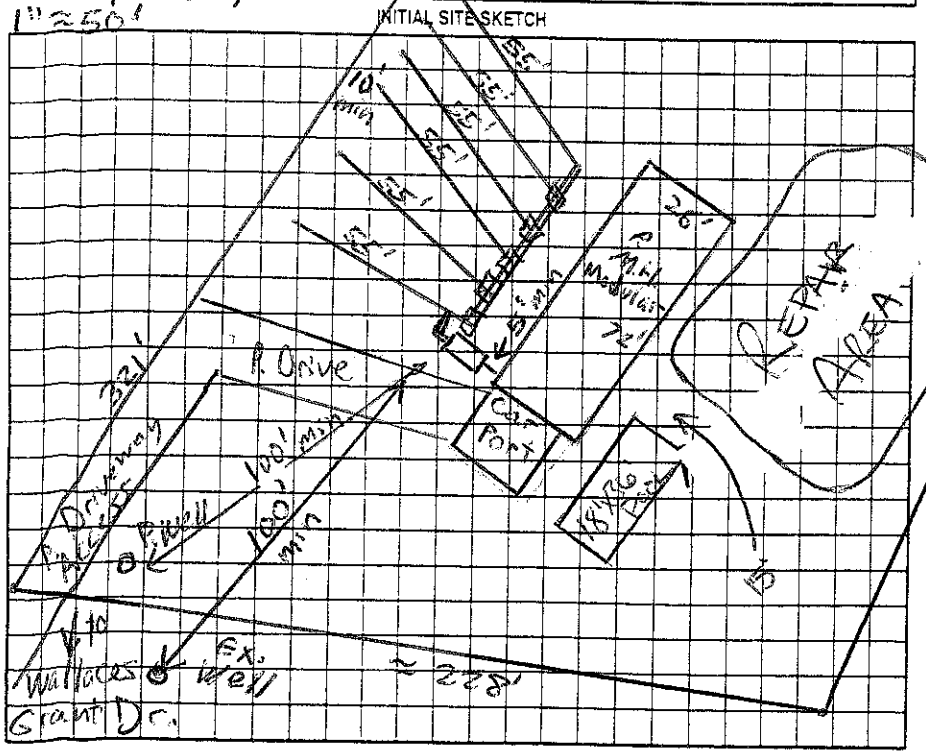

AS BUILT SKETCH

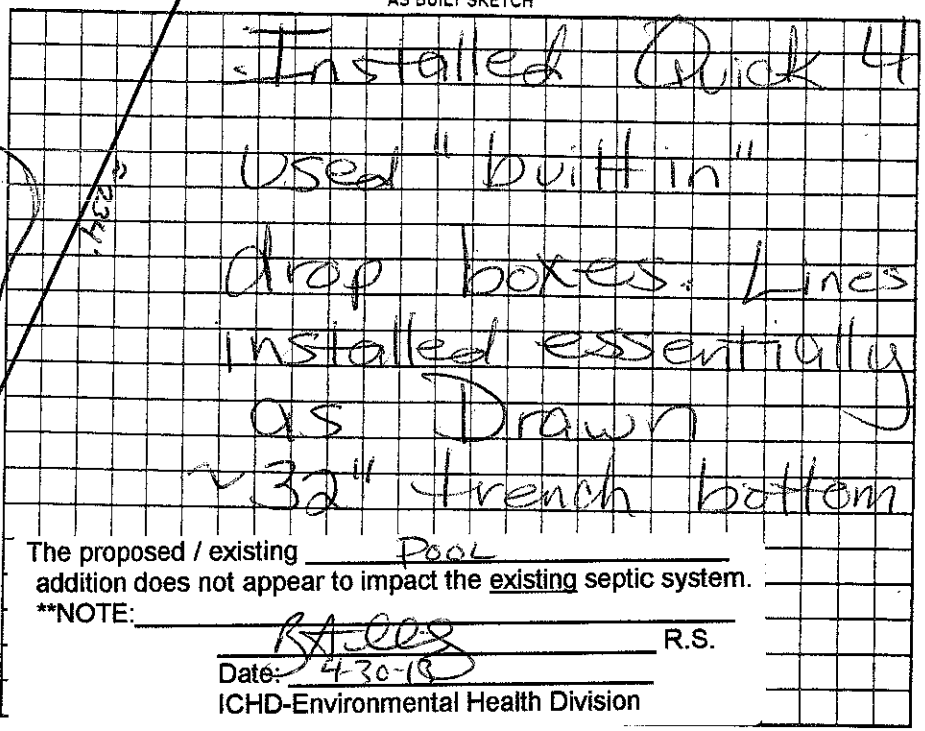

The proposed / existing Pool addition does not appear to impact the existing septic system.

**NOTE:

R.S.

Date: 4-30-08

ICHD-Environmental Health Division

Permit can be suspended or revoked if any false information is supplied toward securing the permit/any unauthorized changes are made to the site/any unauthorized changes are made in the installation of the system. Improvement Permit with plat valid without expiration ☐ Improvement Permit with site plan valid for sixty months ☑ Authorization to Construct is valid for a period equal to that of Improvement Permit – not to exceed sixty months.

Signed: Todd Waugh date 8/17/07

Improvement Permit by: Anthony Cohen Jr. date 8/17/07

Authorization to Construct by: Anthony Cohen Jr. date 8/17/07

Installed by: Abee's Grading

Operation Permit by: Maintenance Branch date 11/30/07

Existing System Inspection by: date

HEALTH DEPT. COPY: WHITE OWNER COPY (FINAL): YELLOW OWNER COPY (INITIAL): PINK