4678185739

IREDELL COUNTY HEALTH DEPARTMENT

STATESVILLE 704-878-5305 MOORESVILLE 704-664-5281

IMPROVEMENT PERMIT / CERTIFICATE OF COMPLETION / OPERATION PERMIT / EXISTING SYSTEM INSPECTION

PROPERTY DESCRIPTION NO. 21491 DATE 6/30/95 TAX MAP NO. 4C 2B 8 Watershed: ☒ Yes ☐ No

OWNER OR CONTRACTOR Jay M Hamilton PHONE: Business _____ Home 663-4111

ADDRESS 1320 Mt Ulla Hwy Mooresville, NC.

LOCATION 801 N - 1.6 miles on (2)

SUBDIVISION Wm Howard Est BLOCK / SECTION _____ LOT 4b LOT AREA 75' x 370' SITE CLASS. P DESIGN FLOW 240 L.T.A.R. .325

Septic Tank: 1000 Gallons; STB 794 Date 10/4/95

Pump Tank: _____ Gallons; PT _____ Date _____

Pump Make: _____ Model _____ Serial No. _____

Nitrification Field: No Fields 1 Square Feet 738 Linear Feet 250

No Lines 3 Trench Width 36" Max Trench Bottom Depth 32" Gravel Depth 12"

☒ New System ☐ Repair System Type: I, (II), III, IV, V, VI

System Description: DIST BOX - CONVENTIONAL

Repair System Description: SAME

Maintenance Agreement Required: ☐ Yes ☒ No

☒ House/Mod. Home No. Bedrooms 2

☐ Mobile Home No. Bathrooms 1

☐ Business No. Employees ____

☐ Other _____

☐ Slab ☒ Crawl Space ☐ Basement w/plumbing ☐ Basement wo/plumbing


Water Supply: ☒ Individual ☐ Community ☐ Public

Comments:


Well location necessary due to drainfield on either side of this lot.

Comments:

INITIAL SITE SKETCH

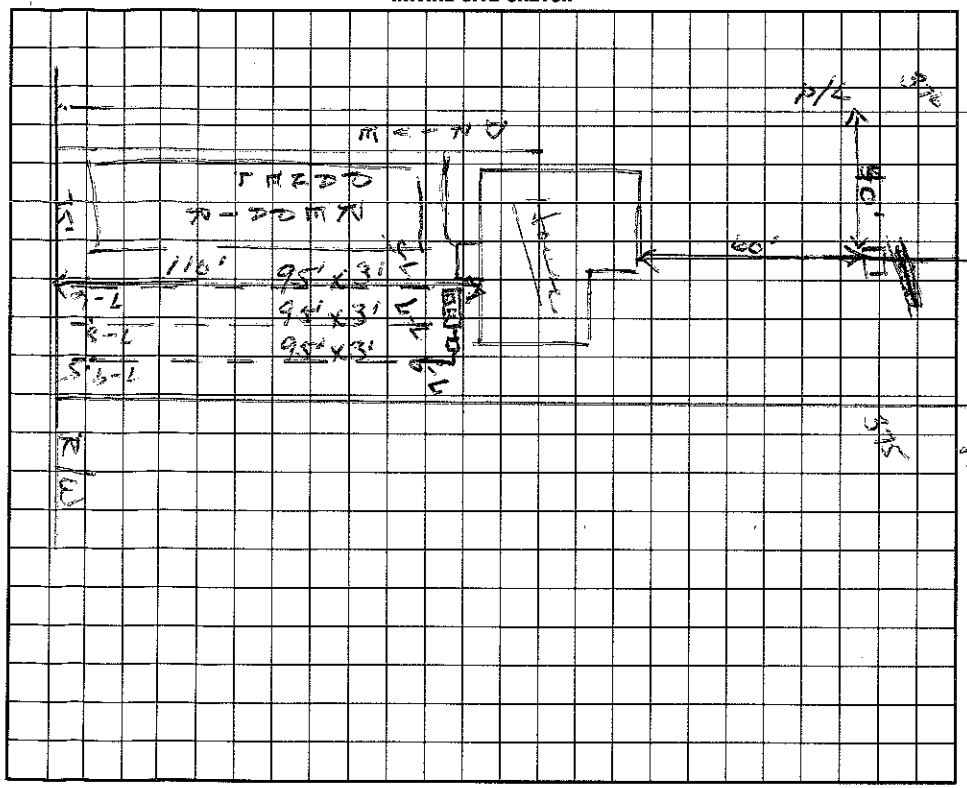

AS BUILT SKETCH

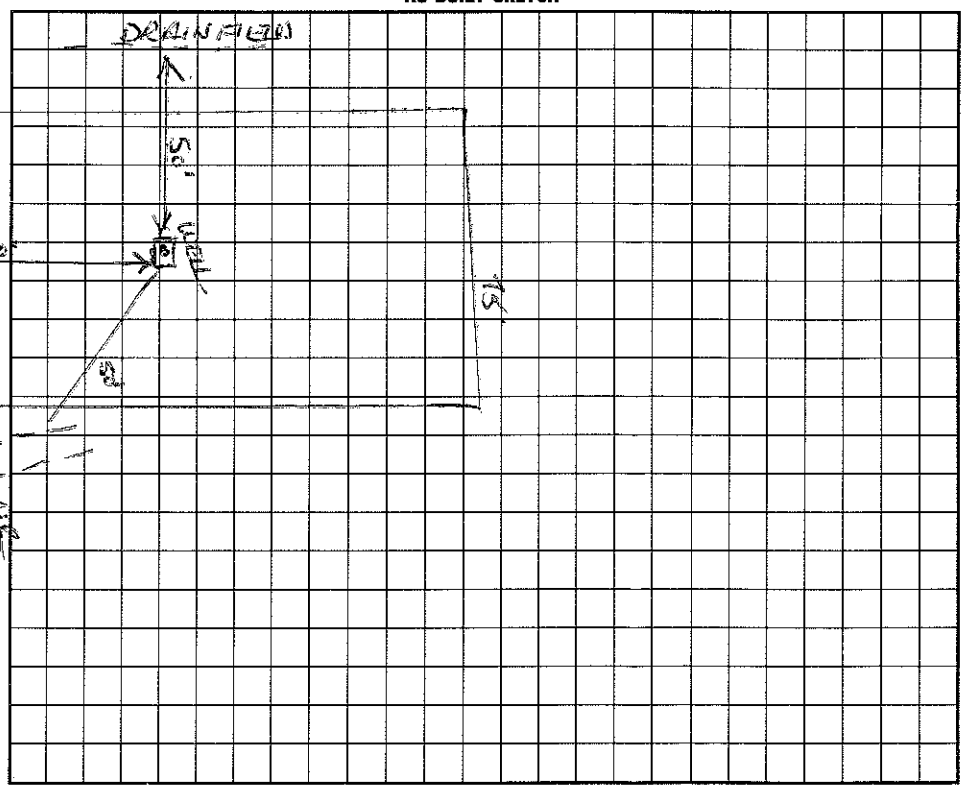

I understand that this permit can be suspended or revoked if any false information is supplied toward securing the permit/any unauthorized changes are made to the site/any unauthorized changes are made in the installation of the system. Improvement Permit is valid for 60 months from date of issuance.

Signed: [signature]

Improvement Permit by: Wesley Sparks R.S. date 6/30/95

Existing System Inspection by: _____ date _____

Installed by: E J Ervin

Certificate of Completion by: _____ date _____

Operation Permit by: Wesley Sparks R.S. date 12/7/95

HEALTH DEPT. COPY: WHITE INSPECTION COPY (FINAL): GREEN OWNER COPY (FINAL): YELLOW INSPECTION COPY (INITIAL): PINK OWNER COPY (INITIAL): GOLD