IREDELL COUNTY HEALTH DEPARTMENT

Authorization to Construct (Bob Sherrill)

STATESVILLE 704-878-5305 MOORESVILLE 704-664-5281

IMPROVEMENT PERMIT / ~~CERTIFICATE OF COMPLETION~~ / OPERATION PERMIT / EXISTING SYSTEM INSPECTION

PROPERTY DESCRIPTION NO. 26059 DATE 2/20/97 TAX MAP NO. 4678193325 Watershed: X Yes ☐ No

OWNER OR CONTRACTOR James J Sherrill PHONE: Business _____ Home 663-7515

ADDRESS 1343 Wilkesboro Hwy Mooresville, NC. 28115

LOCATION 801 N on (E) before Triplett Rd., beside #1343

SUBDIVISION _____ BLOCK / SECTION _____ LOT _____ LOT AREA _____ SITE CLASS. PS DESIGN FLOW 360 L.T.A.R. .3

Septic Tank: 1000 Gallons; STB 794 Date 3/4/97

Pump Tank: _____ Gallons; PT _____ Date _____

Pump Make: _____ Model _____ Serial No. _____

Nitrification Field: No Fields 1 Square Feet 1200 Linear Feet 400

No Lines 4 Trench Width 36" Max Trench Bottom Depth 30" Gravel Depth _____

X New System ☐ Repair System Type: I, II, III, IV, V, VI

System Description: CONV - DIST BOX

Repair System Description: CH ALGASTIC

Maintenance Agreement Required: ☐ Yes ☐ No

X House/Mod. Home No. Bedrooms 3

☐ Mobile Home No. Bathrooms 2

☐ Business No. Employees _____

☐ Other _____


☐ Slab ☐ Crawl Space ☐ Basement w/plumbing ☐ Basement wo/plumbing

Water Supply:
X Individual
☐ Community
☐ Public
GOOD


Comments: Water to come from Dad father's well.

Comments: LINES WERE LEFT OPEN FOR A WEEK AND WELL RAINED IN.

INITIAL SITE SKETCH

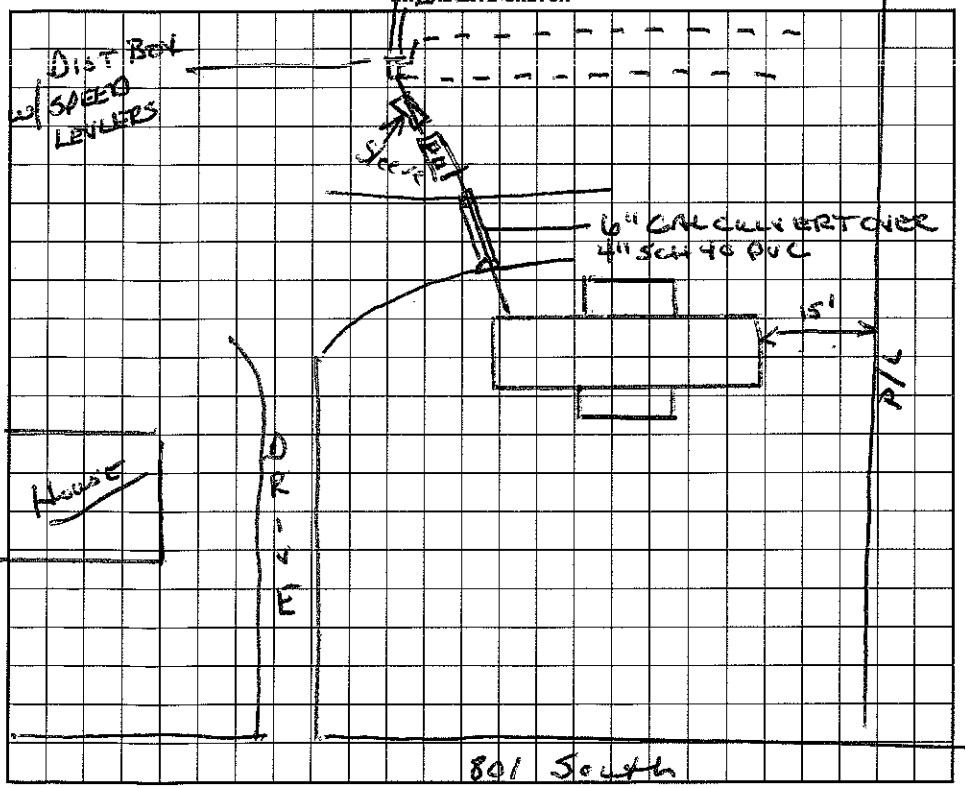

AS BUILT SKETCH

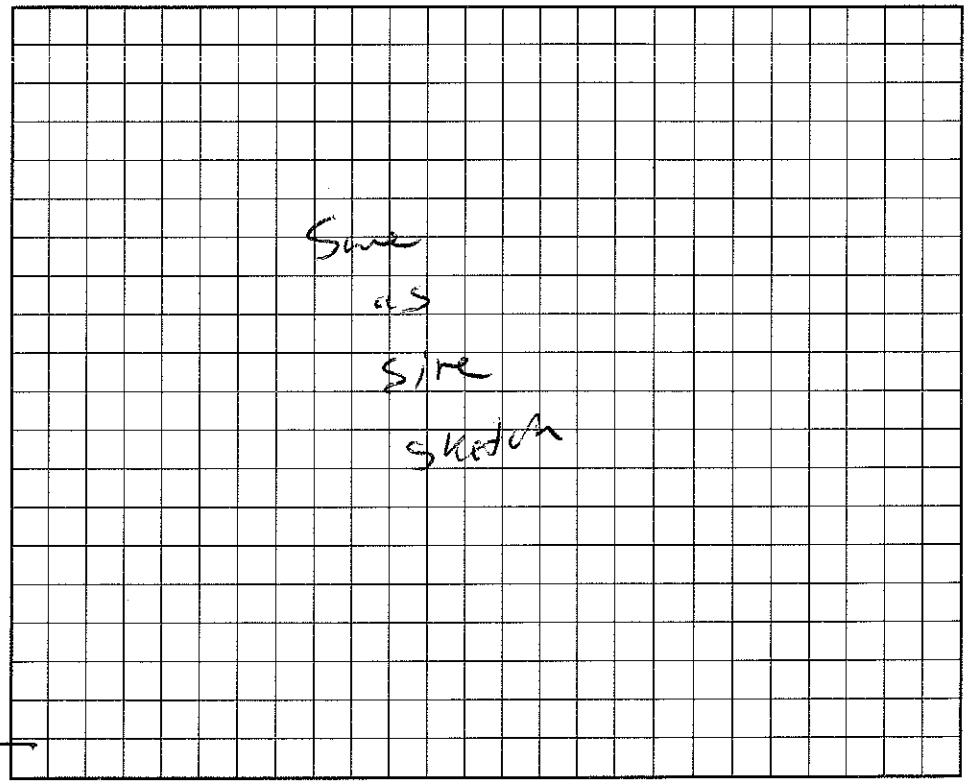

I understand that this permit can be suspended or revoked if any false information is supplied toward securing the permit/any unauthorized changes are made to the site/any unauthorized changes are made in the installation of the system.

Signed: X James J Sherrill

Improvement Permit by: Wesley Hughes RS. date 2/20/97

Existing System Inspection by: Wesley Hughes RS. date 2/20/97

Installed by: BOB SHERRILL

Certificate of Completion by: _____ date _____

Operation Permit by: _____ date 5/28/97

HEALTH DEPT. COPY: WHITE INSPECTION COPY (FINAL): GREEN OWNER COPY (FINAL): YELLOW INSPECTION COPY (INITIAL): PINK OWNER COPY (INITIAL): GOLD