IREDELL COUNTY HEALTH DEPARTMENT

Authorization to Construct (Bob Sherrill) –

STATESVILLE 704-878-5305 MOORESVILLE 704-664-5281

IMPROVEMENT PERMIT / ~~CERTIFICATE OF COMPLETION~~ / OPERATION PERMIT / EXISTING SYSTEM INSPECTION

PROPERTY DESCRIPTION NO. 26059 DATE 2/20/97 TAX MAP NO. 4678193325 Watershed: ☒ Yes ☐ No

OWNER OR CONTRACTOR James J Sherrill PHONE: Business _____ Home 663-7515

ADDRESS 1343 Mocksville Hwy Mooresville, NC. 28115

LOCATION 801 N on @ before Triplett Rd., Inside #1343

SUBDIVISION _____ BLOCK / SECTION _____ LOT _____ LOT AREA _____ SITE CLASS. PS DESIGN FLOW 360 L.T.A.R. .3

Septic Tank: 1000 Gallons; STB 794 Date 3/4/97
Pump Tank: _____ Gallons; PT _____ Date _____
Pump Make: _____ Model _____ Serial No. _____
Nitrification Field: No Fields 1 Square Feet 1200 Linear Feet 400
No Lines 4 Trench Width 36" Max Trench Bottom Depth 30" Gravel Depth _____

☒ New System ☐ Repair System Type: I, ☒ II, III, IV, V, VI
System Description: CONV - DIST BOX
Repair System Description: CH ALGSTIC
Maintenance Agreement Required: ☐ Yes ☐ No


☒ House/Mod. Home No. Bedrooms 3
☐ Mobile Home No. Bathrooms 2
☐ Business No. Employees _____
☐ Other _____
☐ Slab ☐ Crawl Space ☐ Basement w/plumbing ☐ Basement wo/plumbing

Water Supply:
☒ Individual
☐ Community
☐ Public
GOOD

Comments: Water to come from Dad father's well.

Comments: LINES WERE LEFT OPEN FOR A WEEK AND WELL RAINED IN.

INITIAL SITE SKETCH

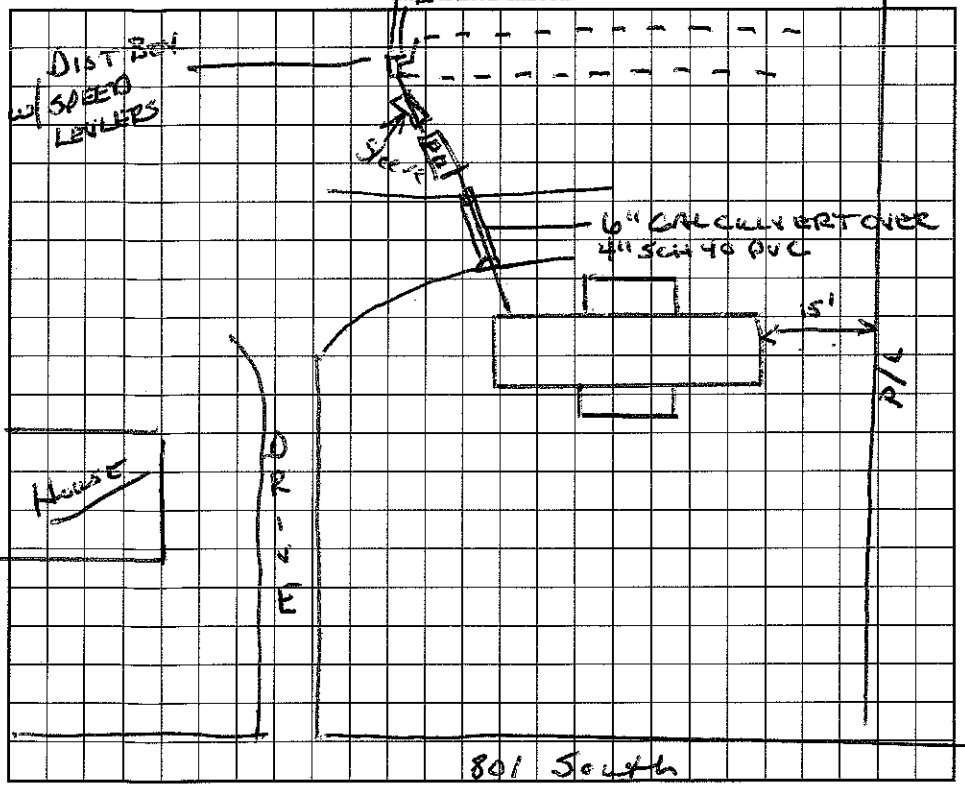

AS BUILT SKETCH

Same as site sketch

I understand that this permit can be suspended or revoked if any false information is supplied toward securing the permit/any unauthorized changes are made to the site/any unauthorized changes are made in the installation of the system.

Signed: James J Sherrill

Installed by: BOB SHERRILL

Improvement Permit by: Wesley Sparks RS date 2/20/97

Certificate of Completion by: _____ date _____

Existing System Inspection by: Wesley Sparks RS date 2/20/97

Operation Permit by: _____ date 5/28/97

HEALTH DEPT. COPY: WHITE INSPECTION COPY (FINAL): GREEN OWNER COPY (FINAL): YELLOW INSPECTION COPY (INITIAL): PINK OWNER COPY (INITIAL): GOLD