ICHD - ENVIRONMENTAL HEALTH DIVISION

Statesville Office (704) 878-5305 | Mooresville Office (704) 660-3625 (NW) | PERMIT # 2023-19314

SEPTIC: IMPROVEMENT PERMIT / AUTHORIZATION TO CONSTRUCT / OPERATION PERMIT / EXISTING SYSTEM

PIN # 4678 -- 19 -- 5814 ✓

APPLICANT/OWNER: Jeanie Lentz | APPLICANT ADDRESS: 463 Lentz Rd, Statesville

SITE ADDRESS: 1367 Mt Ulla Hwy, Mooresville 28115 ✓ | PHONE: 980-829-3278 | ALT. PHONE -

SITE DIRECTIONS: Hwy 70 - Triplett - Mt Ulla | SAP CONTROLLED: ☐ YES ☐ NO

SUBDIVISION: W M Howard Est ✓ | SECTION: - | LOT # 15, 16, 18 | LOT AREA: 2.126 acres | DESIGN FLOW: 240 gpd | L.T.A.R.: EX


Septic Tank	1000 (gal)	STB	760	Date		☐ New System ☒ Repair ☐ Expansion	System Type: I (II) III IV V VI	☒ Residence	No. Bedrooms 2
Pump Tank	(gal)	PT		Date		System Description:		☐ Business	No. Persons 4
Pump Make		Model		Serial #		Repair System Description:	Tank Replacement	☐ Other	No. Employees
# Nitrification Fields	EX	# Lines	EX	Linear Ft	EX	Maintenance Agreement Required:	☐ YES ☒ NO	☐ Slab	☒ Crawl Space
Trench Width	EX	Trench Bottom Depth(Low side)	EX	Gravel Depth	EX	☒ GRAVITY	☐ PRESSURE	☐ Basement w/plumbing	☐ Basement w/o plumbing

Water Supply: ☒ Private ☐ Public ☐ Community

Comments / Conditions: Pump, crush, & fill old tank. If fall cannot be achieved pump must be installed. or replumb the house.

* Keep 50' from well *

INITIAL SITE SKETCH

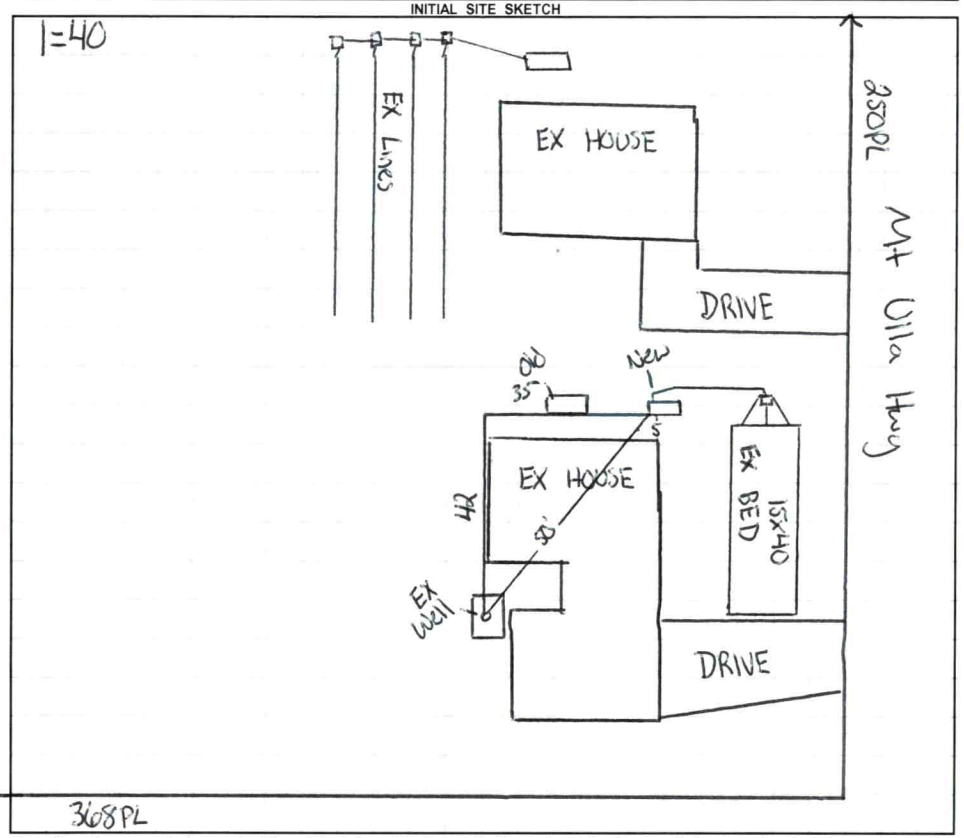

AS BUILT SKETCH

FOR SEPTIC FINAL INSPECTION CALL: 704-664-3703 between 8am-9am
the day the inspection is needed. Be sure to speak with an inspector to confirm your time.

Installed as Shown

Permit can be suspended or revoked if any false information is supplied toward securing the permit / any unauthorized changes are made to the site / any unauthorized changes are made in the installation of the system. **CONTACT A LOCATOR SERVICE PRIOR TO ANY EXCAVATION**

☐ **IMPROVEMENT PERMIT** ***with plat*** *valid without expiration.* ☒ **IMPROVEMENT PERMIT** ***with site plan*** *valid for 60 mos.* ☒ **AUTHORIZATION TO CONSTRUCT** *valid for period equal to IMPROVEMENT PERMIT--not to exceed 60 mo.*

Owner / Applicant Signature: Online Signature | Date: | Installed by: Lentz

IMPROVEMENT PERMIT by: Cory Hill | Date: 3/24/23 | OPERATION PERMIT by: Sydney Holland | Date: 5/25/23

AUTHORIZATION TO CONSTRUCT by: Cory Hill | Date: 3/24/23 | Existing System Inspected by: | Date:

FOR SEPTIC FINAL INSPECTION: CALL 704-664-3703 between 8am-9am the day the inspection is needed.