IREDELL COUNTY HEALTH DEPARTMENT

...LE 704-878-5305 MOORESVILLE 704-664-5281

IMPROVEMENT PERMIT / AUTHORIZATION TO CONST — OPERATION PERMIT / EXISTING SYSTEM INSPECTION

PERMIT# Repair PIN# 4078195814 DATE 9/21/05

OWNER OR CONTRACTOR Beverly Pierce PHONE: Business 704 892 6699 Home 704 664 7042

ADDRESS 669 Mazeppa Rd Mooresville NC 28115

LOCATION Hwy 801 N, on Lt before Tripplet Rd #1373

SUBDIVISION ____ BLOCK / SECTION ____ LOT ____ LOT AREA ____ SITE CLASS. PS DESIGN FLOW 240 L.T.A.R. —

Septic Tank: 1000 Gallons; STB 794 Date 9/12/05

Pump Tank: ____ Gallons; PT ____ Date ____

Pump Make: ____ Model ____ Serial No. ____

Nitrification Field: No Fields 1 Square Feet 660 Linear Feet 220

No Lines 4 Trench Width 36" Max Trench Bottom Depth 24" Gravel Depth —

☒ New System ☐ Repair System Type: I, II, III, IV, V, VI

System Description: 25% Reduction

Repair System Description: ____

Maintenance Agreement Required: ☐ Yes ☒ No

☒ House/Mod. Home No. Bedrooms 2

☐ Mobile Home No. Bathrooms ____

☐ Business No. Employees ____

☐ Other ____

☐ Slab ☒ Crawl Space ☐ Basement w/plumbing ☐ Basement wo/plumbing


Water Supply: ☒ Individual ☐ Public ☐ Community

Shared


Comments:/Conditions:

Comments:/Conditions:

INITIAL SITE SKETCH

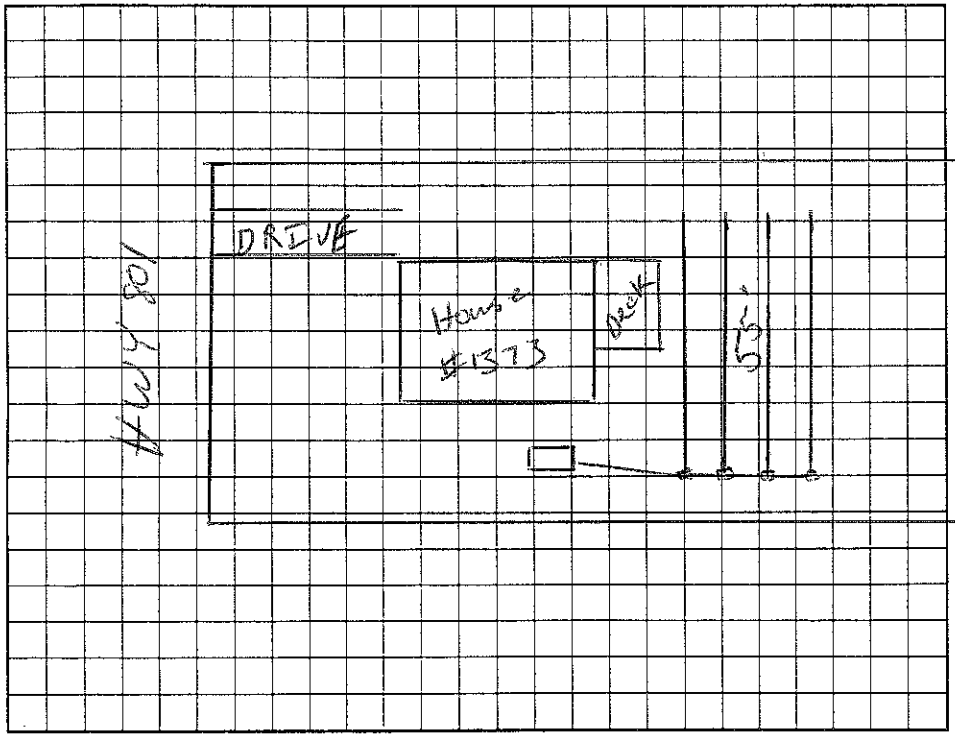

AS BUILT SKETCH

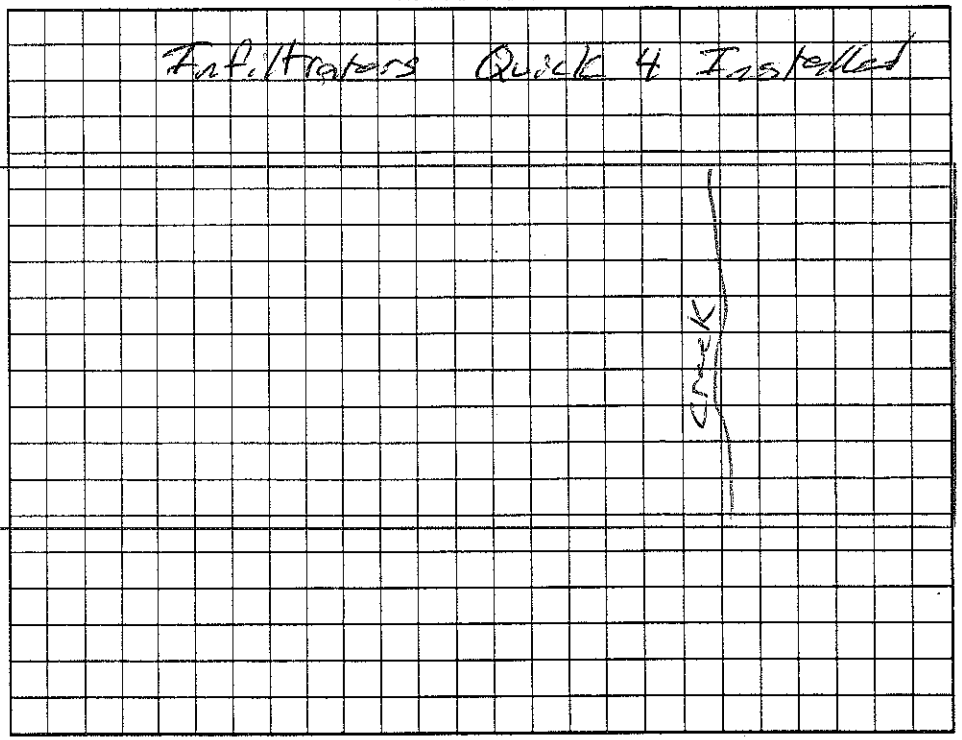

Permit can be suspended or revoked if any false information is supplied toward securing the permit/any unauthorized changes are made to the site/any unauthorized changes are made in the installation of the system. Improvement Permit with plat valid without expiration. Improvement Permit with site plan valid for sixty months. Authorization to Construct is valid for a period equal to that of Improvement Permit – not to exceed sixty months.

Signed: Nicole Lobbs date 9/26/05 Installed by: Osbison

Improvement Permit by: RS date 9/21/05 Operation Permit by: RS date 10/18/05

Authorization to Construct by: RS date 9/21/05 Existing System Inspection by: ____ date ____

HEALTH DEPT. COPY: WHITE OWNER COPY (FINAL): YELLOW OWNER COPY (INITIAL): PINK