(11:00)

IREDELL COUNTY HEALTH DEPARTMENT

STATESVILLE 704-878-5305 MOORESVILLE 704-664-5281

IMPROVEMENT PERMIT / AUTHORIZATION TO CONSTRUCT / OPERATION PERMIT / EXISTING SYSTEM INSPECTION

PERMIT# Repair PIN# Repair 4678 20 8883 DATE 6/1/99

OWNER OR CONTRACTOR ~~Baba~~ Marilyn Hinds PHONE: Business _____ Home (828) 478-9151

ADDRESS 3726 Waterview Terrell, NC 28682

LOCATION 765 Wiggins 150 E to Wiggins Rd ~ 3/4 Mile just past pond on right

SUBDIVISION N/A BLOCK / SECTION _____ LOT _____ LOT AREA ~2 acre SITE CLASS. PS DESIGN FLOW 360 L.T.A.R. _____

Septic Tank: Existing Gallons; STB _____ Date _____

Pump Tank: _____ Gallons; PT _____ Date _____

Pump Make: _____ Model _____ Serial No. _____

Nitrification Field: No Fields 1 Square Feet 1200' Linear Feet 400'

No Lines 4@100'eq Trench Width 36" Max Trench Bottom Depth 24" Gravel Depth 12"

☐ New System ☒ Repair System Type: I, II, III, IV, V, VI

System Description: Gravity Conventional

Repair System Description: _____

Maintenance Agreement Required: ☐ Yes ☒ No

☒ House/Mod. Home No. Bedrooms 3

☐ Mobile Home No. Bathrooms 2

☐ Business No. Employees _____

☐ Other _____

☐ Slab ☐ Crawl Space ☐ Basement w/plumbing ☒ Basement wo/plumbing


Water Supply: ☒ Individual ☐ Public ☐ Community

Comments:/Conditions: Must abandon Existing Washer Drainline & tie into New Septic System thru Septic Tank Okay to feather off old Berms. (If Installer runs into old drainline, shift New drainfield down hill.)

Comments:/Conditions: May use existing Septic Tank if Tank is in good condition, (No Cracks or leaks detected), Inspection will check Existing Septic Tank if it will be used.

Not to Scale

INITIAL SITE SKETCH Space 20' btw 2nd & 3rd Drainlines to avoid Old Drainline

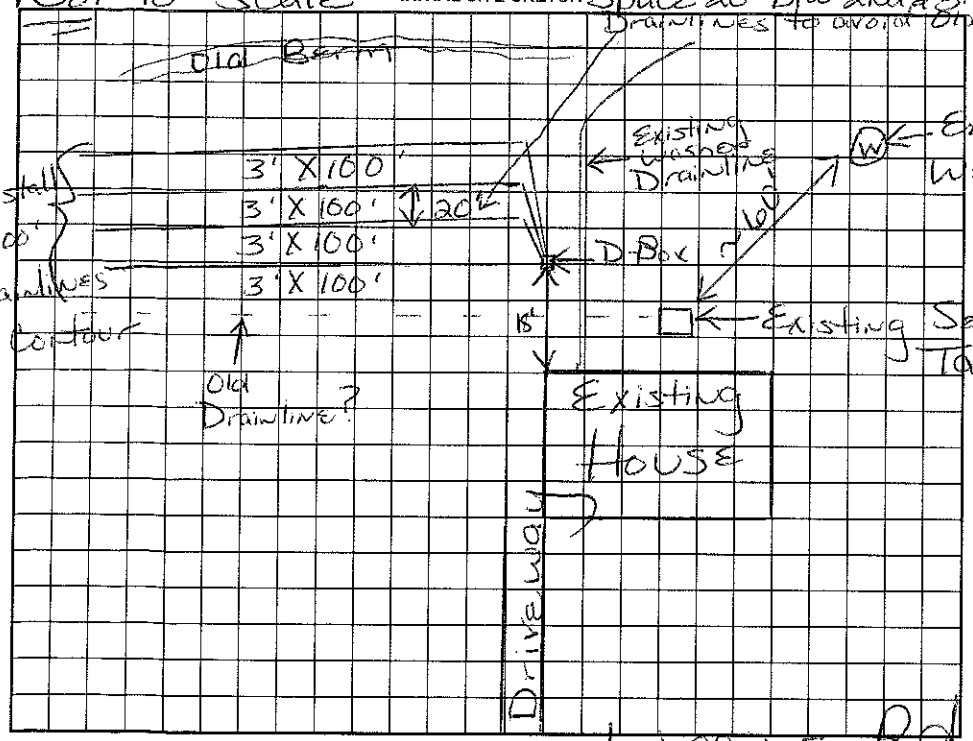

AS BUILT SKETCH

Permit can be suspended or revoked if any false information is supplied toward securing the permit/any unauthorized changes are made to the site/any unauthorized changes are made in the installation of the system. Improvement Permit with plat valid without expiration. Improvement Permit with site plan valid for sixty months. Authorization to Construct is valid for a period equal to that of Improvement Permit – not to exceed sixty months.

Signed: _____ date _____ Installed by: Richard Abernathy

Improvement Permit by: Marie H. Hudson RS date 6/1/99 Operation Permit by: _____ date 6/8/99

Authorization to Construct by: Marie H. Hudson RS date 6/1/99 Existing System Inspection by: _____ date _____

HEALTH DEPT. COPY: WHITE OWNER COPY (FINAL): YELLOW OWNER COPY (INITIAL): PINK