IREDELL COUNTY HEALTH DEPARTMENT

Statesville Office (704) 878-5305 Mooresville Office (704) 660-3625 PERMIT # 181067 4m

IMPROVEMENT PERMIT / AUTHORIZATION TO CONSTRUCT / OPERATION PERMIT / EXISTING SYSTEM

PIN # 4678-21-6410

APPLICANT: WILLIAM & SARY CROSHAW APPLICANT ADDRESS: 740 WIGGINS Rd ~ Mooresville

SITE ADDRESS: SAME PHONE: ALT. PHONE:

SITE DIRECTIONS: 150 E, TL WIGGINS, ON L


SUBDIVISION: BOBBY O. KELLER SECTION: — LOT # 2 LOT AREA: 7.465 AC DESIGN FLOW: 240 L.T.A.R.: .3

Septic Tank	1000 (gal)	STB	794	Date	10-17-16	☒ New System	☐ Repair	☐ Expansion	System Type: I II III IV V VI	☒ Residence	No. Bedrooms 2
Pump Tank	(gal)	PT		Date		System Description:		25% REDUCTION		☐ Business	No. Persons
Pump Make		Model		Serial #		Repair System Description:		SAME		☐ Other	No. Employees
# Nitrification Fields	1	# Lines	2@100'	Linear Ft:	200'	Maintenance Agreement Required:	☐ YES	☒ NO		☐ Slab	☒ Crawl Space
Trench Width	36"	Max. Trench Bottom Depth	36"	Gravel Depth			☒ GRAVITY	☐ PRESSURE		☒ Basement w/plumbing	☐ Basement w/o plumbing


Water Supply: ☒ Private ☐ Public ☐ Community

Comments / Conditions:

INITIAL SITE SKETCH

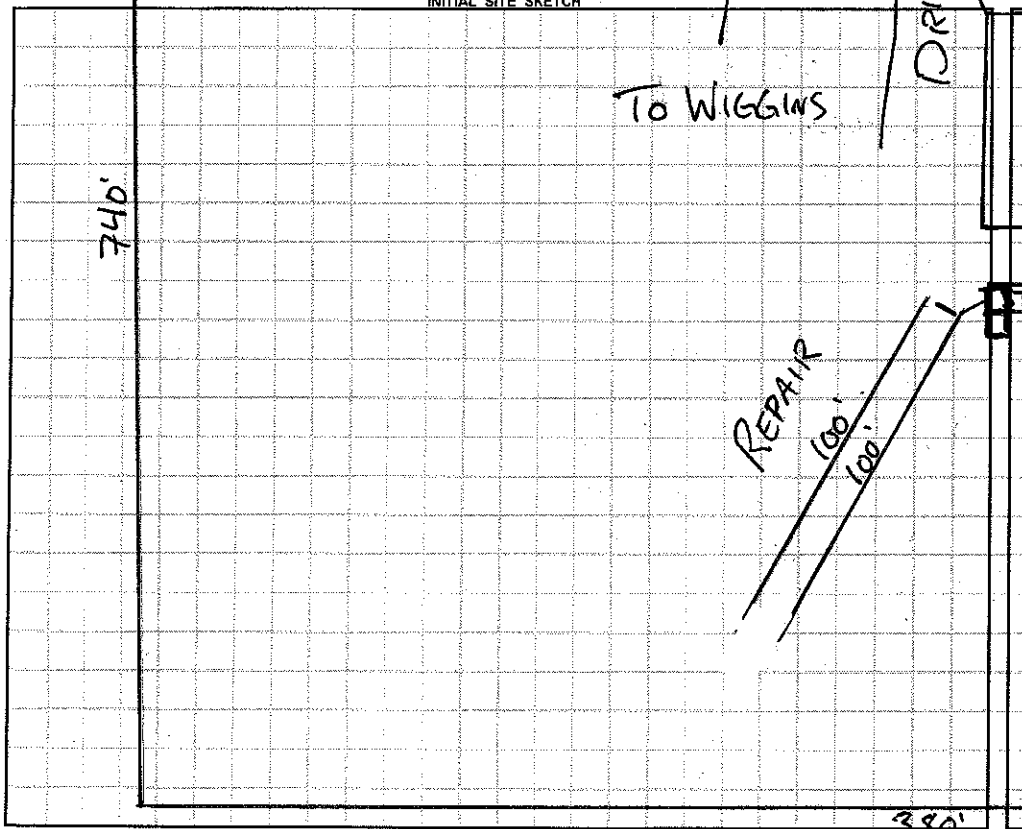

AS BUILT SKETCH

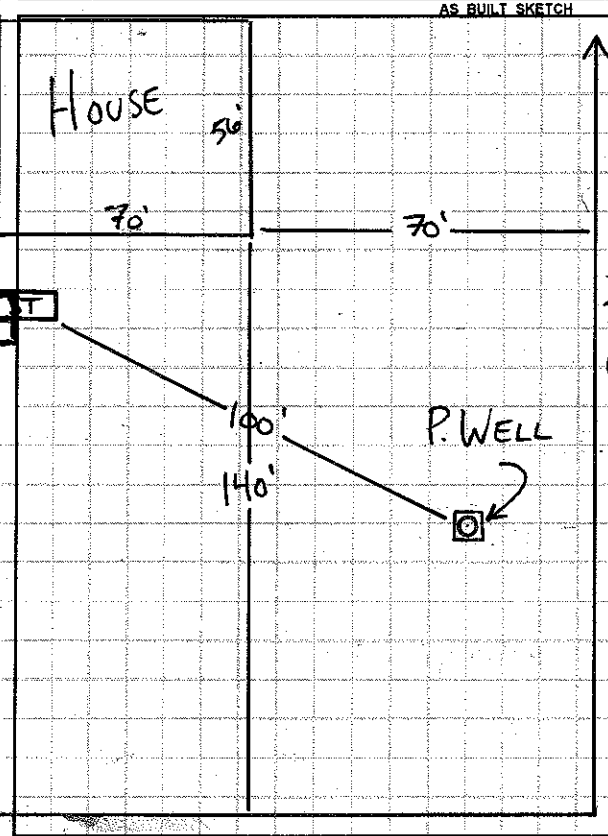

1" = 50'

* IF BASEMENT TANK MUST BE 25' FROM BACK OF HOUSE.
* IF GRINDER PUMP IS USED IN BASEMENT, 10' OF 4" PIPE MUST BE BETWEEN ST & HOUSE

Permit can be suspended or revoked if any false information is supplied toward securing the permit / any unauthorized changes are made to the site / any unauthorized changes are made in the installation of the system. **CONTACT A LOCATOR SERVICE PRIOR TO ANY EXCAVATION**

☐ **IMPROVEMENT PERMIT** *with plat valid without expiration.* ☒ **IMPROVEMENT PERMIT** *with site plan valid for 60 mos.* ☒ **AUTHORIZATION TO CONSTRUCT** *valid for period equal to IMPROVEMENT PERMIT--not to exceed 60 mo.*

Owner / Applicant Signature: W. Croshaw Date: 6-1-15 Installed by: LARRY BEAM

IMPROVEMENT PERMIT by: Date: 10-24-13 OPERATION PERMIT by: Date: 11-28-16

AUTHORIZATION TO CONSTRUCT by: APPROVED MAY 29 2015 Existing System Inspected by: Date:

Health Dept. Copy - WHITE Applicant (Final Approval) - YELLOW Applicant (Conditional Approval) - PINK