IREDELL COUNTY HEALTH DEPARTMENT

Authorization to Construct (2100) LARRY BEAM

STATESVILLE 704-878-5305 MOORESVILLE 704-664-5281

IMPROVEMENT PERMIT / ~~CERTIFICATE OF COMPLETION~~ / OPERATION PERMIT / EXISTING SYSTEM INSPECTION

PROPERTY DESCRIPTION NO. 23811 DATE 6/10/96 TAX MAP NO. 1N-A-141 Watershed: ☑ Yes ☐ No

OWNER OR CONTRACTOR Bobby Keller PHONE: Business 467 821 6910 Home 664-1851

ADDRESS PO Box 1682 Mooresville NC 28115

LOCATION Hwy 150 E - TL Wiggins Rd - ½ mile on left

SUBDIVISION — BLOCK / SECTION — LOT — LOT AREA ≈10ac SITE CLASS. PS DESIGN FLOW 360gal L.T.A.R. .13gpd/ft²

Septic Tank: 1000 Gallons; STB 744 Date 2/16/97

Pump Tank: ____ Gallons; PT ____ Date ____

Pump Make: ____ Model ____ Serial No. ____

Nitrification Field: No Fields 1 Square Feet 1200 Linear Feet 400

No Lines 4 Trench Width 36" Max Trench Bottom Depth 36" Gravel Depth ~~12"~~ 12"

☑ New System ☐ Repair System Type: I (II) III, IV, V, VI

System Description: Gravity Conv.

Repair System Description: Same

Maintenance Agreement Required: ☐ Yes ☑ No

☑ House/Mod. Home No. Bedrooms 3

☐ Mobile Home No. Bathrooms 2

☐ Business No. Employees ____

☐ Other ____

☐ Slab ☑ Crawl Space ☐ Basement w/plumbing ☐ Basement wo/plumbing


Water Supply: ☑ Individual ☐ Community ☐ Public

Comments: More addition line may be added at owners request.

(Not To Scale)

Comments: TANKS & LINE CHANGED TO SIDE OF HOUSE at 133' Lines. 4/1/97 GB

INITIAL SITE SKETCH

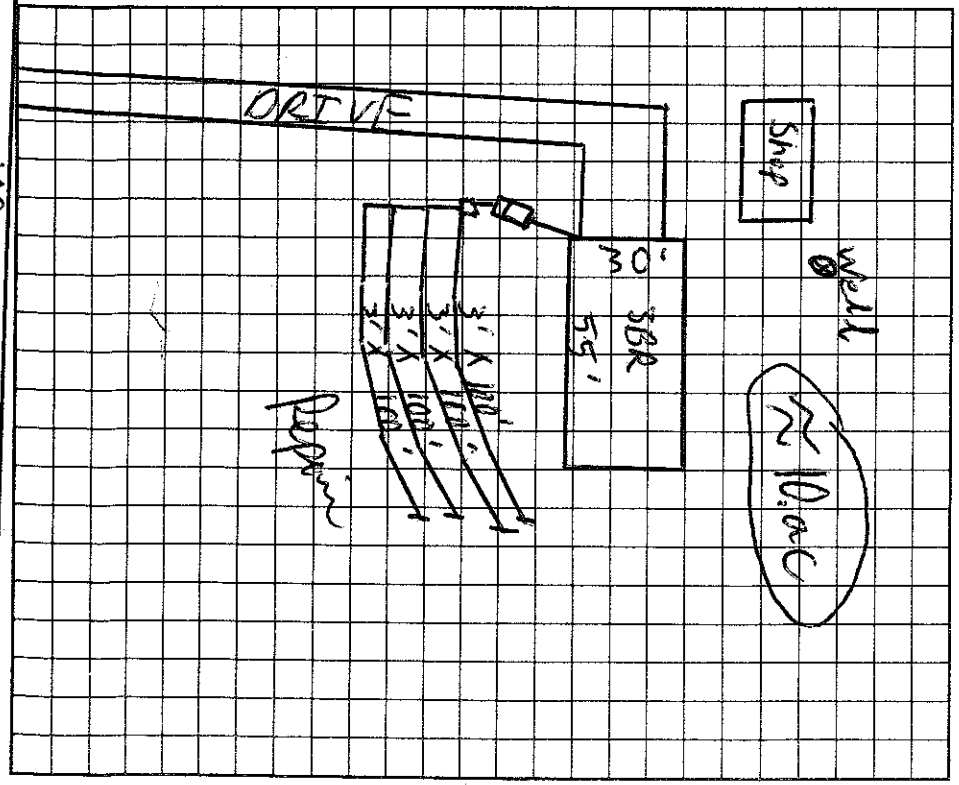

AS BUILT SKETCH

I understand that this permit can be suspended or revoked if any false information is supplied toward securing the permit/any unauthorized changes are made to the site/any unauthorized changes are made in the installation of the system.

Signed: Bobby G. Keller

Improvement Permit by: C. Baby Frazier EHSI date 6/10/96

Authorization to Construct ~~Existing System Inspection by:~~ C. Baby Frazier EHSI date 6/10/96

Installed by: Larry Beam

Certificate of Completion by: Wesley Sparks RS date 4/18/97

Operation Permit by: Wesley Sparks RS. date 4/18/97

HEALTH DEPT. COPY: WHITE INSPECTION COPY (FINAL): GREEN OWNER COPY (FINAL): YELLOW INSPECTION COPY (INITIAL): PINK OWNER COPY (INITIAL): GOLD

Authorization to Construct is valid for 60 months from issue date.