IREDELL COUNTY HEALTH DEPARTMENT

Statesville Office (704) 878-5305 Mooresville Office (704) 660-3625 PERMIT # Repair

IMPROVEMENT PERMIT / AUTHORIZATION TO CONSTRUCT / OPERATION PERMIT / EXISTING SYSTEM

PIN # 4678430379

APPLICANT: Kenny Seamon for Vicky Seamon APPLICANT ADDRESS: 115 Honey Boy Ln Mooresville, NC 28115

SITE ADDRESS: 115 Honey Boy Ln. Mooresville, NC PHONE: 704 663- ALT. PHONE: 704 663 0474

SITE DIRECTIONS: Main St N Cross Hwy 150 to Wiggins Rd ~ 1 mile 2816 on right TR Honey Boy Ln

SUBDIVISION: SECTION: LOT # LOT AREA: DESIGN FLOW: 360gpd L.T.A.R.: .8


Septic Tank	1000 (gal)	STB	794	Date	3/10/13	☐ New System	☒ Repair	☐ Expansion	System Type: I II (III) IV V VI
Pump Tank	(gal)	PT		Date		System Description:	Gravity Convent.		
Pump Make		Model		Serial #		Repair System Description:	Gravity - 25% Reduction		
# Nitrification Fields	1	# Lines	3	Linear Ft:	300Ft	Maintenance Agreement Required:	☐ YES	☒ NO	
Trench Width	36"	Max. Trench Bottom Depth	36"	Gravel Depth	N/A	☒ GRAVITY	☐ PRESSURE		

☒ Residence	No. Bedrooms	3	**Water Supply**	
☐ Business	No. Persons		☒ Private	
☐ Other	No. Employees		☐ Public	
☐ Slab	☒ Crawl Space		☐ Community	
☐ Basement w/plumbing			☐ Basement w/o plumbing	


Comments / Conditions: Abandon old Septic Tank & install new one in front of fence. Keep Septic System 10ft from PL & 50-100ft from Well

Use Serial distribution, install below large trees

INITIAL SITE SKETCH

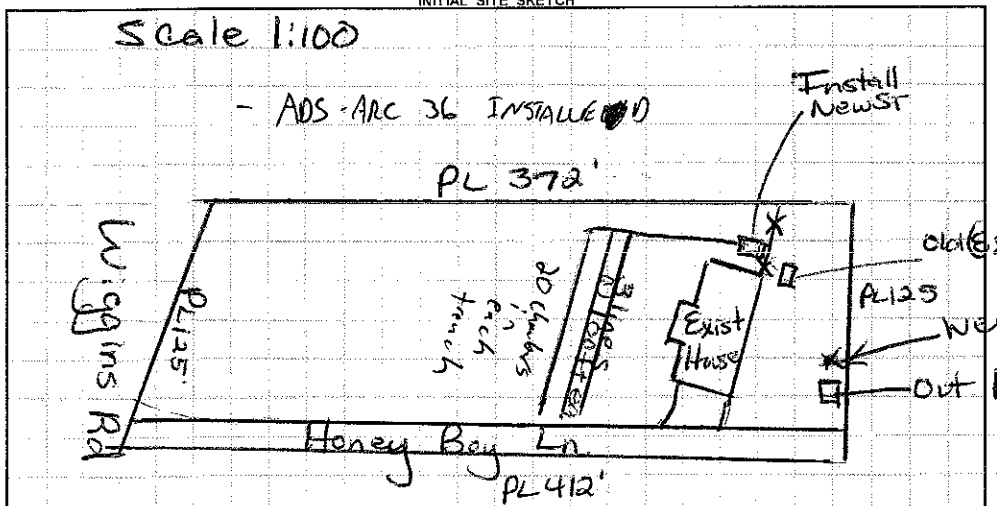

AS BUILT SKETCH

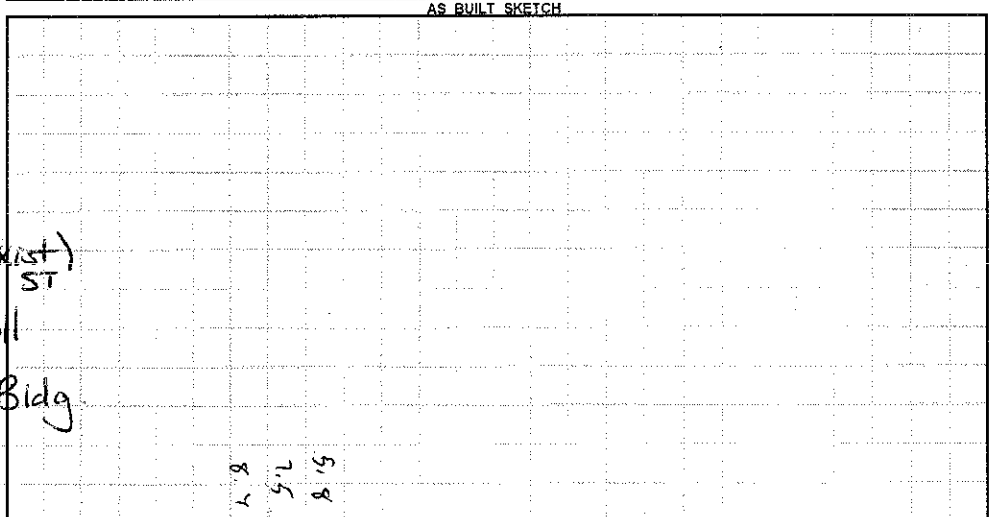

Permit can be suspended or revoked if any false information is supplied toward securing the permit / any unauthorized changes are made to the site / any unauthorized changes are made in the installation of the system. **CONTACT A LOCATOR SERVICE PRIOR TO ANY EXCAVATION**

☐ **IMPROVEMENT PERMIT** *with plat valid without expiration.* ☐ **IMPROVEMENT PERMIT** *with site plan valid for 60 mos.* ☐ **AUTHORIZATION TO CONSTRUCT** *valid for period equal to IMPROVEMENT PERMIT--not to exceed 60 mo.*

Owner / Applicant Signature: Vicky D. Seamon Date: 4/12/13 Installed by: L. E. BEAM

IMPROVEMENT PERMIT by: Date: 4/12/13 OPERATION PERMIT by: Date: 4/17/13

AUTHORIZATION TO CONSTRUCT by: Date: 4/12/13 Existing System Inspected by: Date:

Health Dept. Copy - WHITE Applicant (Final Approval) - YELLOW Applicant (Conditional Approval) - PINK