2180 AHP

IREDELL COUNTY HEALTH DEPARTMENT

Statesville Office (704) 878-5305 Mooresville Office (704) 660-3625 PERMIT # 20772 ✓

IMPROVEMENT PERMIT / AUTHORIZATION TO CONSTRUCT / OPERATION PERMIT / EXISTING SYSTEM

PIN # 4678-44-3579 ✓

APPLICANT: 10 Homes APPLICANT ADDRESS: 840 Edmonston Rd.

SITE ADDRESS: ✓568 Wiggins Rd. PHONE: 704-400-6472 ALT. PHONE:

SITE DIRECTIONS: 150 W, TR Wiggins, on L

SUBDIVISION: Meadows Farm SECTION: LOT # 2 LOT AREA: 1 AC DESIGN FLOW: 480 L.T.A.R.: .3

Septic Tank 1000 (gal) STB 828 Date 1-8-15
Pump Tank (gal) PT Date
Pump Make Model Serial #
Nitrification Fields 1 # Lines 4 Linear Ft: 400'
Trench Width 36" ~~Max~~ Trench Bottom Depth 24" - 36" Gravel Depth —

☒ New System ☐ Repair ☐ Expansion System Type: I II (III) IV V VI
System Description: 25% Reduction
Repair System Description: Panel Block
Maintenance Agreement Required: ☐ YES ☒ NO
☒ GRAVITY ☐ PRESSURE

☒ Residence No. Bedrooms 4
☐ Business No. Persons
☐ Other No. Employees
☒ Slab ☐ Crawl Space
☐ Basement w/plumbing ☐ Basement w/o plumbing

Water Supply: ☒ Private ☐ Public ☐ Community

Comments / Conditions: * Must be Min 100' From Wells *
* Wells (2) must be abandoned before AC can be issued

Installed Quick 4 as Drawn

INITIAL SITE SKETCH

See Plan From Michael Athanas & Associates

AS BUILT SKETCH

Permit can be suspended or revoked if any false information is supplied toward securing the permit / any unauthorized changes are made to the site / any unauthorized changes are made in the installation of the system. **CONTACT A LOCATOR SERVICE PRIOR TO ANY EXCAVATION**

☐ **IMPROVEMENT PERMIT** *with plat valid without expiration.* ☒ **IMPROVEMENT PERMIT** *with site plan valid for 60 mos.* ☑ **AUTHORIZATION TO CONSTRUCT** *valid for period equal to IMPROVEMENT PERMIT--not to exceed 60 mo.*

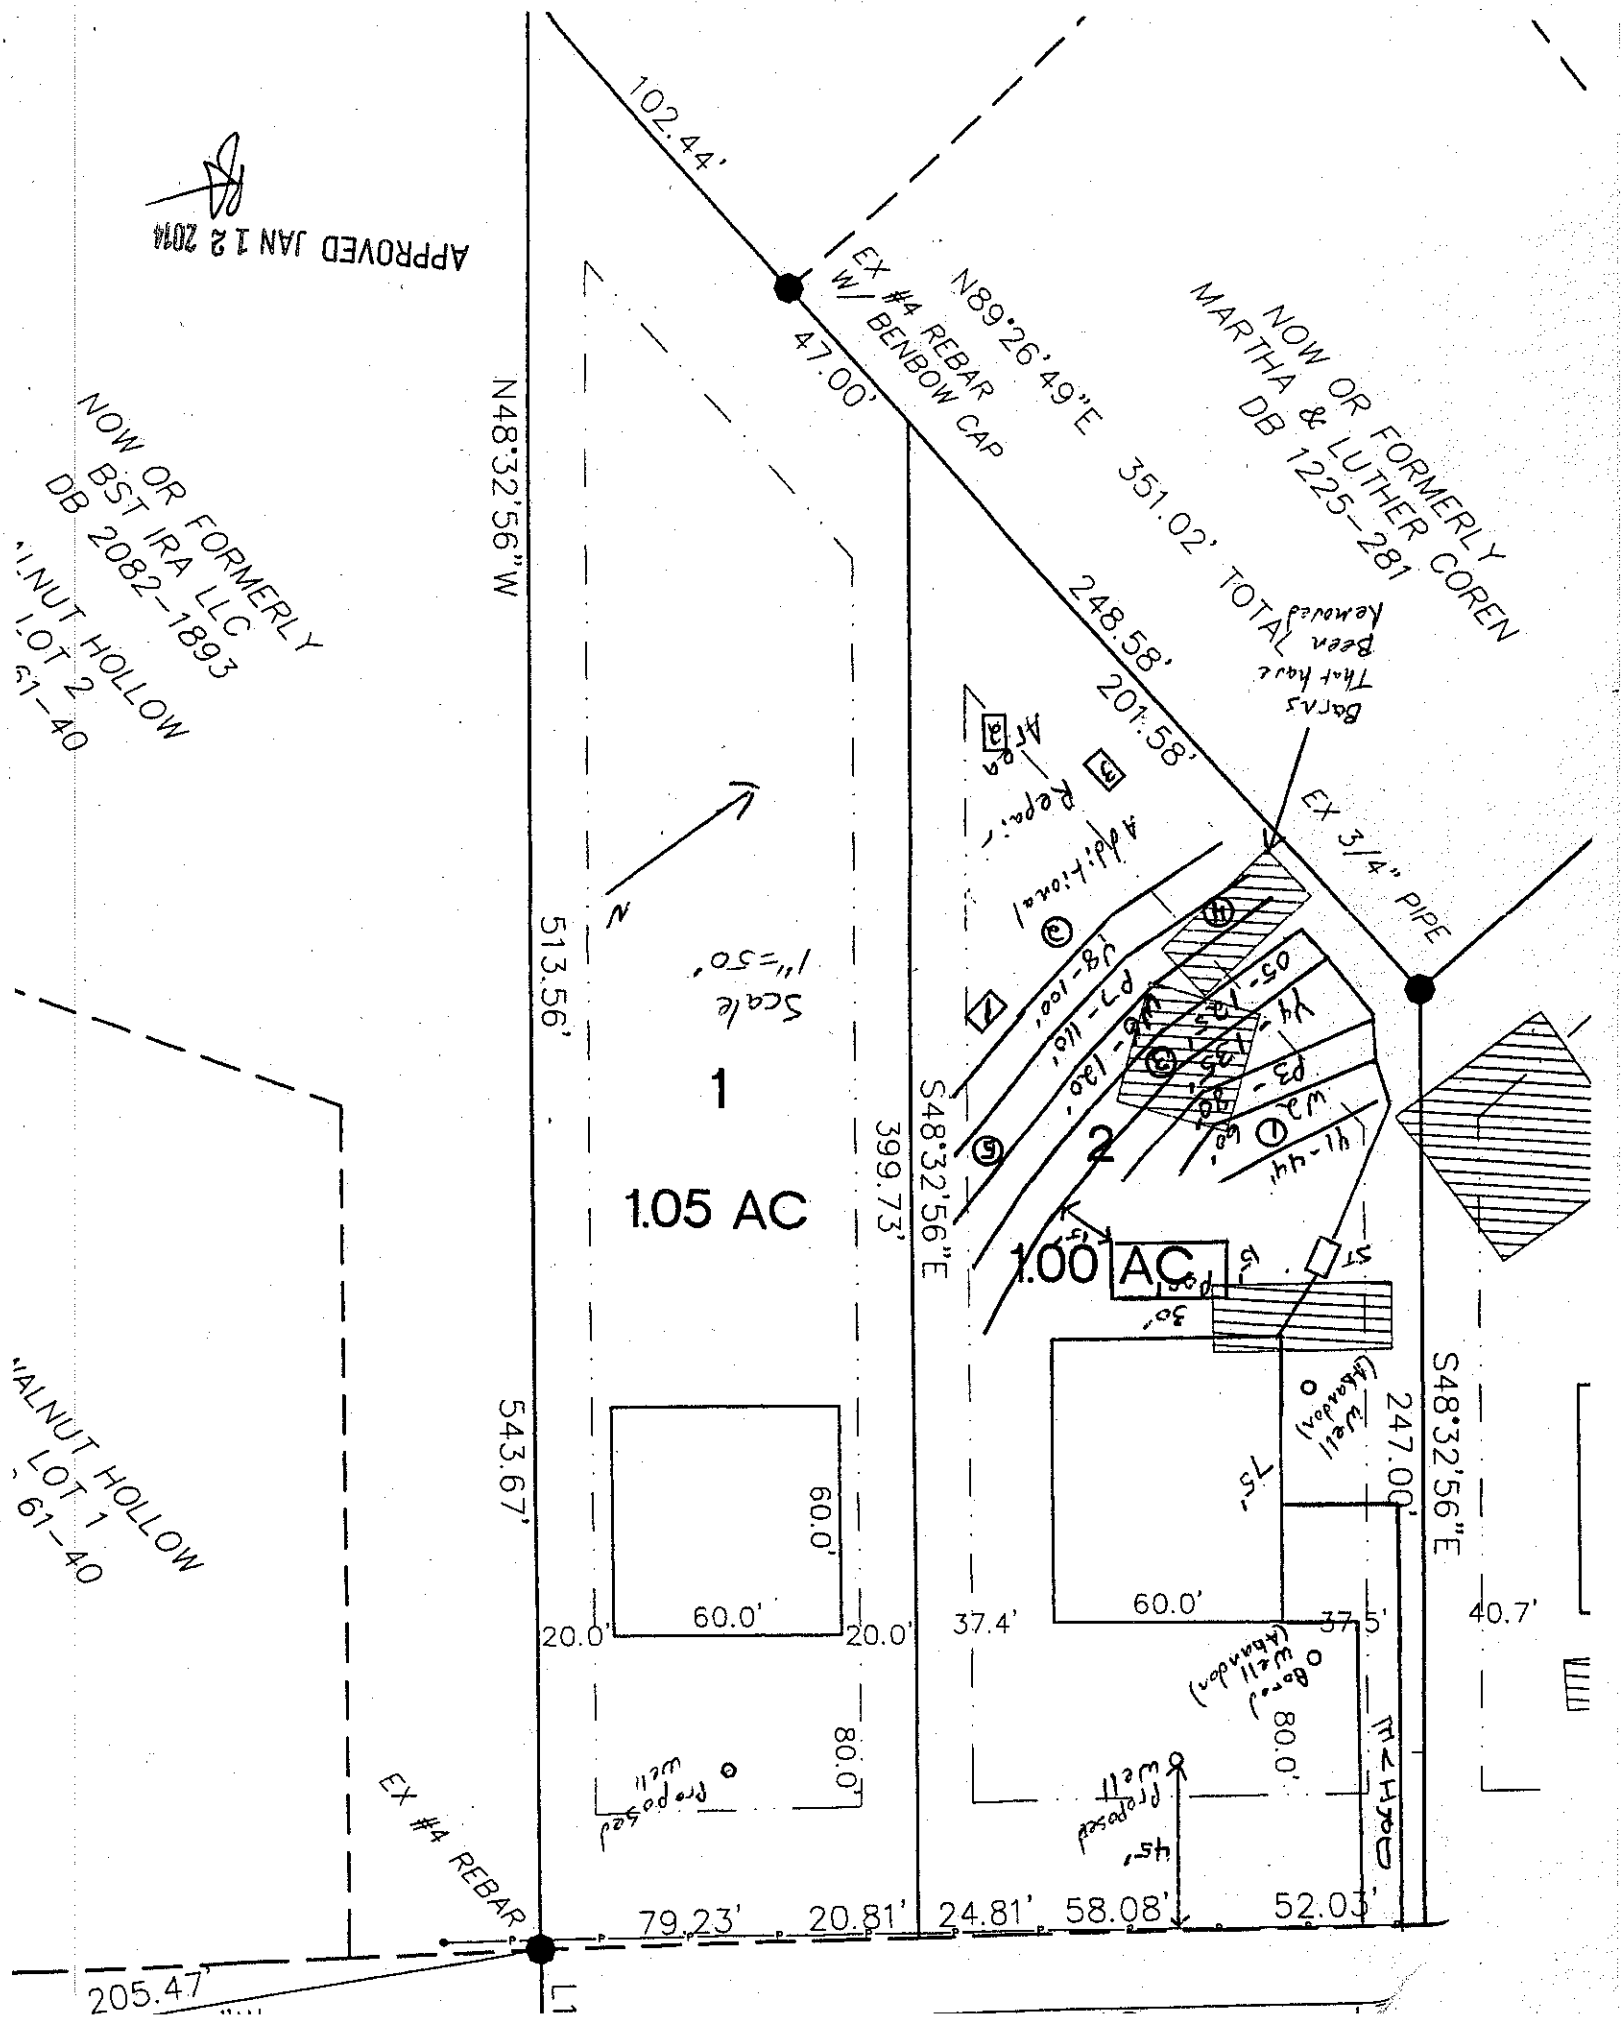
Owner / Applicant Signature: Date: 1/14/15 Installed by: Rowan Septic

IMPROVEMENT PERMIT by: APPROVED Date: JAN 12 2014 OPERATION PERMIT by: Main Hill Dobson RS Date: 5/26/15

AUTHORIZATION TO CONSTRUCT by: Richard James Date: ~~1/15/15~~ Existing System Inspected by: Date:

Health Dept. Copy - WHITE Applicant (Final Approval) - YELLOW Applicant (Conditional Approval) - PINK

2-2-15


APPROVED JAN 12 2014
102.44'
EX #4 REBAR W/ BENBOW CAP
47.00'
N89°26'49"E 351.02' TOTAL
248.58'
201.58'
NOW OR FORMERLY MARTHA & LUTHER COREN DB 1225-281
NOW OR FORMERLY BST IRA LLC DB 2082-1893
WALNUT HOLLOW LOT 2 61-40
N48°32'56"W
513.56'
EX 3/4" PIPE
Scale 1"=50'
1
1.05 AC
2
1.00 AC
S48°32'56"E
399.73'
543.67'
247.00'
S48°32'56"E
WALNUT HOLLOW LOT 1 61-40
60.0'
60.0'
20.0'
20.0'
80.0'
37.4'
60.0'
37.5'
40.7'
80.0'
EX #4 REBAR
79.23'
20.81'
24.81'
58.08'
52.03'
205.47'
L1