IREDELL COUNTY HEALTH DEPARTMENT

Statesville Office (704) 878-5305 | Mooresville Office (704) 660-3625 | PERMIT # 216151

IMPROVEMENT PERMIT / AUTHORIZATION TO CONSTRUCT / OPERATION PERMIT / EXISTING SYSTEM

PIN # 4678-44-3579

APPLICANT: IQ Custom Construction | APPLICANT ADDRESS: Not Provided

SITE ADDRESS: 568 Wiggins Rd. Mooresville, NC | PHONE: Not Provided | ALT. PHONE:

SITE DIRECTIONS: Highway 150 East → Left on Wiggins Rd → house on left

SUBDIVISION: Meadows Farm | SECTION: – | LOT # 2 | LOT AREA: 1.00 acres | DESIGN FLOW: 480 gal/day | L.T.A.R.: 0.3

Septic Tank ____ (gal) STB ____ Date ____
Pump Tank ____ (gal) PT ____ Date ____
Pump Make ____ Model ____ Serial # ____
Nitrification Fields EXISTING # Lines ____ Linear Ft: ____
Trench Width ____ Max. Trench Bottom Depth ____ Gravel Depth ____

☐ New System ☐ Repair ☐ Expansion System Type: I (II) III IV V VI
System Description: Existing
Repair System Description: Existing
Maintenance Agreement Required: ☐ YES ☒ NO
☒ GRAVITY ☐ PRESSURE

☐ Residence No. Bedrooms 4
☐ Business No. Persons 8
☐ Other No. Employees ____
☒ Slab ☐ Crawl Space
☐ Basement w/plumbing ☐ Basement w/o plumbing

Water Supply
☒ Private
☐ Public
☐ Community

Comments / Conditions: Proposed 20'x30' garage addition will not have plumbing fixtures or additional bedrooms. It is recommended that the existing septic tank be pumped every 3-5 years and the 4 house downspout roof drains in the rear yard be directed away from the sewage disposal system. Any deviation in the size or location of the improvement voids this document.

INITIAL SITE SKETCH

See attached design/plat from Kathleen Saunders of The Oaks Group (approved 1-26-16)

AS BUILT SKETCH

Permit can be suspended or revoked if any false information is supplied toward securing the permit / any unauthorized changes are made to the site / any unauthorized changes are made in the installation of the system. **CONTACT A LOCATOR SERVICE PRIOR TO ANY EXCAVATION**

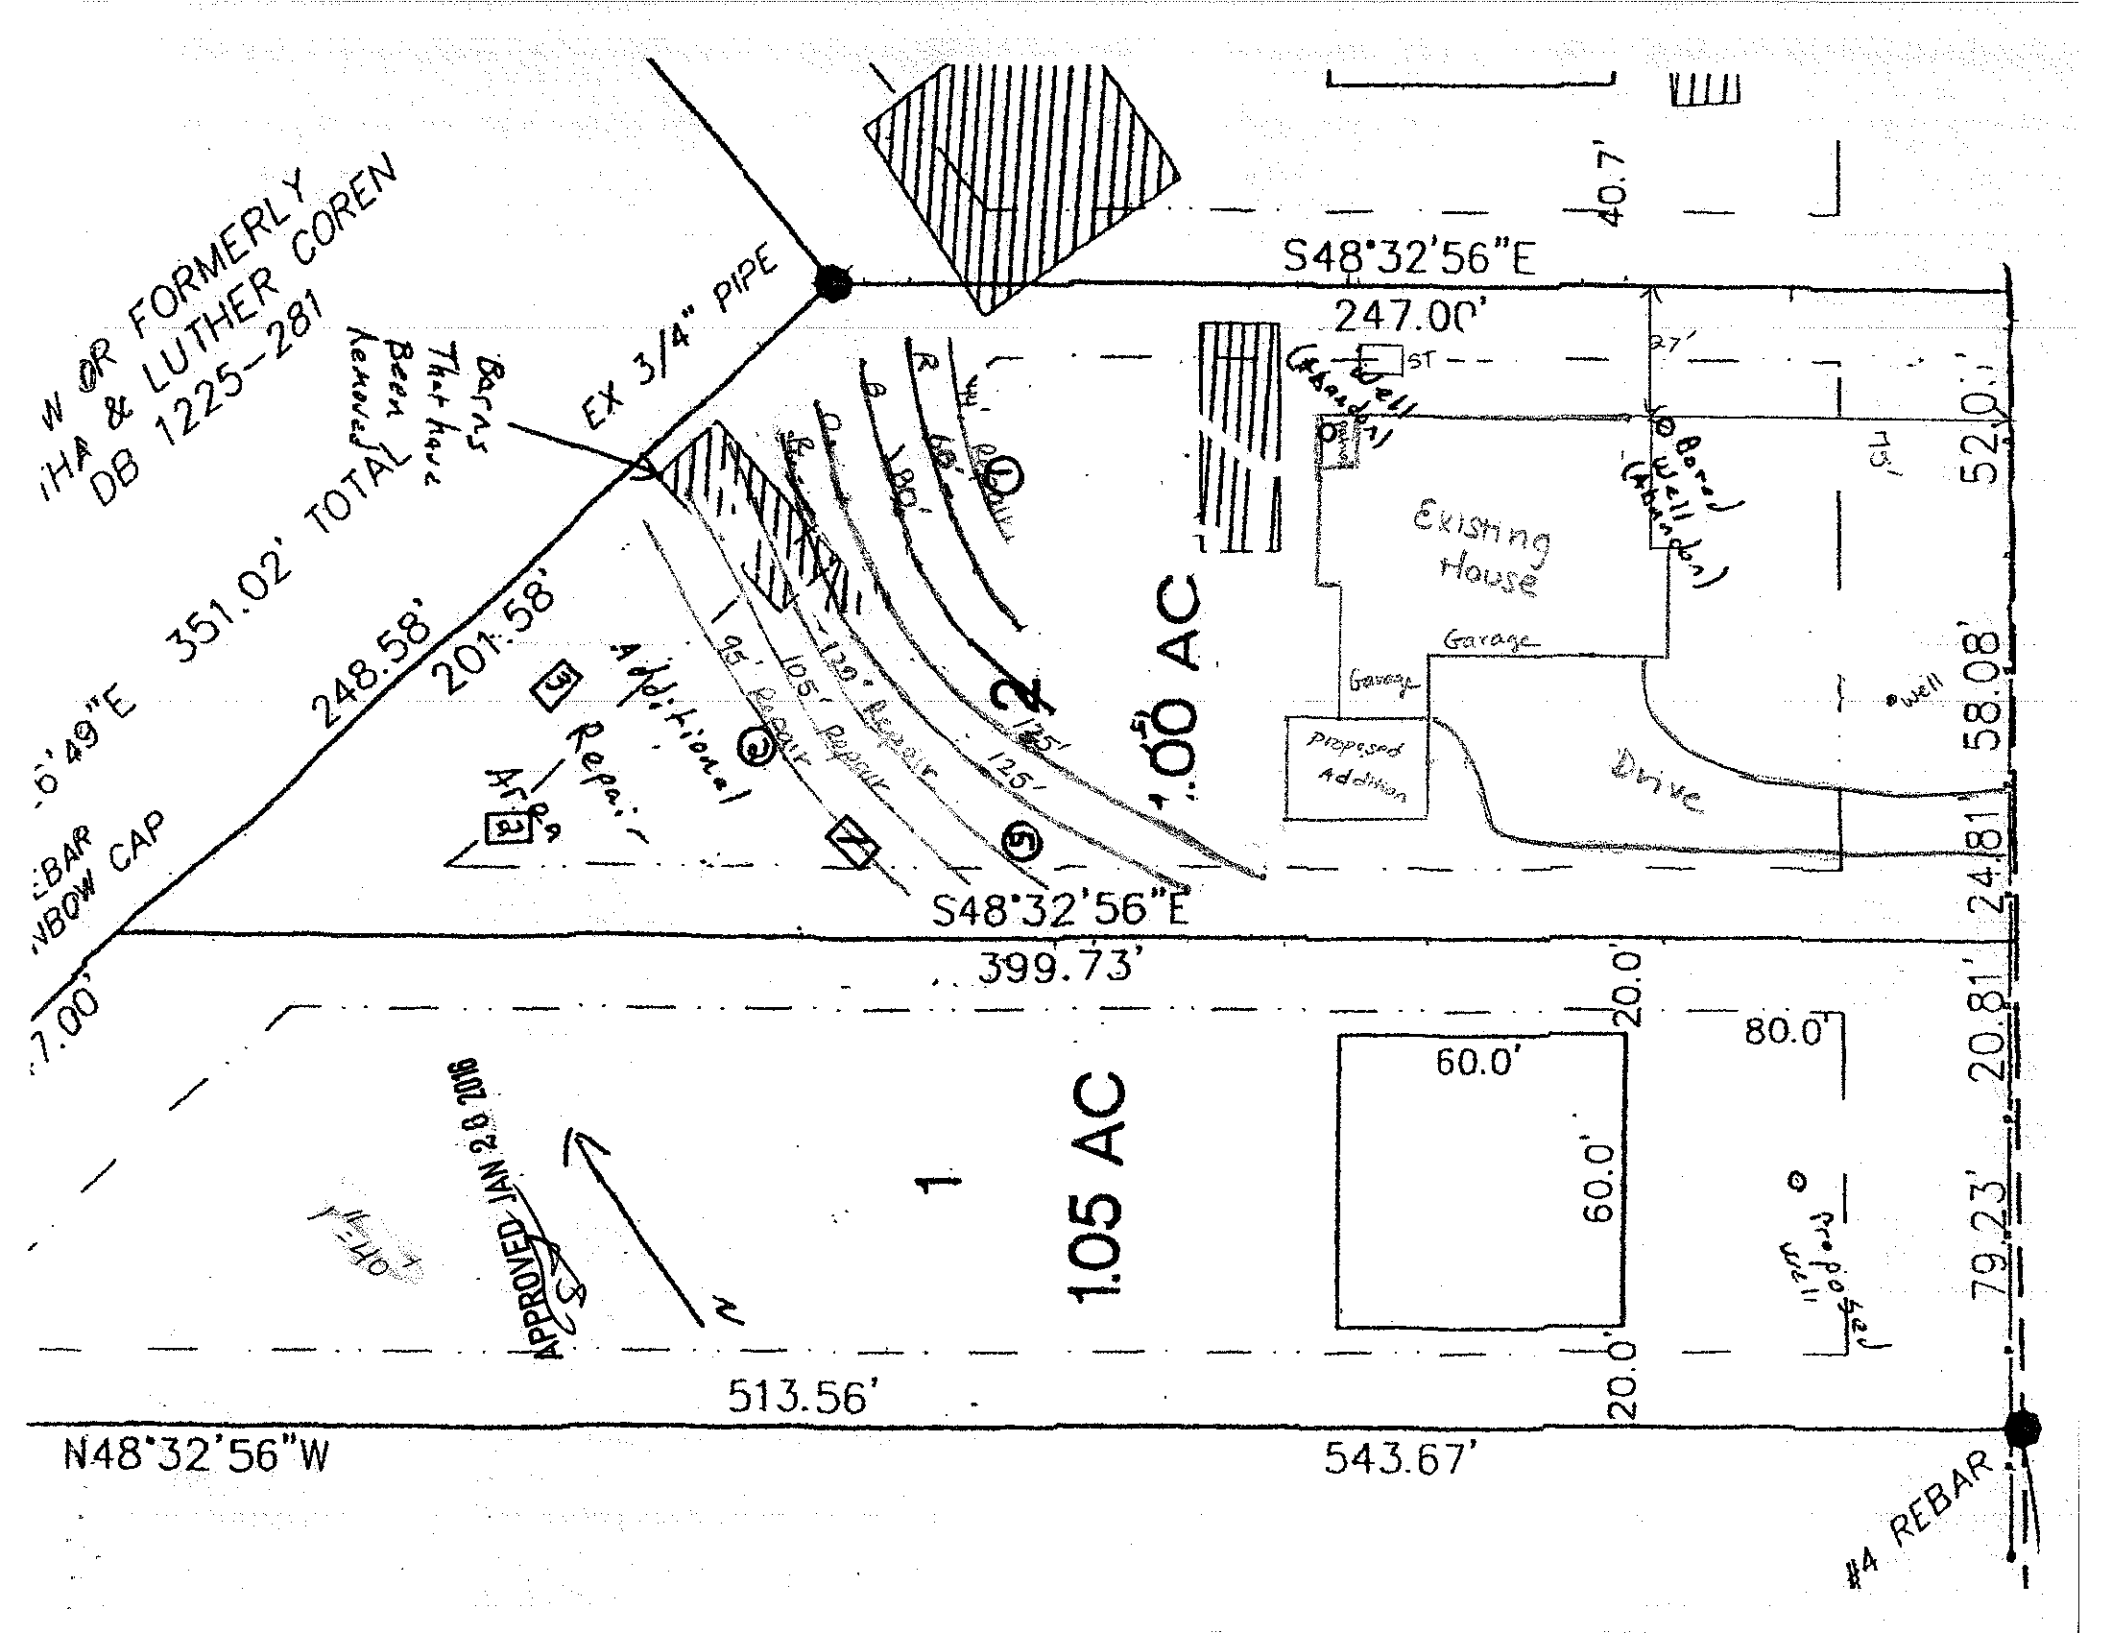
☐ **IMPROVEMENT PERMIT** *with plat valid without expiration.* ☐ **IMPROVEMENT PERMIT** *with site plan valid for 60 mos.* ☐ **AUTHORIZATION TO CONSTRUCT** *valid for period equal to IMPROVEMENT PERMIT--not to exceed 60 mo.*

Owner / Applicant Signature: [signature] Date: 2/1/16 | Installed by: ____

IMPROVEMENT PERMIT by: ____ Date: ____ | OPERATION PERMIT by: ____ Date: ____

AUTHORIZATION TO CONSTRUCT by: ____ Date: ____ | Existing System Inspected by: Tom Shuck Date: 1-27-16

Health Dept. Copy - WHITE Applicant (Final Approval) - YELLOW Applicant (Conditional Approval) - PINK


W OR FORMERLY
IHA & LUTHER COREN
DB 1225-281
EX 3/4" PIPE
Barns That have Been Removed
351.02' TOTAL
248.58'
201.58'
S48°32'56"E
247.00'
40.7'
52.0'
58.08'
24.81'
20.81'
79.23'
Existing House
Garage
Garage
Proposed Addition
Drive
Well
Abandoned Well
Proposed Well
Additional Repair
95' Repair
105' Repair
130' Repair
125'
125'
1.00 AC
1.05 AC
1
2
S48°32'56"E
399.73'
60.0'
60.0'
80.0'
20.0'
20.0'
513.56'
N48°32'56"W
543.67'
#4 REBAR
APPROVED JAN 2 8 2016