IREDELL COUNTY HEALTH DEPARTMENT

Statesville Office (704) 878-5305 Mooresville Office (704) 660-3625

AZP 2-21-15

PERMIT # 706338

IMPROVEMENT PERMIT / AUTHORIZATION TO CONSTRUCT / OPERATION PERMIT / EXISTING SYSTEM

PIN # 4678-45-9135

APPLICANT: IQ Custom Construction APPLICANT ADDRESS: 840 Edmiston Rd.

SITE ADDRESS: 536 Wiggins Rd. PHONE: 704-576-3887 ALT. PHONE:

SITE DIRECTIONS: 150 E, TL Wiggins, on L

SUBDIVISION: Meadows Farm SECTION: LOT # 8 LOT AREA: ~1 AC DESIGN FLOW: 480 L.T.A.R.: .3

Septic Tank 1600 (gal) STB 825 Date 12-3-14

Pump Tank (gal) PT Date

Pump Make Model Serial #

Nitrification Fields 1 # Lines 7 Linear Ft: 400'

Trench Width 36" Max. Trench Bottom Depth 24" Gravel Depth

☒ New System ☐ Repair ☐ Expansion System Type: I II (III) IV V VI

System Description: 25% Red. Panel Block

Repair System Description:

Maintenance Agreement Required: ☐ YES ☒ NO

☒ GRAVITY ☐ PRESSURE

☒ Residence ☐ Business ☐ Other ☐ Slab ☒ Crawl Space ☐ Basement w/plumbing ☐ Basement w/o plumbing

No. Bedrooms 4 No. Persons No. Employees

Water Supply: ☒ Private ☐ Public ☐ Community

Comments / Conditions: Installed Quick 4, essentially as drawn.

15, 19, 16, 15, 12, 11 & 9 Chambers per line

INITIAL SITE SKETCH

See Attached Plan

By

Michael Athanas

&

Associates

APPROVED OCT 17 2014

AS BUILT SKETCH

Permit can be suspended or revoked if any false information is supplied toward securing the permit / any unauthorized changes are made to the site / any unauthorized changes are made in the installation of the system. **CONTACT A LOCATOR SERVICE PRIOR TO ANY EXCAVATION**

☐ **IMPROVEMENT PERMIT** *with plat valid without expiration.* ☒ **IMPROVEMENT PERMIT** *with site plan valid for 60 mos.* ☐ **AUTHORIZATION TO CONSTRUCT** *valid for period equal to IMPROVEMENT PERMIT--not to exceed 60 mo.*

Owner / Applicant Signature: Date: 10/27/14

Installed by: Rowan Septic

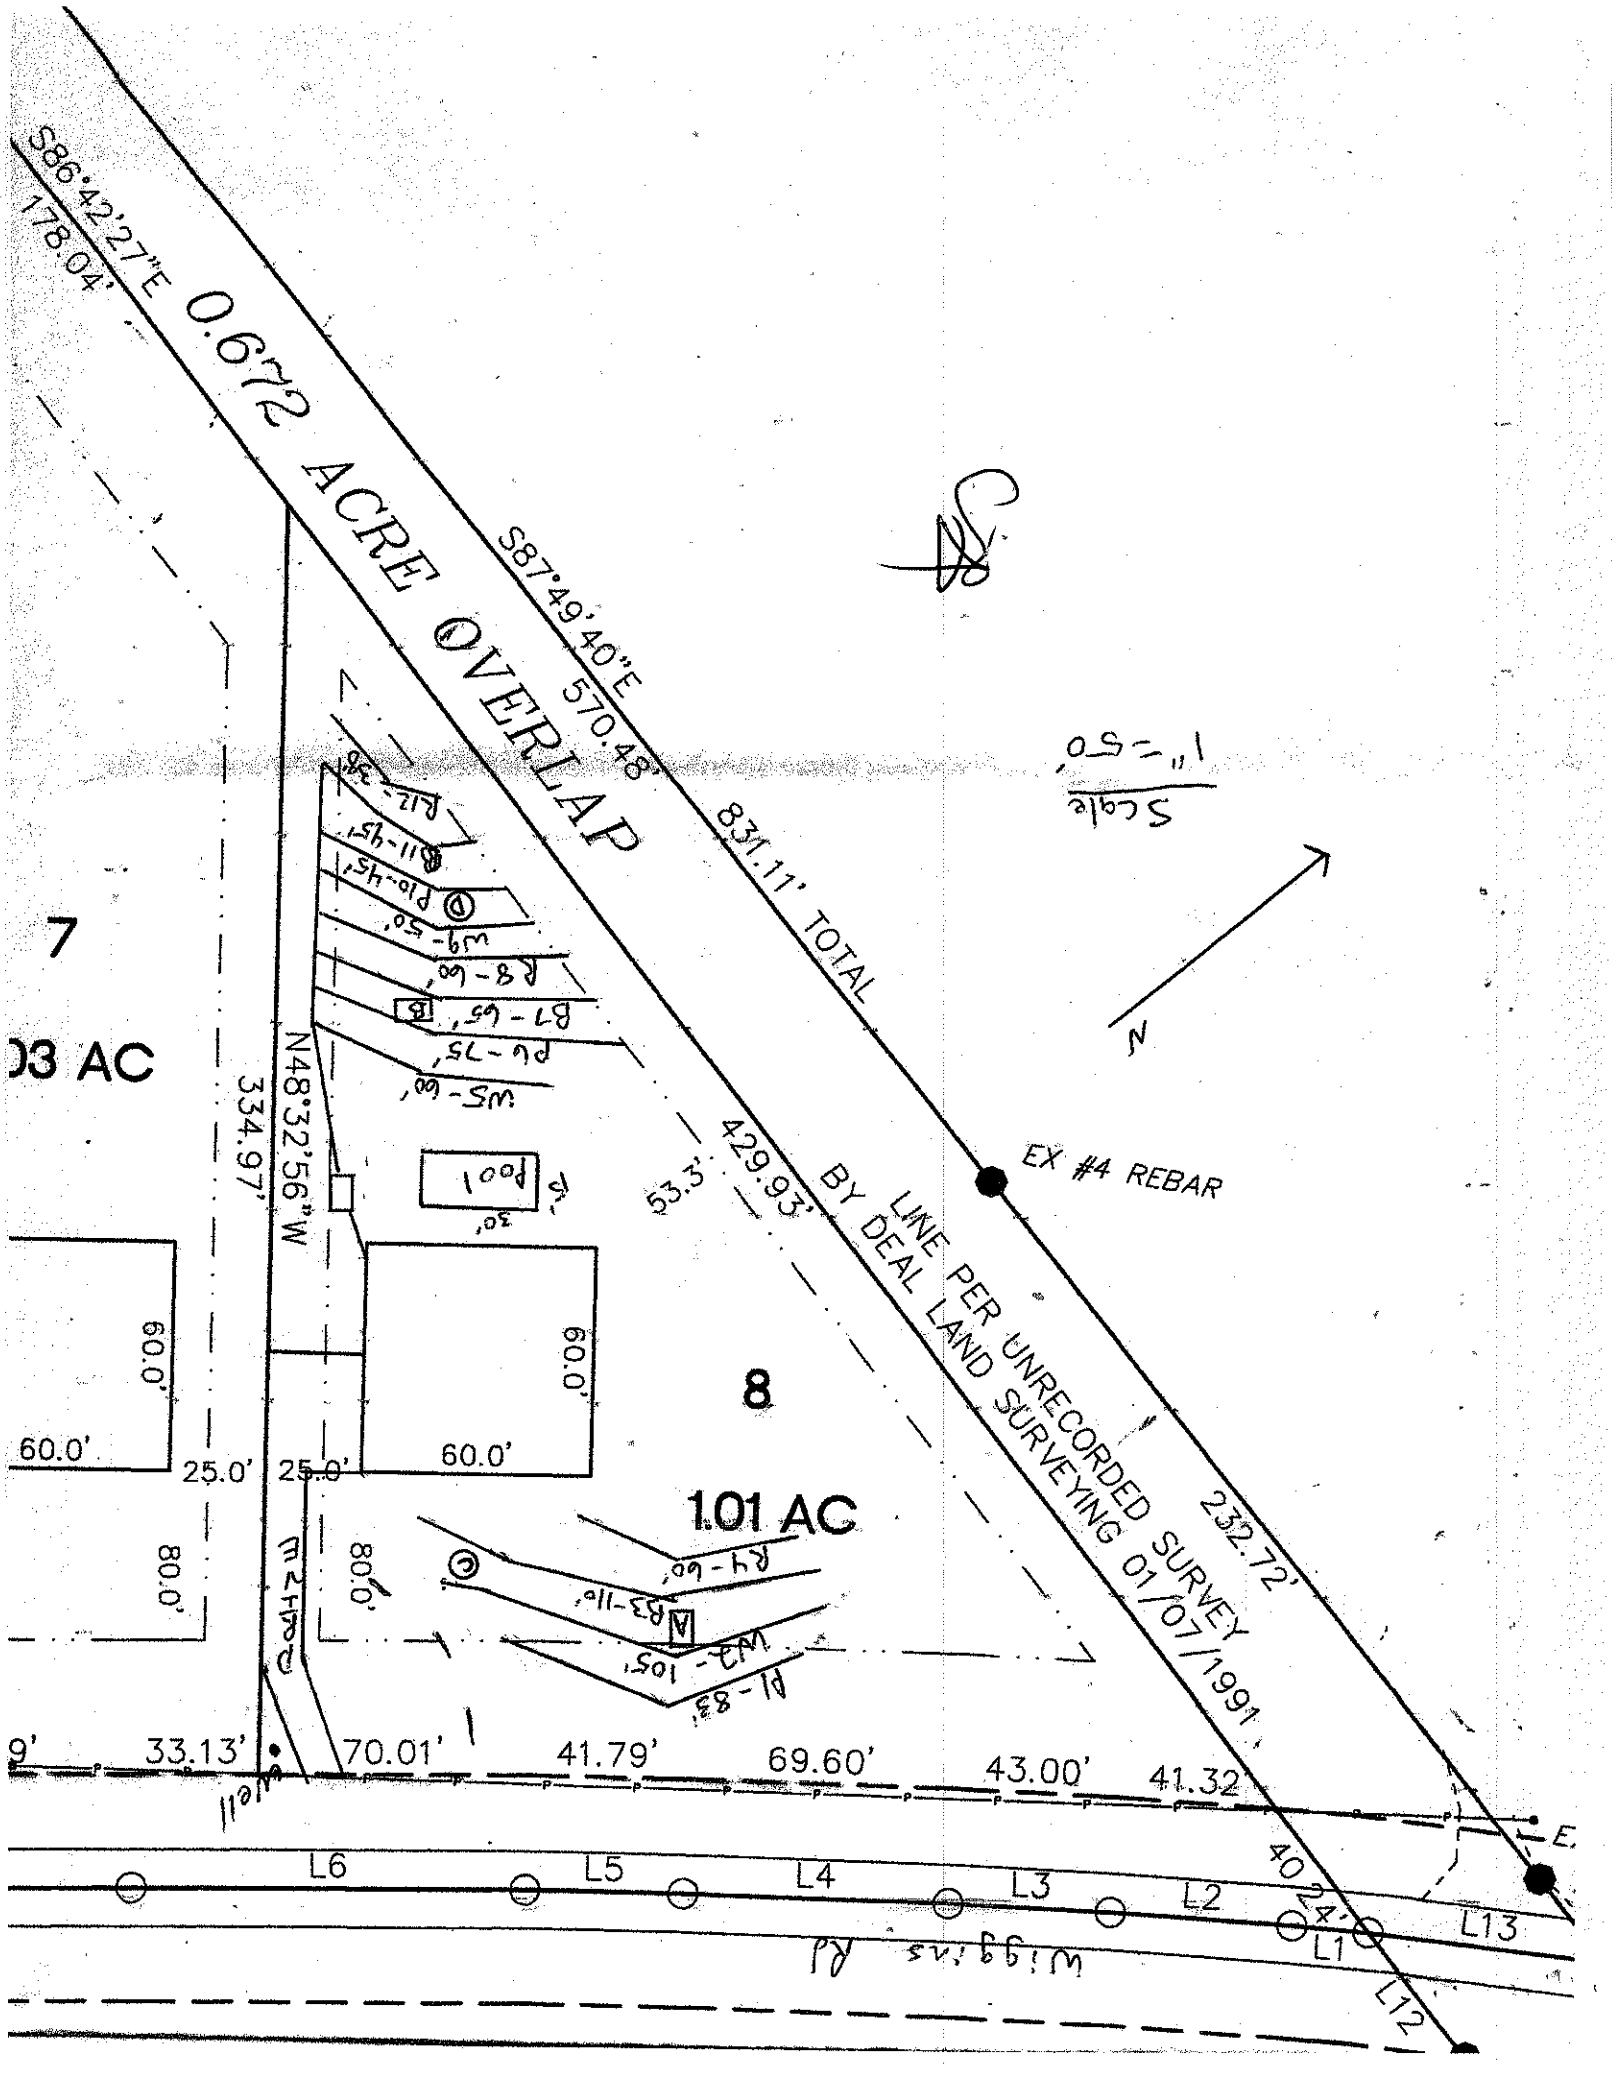
IMPROVEMENT PERMIT by: APPROVED Date: OCT 17 2014

OPERATION PERMIT by: Maria A. Dotson RS Date: 1/21/15

AUTHORIZATION TO CONSTRUCT by: Richard Garris for Ben Aldridge Date: 10/27/14

Existing System Inspected by: Date:

Health Dept. Copy - WHITE Applicant (Final Approval) - YELLOW Applicant (Conditional Approval) - PINK


S86°42'27"E 178.04'
0.672 ACRE OVERLAP
S87°49'40"E 570.48'
831.11' TOTAL
LINE PER UNRECORDED SURVEY BY DEAL LAND SURVEYING 01/07/1991
232.72'
429.93'
53.3'
EX #4 REBAR
N48°32'56"W 334.97'
7
03 AC
8
1.01 AC
60.0'
25.0'
80.0'
33.13'
70.01'
41.79'
69.60'
43.00'
41.32'
40.24'
L1
L2
L3
L4
L5
L6
L12
L13
N
Scale 1" = 50'