4678554634

IREDELL COUNTY HEALTH DEPARTMENT

STATESVILLE 704-878-5305 MOORESVILLE 704-664-5281

IMPROVEMENT PERMIT / CERTIFICATE OF COMPLETION / OPERATION PERMIT / EXISTING SYSTEM INSPECTION

PROPERTY DESCRIPTION NO. 17337 DATE 11/29/93 TAX MAP NO. 4C-A-60 Watershed: ☑ Yes ☐ No

OWNER OR CONTRACTOR CHARLES A SMITH JR. PHONE: Business _____ Home 663-0425

ADDRESS Rt 5 Box 45 MOORESVILLE, NC. 28115

LOCATION WIGGINS RD, TL OF 152E ~ 1 MILE ON (L)

SUBDIVISION N/A BLOCK / SECTION _____ LOT _____ LOT AREA ACERAGE SITE CLASS. P DESIGN FLOW 480 L.T.A.R. .3 = .35

Septic Tank: 1000 Gallons; STB 794 Date 8/17/94
Pump Tank: _____ Gallons; PT _____ Date _____
Pump Make: _____ Model _____ Serial No. _____
Nitrification Field: No Fields 1 Square Feet 1200 Linear Feet 400
No Lines 4 Trench Width 3' Max Trench Bottom Depth 36" Gravel Depth 12"

☐ New System ☐ Repair System Type: I (II) III, IV, V, VI
System Description: CONV - DROP BORES
Repair System Description: _____
Maintenance Agreement Required: ☐ Yes ☑ No

☑ House/Mod. Home No. Bedrooms 4
☐ Mobile Home No. Bathrooms 3
☐ Business No. Employees _____
☐ Other _____


☐ Slab ☐ Crawl Space ☑ Basement w/plumbing ☐ Basement wo/plumbing

Water Supply:
☑ Individual
☐ Community
☐ Public


Comments: REPLACING DESTROYED LINE AND ADDING ADDITIONAL LINE FOR EXTRA BEDROOM

Comments:

INITIAL SITE SKETCH

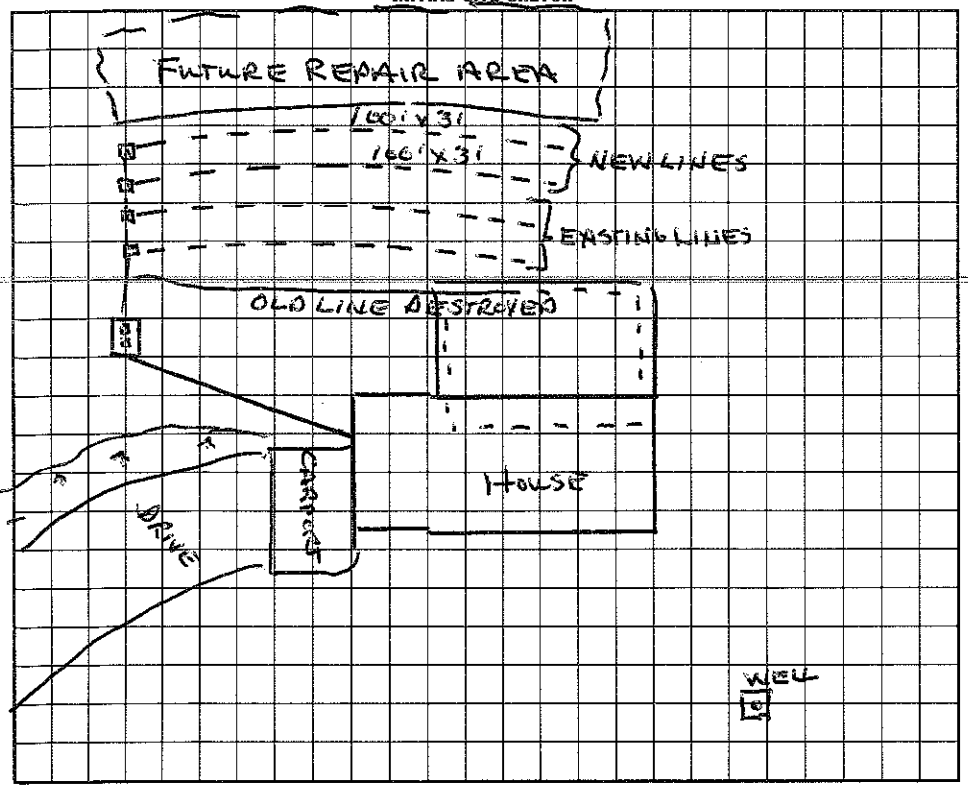

AS BUILT SKETCH

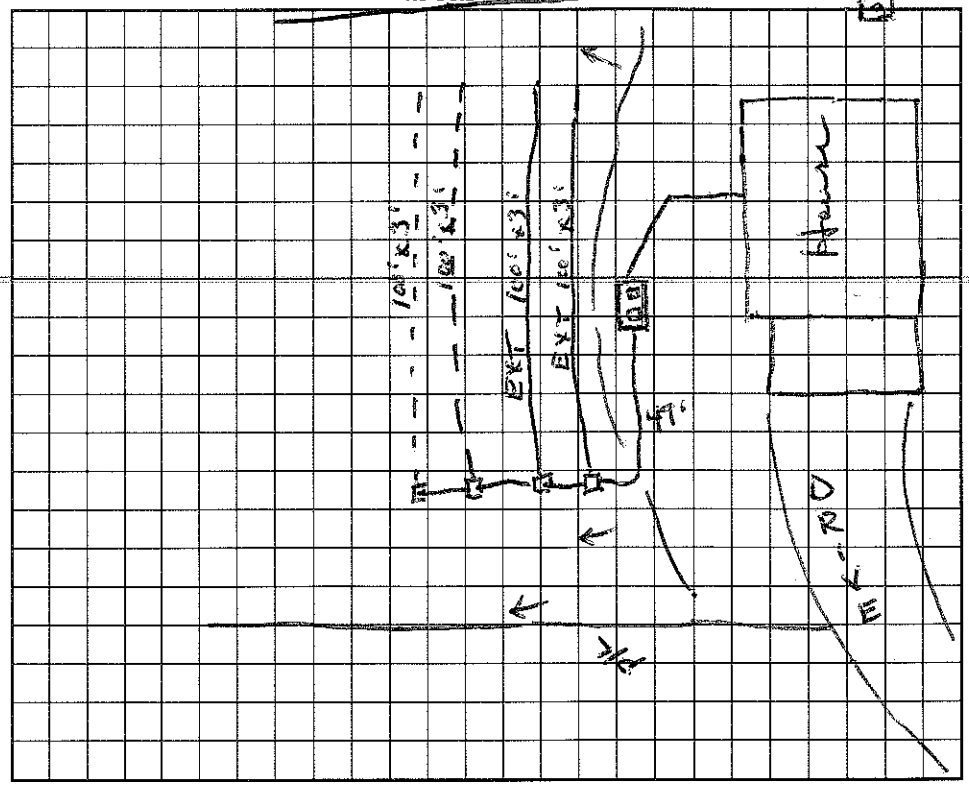

I understand that this permit can be suspended or revoked if any false information is supplied toward securing the permit/any unauthorized changes are made to the site/any unauthorized changes are made in the installation of the system. Improvement Permit is valid for 60 months from date of issuance.

Signed: Charles A. Smith, Jr.

Improvement Permit by: Wesley Sparks R.S. date 11/29/93

Existing System Inspection by: _____ date _____

Installed by: Wayne Dalton

Certificate of Completion by: Wesley Sparks R.S. date 9/29/94

Operation Permit by: _____ date _____

HEALTH DEPT. COPY: WHITE INSPECTION COPY (FINAL): GREEN OWNER COPY (FINAL): YELLOW INSPECTION COPY (INITIAL): PINK OWNER COPY (INITIAL): GOLD