4678559715

IREDELL COUNTY HEALTH DEPARTMENT

STATESVILLE 704-878-5305 MOORESVILLE 704-664-5281

IMPROVEMENT PERMIT / CERTIFICATE OF COMPLETION / OPERATION PERMIT / EXISTING SYSTEM INSPECTION

PROPERTY DESCRIPTION NO. 17122 DATE 3/24/94 TAX MAP NO. 4A A9 Watershed: ☐ Yes ☒ No

OWNER OR CONTRACTOR Larry Sullivan PHONE: Business 663-7063 Home

ADDRESS Wiggins Rd. Mooresville, NC

LOCATION 150E of Wiggins - - - 1 1/2 mile on (R)

SUBDIVISION No BLOCK / SECTION — LOT No LOT AREA ~ 1 AC SITE CLASS. P DESIGN FLOW 360 L.T.A.R. .25-.3

Septic Tank: 1000 Gallons; STB 782 Date 3/3/94

Pump Tank: — Gallons; PT — Date —

Pump Make: — Model — Serial No. —

Nitrification Field: No Fields 1 Square Feet 1200 Linear Feet 400

No Lines 4 Trench Width 3' Max Trench Bottom Depth 36" Gravel Depth 12"

☑ New System ☐ Repair System Type: I, II, III, IV, V, VI

System Description: CONV DROP BOX

Repair System Description: SAME

Maintenance Agreement Required: ☐ Yes ☒ No

☑ House/Mod. Home No. Bedrooms 3

☐ Mobile Home No. Bathrooms 3

☐ Business No. Employees —

☐ Other —

☐ Slab ☑ Crawl Space ☑ Basement w/plumbing ☐ Basement wo/plumbing

Water Supply: ☑ Individual ☐ Community ☐ Public


Comments:

VOIDS PERMIT DATED 10/1/93

Repair Area below original System

Comments:

INITIAL SITE SKETCH

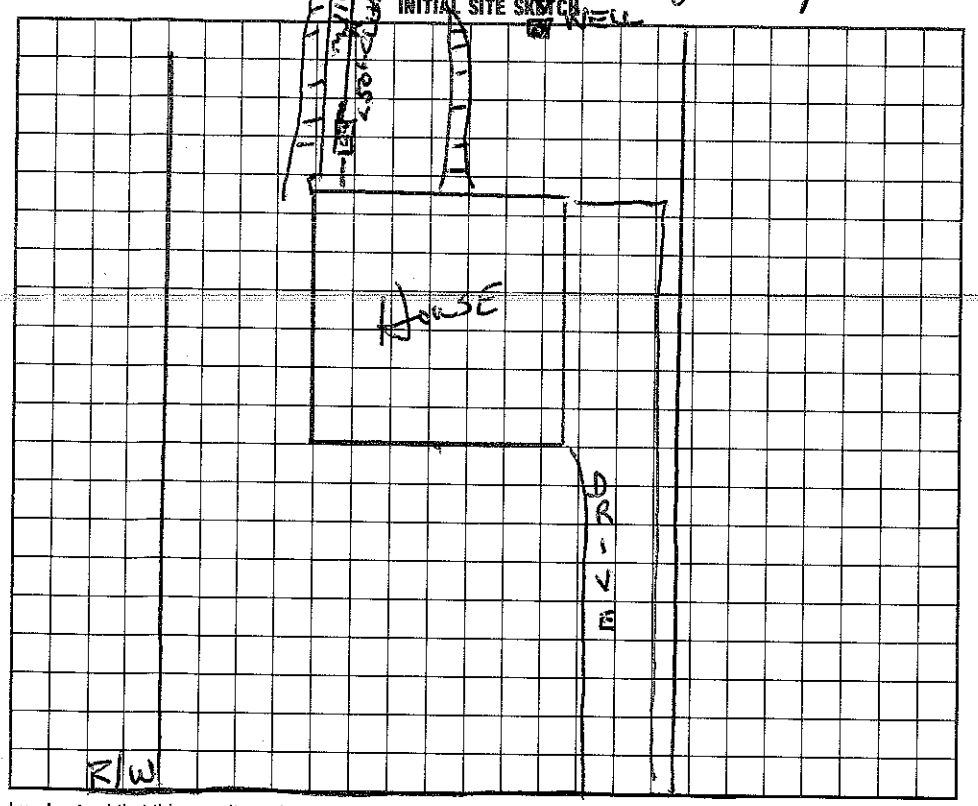

AS BUILT SKETCH

I understand that this permit can be suspended or revoked if any false information is supplied toward securing the permit/any unauthorized changes are made to the site/any unauthorized changes are made in the installation of the system. Improvement Permit is valid for 60 months from date of issuance.

Signed: WIGGINS RD.

Improvement Permit by: Wesley Sparks R.S. date 3/24/94

Existing System Inspection by: — date —

Installed by: Dennis Gelicher

Certificate of Completion by: Wesley Sparks R.S. date 4/20/94

Operation Permit by: — date —

HEALTH DEPT. COPY: WHITE INSPECTION COPY (FINAL): GREEN OWNER COPY (FINAL): YELLOW INSPECTION COPY (INITIAL): PINK OWNER COPY (INITIAL): GOLD