IREDELL COUNTY HEALTH DEPARTMENT

Statesville Office (704) 878-5305 | Mooresville Office (704) 660-3625 | PERMIT # 24134

SEPTIC IMPROVEMENT PERMIT / AUTHORIZATION TO CONSTRUCT / OPERATION PERMIT / EXISTING SYSTEM

PIN # 4678588111

APPLICANT/OWNER: Wendell Haire | APPLICANT ADDRESS: 372 Wiggins Rd. Mooresville, NC 28115

SITE ADDRESS: 372 Wiggins Rd. Mooresville, NC 28115 | PHONE: 704-663-6713 | ALT. PHONE 704-657-5245

SITE DIRECTIONS: NC 152 E to L on Wiggins Rd, Lot will be on Left | SAP CONTROLLED: ☐ YES ☐ NO


SUBDIVISION: — | SECTION: — | LOT # — | LOT AREA: 1.54 acres | DESIGN FLOW: 360GPD | L.T.A.R.: —

Septic Tank	1000	(gal)	STB	700	Date	5-2-19	☐ New System ☒ Repair ☐ Expansion System Type: I II III IV V VI	☒ Residence	No. Bedrooms 3
Pump Tank		(gal)	PT		Date		System Description: Existing Conv	☐ Business	No. Persons 6
Pump Make			Model		Serial #		Repair System Description: Conv	☐ Other	No. Employees
# Nitrification Fields	1		# Lines	3	Linear Ft.	342'	Maintenance Agreement Required: ☐ YES ☒ NO	☐ Slab	☐ Crawl Space
Trench Width	36"		Trench Bottom Depth(Low side)		30"	Gravel Depth 12"	☒ GRAVITY ☐ PRESSURE	☐ Basement w/plumbing	☒ Basement w/o plumbing

Water Supply: ☒ Private ☐ Public ☐ Community

Comments / Conditions: Dispose of old tank by pump, crush and Fill

INITIAL SITE SKETCH

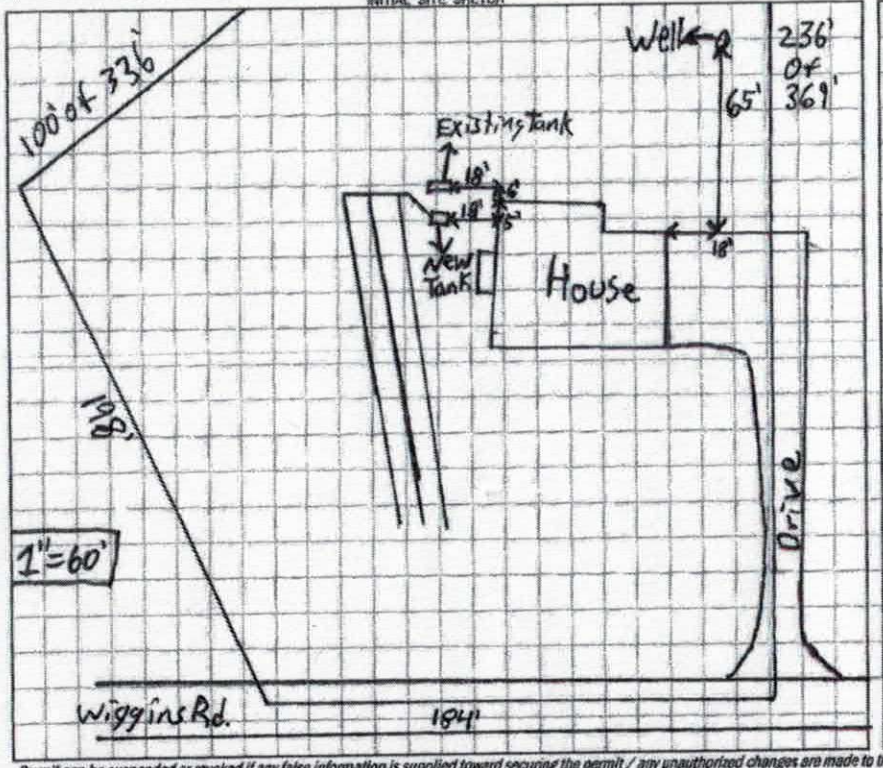

AS BUILT SKETCH

- new tank 20' from house
- new d-box installed

Permit can be suspended or revoked if any false information is supplied toward securing the permit, / any unauthorized changes are made to the site / any unauthorized changes are made in the installation of the system. CONTACT A LOCATOR SERVICE PRIOR TO ANY EXCAVATION

☐ IMPROVEMENT PERMIT *with plat* valid without expiration. ☐ IMPROVEMENT PERMIT *with site plan* valid for 60 mos. ☐ AUTHORIZATION TO CONSTRUCT valid for period equal to IMPROVEMENT PERMIT--not to exceed 60 mo.

Owner / Applicant Signature: Wendell Haire Date: 5-3-19 Installed by: Lentz Wastewater

IMPROVEMENT PERMIT by: Patrick O Bell III Date: 05/03/19 OPERATION PERMIT by: Carla C. Carr Date: 5-13-19

AUTHORIZATION TO CONSTRUCT by: Patrick O Bell III Date: 05/03/19 Existing System Inspected by: Date:

FOR SEPTIC FINAL INSPECTION: CALL 704-664-3703 between 8am-9am the day th[illegible]ction is needed. Be sure to speak with an inpsector to confirm your inspection time.

IREDELL COUNTY HEALTH DEPARTMENT

Statesville Office (704) 878-5305 | Mooresville Office (704) 660-3625 | PERMIT # 244134

SEPTIC IMPROVEMENT PERMIT / AUTHORIZATION TO CONSTRUCT / OPERATION PERMIT / EXISTING SYSTEM

PIN # 4678588111

APPLICANT/OWNER: Wendell Haire | APPLICANT ADDRESS: 372 Wiggins Rd. Mooresville, NC 28115

SITE ADDRESS: 372 Wiggins Rd. Mooresville, NC 28115 | PHONE: 704-663-6713 | ALT. PHONE 704-657-5245

SITE DIRECTIONS: NC152E to L on Wiggins Rd, Lot will be on Left | SAP CONTROLLED: ☐ YES ☐ NO


SUBDIVISION: — | SECTION: — | LOT # — | LOT AREA: 1.54 acres | DESIGN FLOW: 360GPD | L.T.A.R.: —

Septic Tank	1000 (gal)	STB	Date	☐ New System	☒ Repair	☐ Expansion	System Type: I (II) III IV V VI	☒ Residence	No. Bedrooms 3
Pump Tank	(gal)	PT	Date	System Description:	Existing Conv			☐ Business	No. Persons 6
Pump Make	Model		Serial #	Repair System Description:	Conv			☐ Other	No. Employees
# Nitrification Fields	1	# Lines	3	Linear Ft	342'	Maintenance Agreement Required:	☐ YES ☒ NO	☐ Slab	☐ Crawl Space
Trench Width	36"	Trench Bottom Depth(Low side)	30"	Gravel Depth	12"	☒ GRAVITY	☐ PRESSURE	☐ Basement w/plumbing	☒ Basement w/o plumbing

Water Supply: ☒ Private ☐ Public ☐ Community

Comments / Conditions: Dispose of old tank by pump, crush and Fill

INITIAL SITE SKETCH

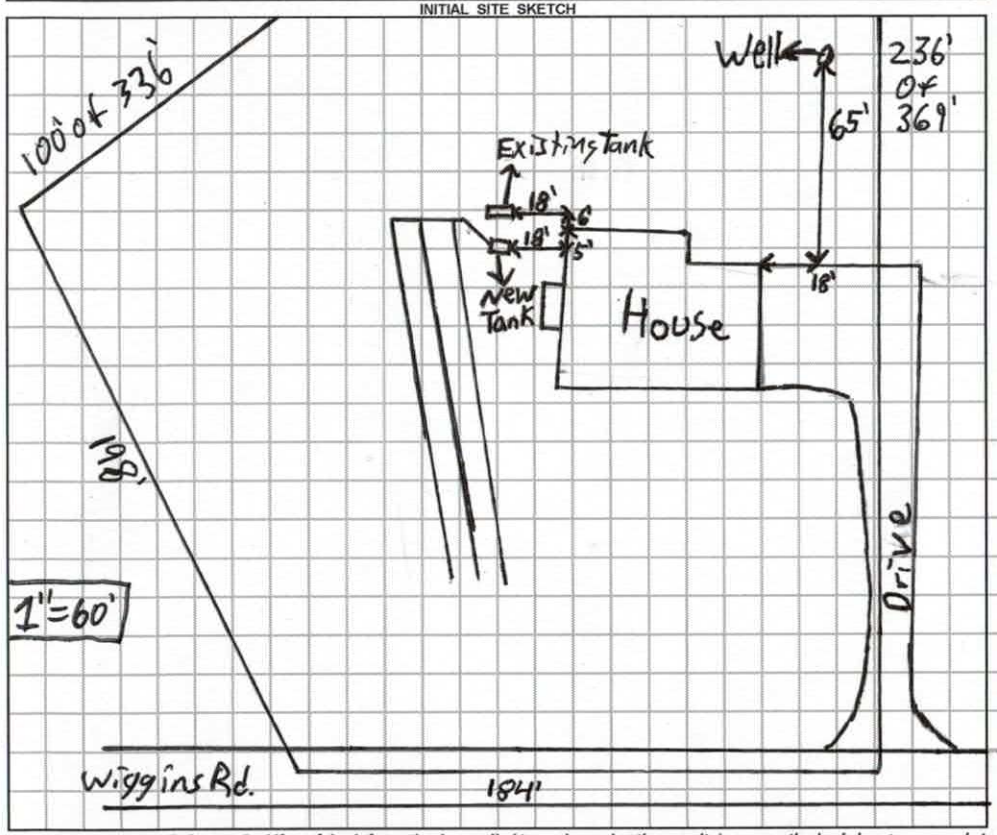

AS BUILT SKETCH

Permit can be suspended or revoked if any false information is supplied toward securing the permit / any unauthorized changes are made to the site / any unauthorized changes are made in the installation of the system. **CONTACT A LOCATOR SERVICE PRIOR TO ANY EXCAVATION**

☐ **IMPROVEMENT PERMIT** *with plat valid without expiration.* ☐ **IMPROVEMENT PERMIT** *with site plan valid for 60 mos.* ☐ **AUTHORIZATION TO CONSTRUCT** *valid for period equal to IMPROVEMENT PERMIT--not to exceed 60 mo.*

Owner / Applicant Signature: Wendell Haire | Date: 5-3-19 | Installed by:

IMPROVEMENT PERMIT by: Patrick O Beck III | Date: 05/03/19 | OPERATION PERMIT by: | Date:

AUTHORIZATION TO CONSTRUCT by: Patrick O Beck III | Date: 05/03/19 | Existing System Inspected by: | Date:

FOR SEPTIC FINAL INSPECTION: CALL 704-664-3703 between 8am-9am the day th[illegible]ction is needed. Be sure to speak with an inpsector to confirm your inspection time.

#24413 Rep Eval no charge 4-29-19

IREDELL COUNTY DEPARTMENT of ENVIRONMENTAL HEALTH

APPLICATION FORM

Application For: ( ) New Well Permit ( ) Well Repair Permit ( ) Well Abandonment
( ) Septic Improvement Permit ( ) Authorization to Construct ( ) Existing System Inspection (X) Septic System Repair

THE ABOVE PERMIT DOCUMENTS WILL BECOME INVALID IF INFORMATION PROVIDED ON THIS APPLICATION IS FALSIFIED OR CHANGED, OR IF THE SITE IS ALTERED. THE IMPROVEMENT PERMIT IS VALID FOR EITHER 60 MONTHS OR WITHOUT EXPIRATION DEPENDING UPON DOCUMENTATION SUBMITTED. APPLICATION WITH SITE PLAN 60 MONTHS, APPLICATION WITH COMPLETE, SCALED PLAT WITHOUT EXPIRATION. SEE 15A NCAC 18A .1937(f) FOR DETAILS.

Page 2: *Site Plan Worksheet* form MUST accompany this application

The following optional attachments may also be submitted: ( ) Survey Plat, scaled no more than 1 inch = 60 feet
Place an (X) *beside whichever is submitted if applicable* ( ) Custom Site Plan, scaled no more than 1 inch = 60 feet

Applicant Information: (PRINT CLEARLY)

Applicant Name: Wendell Haire Address: 372 Wiggins Rd. Mooresville Zip: 28115

Applicant Email: hackandchop@hotmail.com Phone: 704-663-6713 Alt. Phone: 704-657-5245

Owner Name: _____ Address: _____ Zip: _____

Owner Email: _____ Phone: _____ Alt. Phone: _____

Property Information:

Street Address: 372 Wiggins Rd. Mooresville NC 28115

Subdivision Name: _____ Section/Phase: _____ Lot Number: _____

Driving Directions: _____

Site Development Information: *(check or complete ALL that apply*

( ) New Single Family Residence
( ) New Multi-Family Residence
( ) Accessory Building
( ) Bedroom(s) Addition
(✓) Repair to failing septic system ✓ Tank ___ Drain lines Describe Problem: Lid or Top Caved In

Maximum Number of Bedrooms: 3
Maximum Number of Occupants: 6
( ) Swimming Pool
( ) Other Addition/Structure: _____

CHECK FOUNDATION TYPE

( ) Crawl Space Foundation
( ) Concrete Slab Foundation
( ) Basement with Plumbing
( ) Basement without Plumbing

Non-Residential Site Development: Type of Business: _____
Square Footage of Building: _____ Max. Number of Employees: _____ Max. Number of Seats/Beds/Other: _____

Water Supply: ( ) Replacement Well – Reason: _____
( ) Multi-connection Well Number of Houses: _____ Number of Persons: _____

( ) New Well (X) Existing Well ( ) Community Well ( ) City Water ( ) Other Public Water

Desired Septic System Type: *(you may rank in order of preference)* Year existing system installed: _____
( ) No Preference ( ) Alternative ( ) Conventional ( ) Innovative ( ) Modified Conventional ( ) Other: _____

Please answer the following to the best of your ability:

( ) Yes ( ) No Does the site contain any jurisdictional wetlands?
( ) Yes ( ) No Is any non-domestic sewage (i.e. industrial) to be generated?
( ) Yes ( ) No Is the site subject to approval by any other public agency?

I have read this application and certify that the information provided herein is true, complete, and correct. Authorized county and state officials are granted right of entry to conduct necessary inspections to determine compliance with applicable laws and rules. I understand that I am solely responsible for the proper identification and labeling of all property lines and corners and making the site accessible so that a complete site evaluation can be performed.

Signature: Wendell Haire 4-29-19
Property owner or owner's legal representative signature (SIGNATURE REQUIRED) DATE

IREDELL COUNTY DEPARTMENT OF ENVIRONMENTAL HEALTH

DOCUMENTATION TO AUTHORIZE AN OWNER'S LEGAL REPRESENTATIVE

(Check and sign only ONE of the options below)

1. * APPLICANT AND OWNER ARE THE SAME. * (*Sign here***)** X Wendell Hart

Applications for permits require the "signature of the owner or owner's legal representative" (15A NCAC 18A .1937). If the owner does not sign the application himself or herself, they can submit any one of the following documents to designate their legal representative: *Power of Attorney; Real Estate Contract; Estate executor; Bankruptcy trustee; Court ordered guardianship* In the absence of the above documentation, the property owner may provide the local health department with documentation that designates a legal representative. A property owner may:
Complete this form to document his or her legal representative, or provide his or her own form that contains the information in this form. If there are multiple property owners, then all property owners must sign the form that designates a legal representative.
By signing a form that designates a legal representative for purposes of 15A NCAC 18A .1937, the property owner authorizes that representative to act on their behalf in matters pertaining to the application and permitting process, including signing or receiving any application, document or permit. The owner retains full responsibility to meet all permit conditions specified by the local health department.

2. I, _____, am the legal owner(s) of the property located at _____, identified as

PIN (Parcel Identification Number)_____, located in Iredell County, North Carolina.

I do hereby authorize (**print legal representative/company name**) _____, _____, to act as an agent on my behalf in applying for/signing/obtaining any of the documents described below.

- Application for Improvement Permit (IP) / Authorization to Construct (AC)
- Improvement Permit (IP) / Authorization to Construct (AC)
- Application for soil-site evaluation (new/repair)
- Application/permit for private drinking water well/well abandonment
- Application for Compliance Inspection

I agree to abide by all decisions and/or conditions between the legal representative acting on my behalf and the Iredell County Department of Public Health, Environmental Health Division.

X Wendell Hart _____ 4-29-19

Signature of Owner(s) Date

Mooresville - Environmental Health
ronda.hart@co.iredell.nc.us
Fax: 704-662-3239
610 E. Center Avenue, Mooresville, NC 28115

Statesville - Environmental Health
adrienne.shea@co.iredell.nc.us
Fax: 704-871-3483
349 N. Center Street, Statesville, NC 28677