4678588111

IREDELL COUNTY HEALTH DEPARTMENT

STATESVILLE 704-878-5305 MOORESVILLE 704-664-5281

IMPROVEMENT PERMIT / CERTIFICATE OF COMPLETION / OPERATION PERMIT / EXISTING SYSTEM INSPECTION

PROPERTY DESCRIPTION NO. 16739 DATE 7/30/93 TAX MAP NO. Pt of 48-A-2

OWNER OR CONTRACTOR WENDELL L HAIRE PHONE: Business _____ Home 663-6713

ADDRESS 724 DOGWOOD LN. MOORESVILLE, NC.

LOCATION WIGGINS RD, 150E TL ON WIGGINS RD., 2 MILES ON (R) JUST BEFORE ballpark

SUBDIVISION NA BLOCK / SECTION _____ LOT NA LOT AREA 184 x 334 SITE CLASS. P L.T.A.R. 3-, 35

Water Supply: ☑ Individual ☐ Community ☐ Public

Septic Tank: 1000 Gallons; STB 358 Date 1/14/94

Pump Tank: _____ Gallons; PT _____ Date _____

Nitrification Field: No Fields 1 Square Feet 1028 Linear Feet 342

No Lines 3 Trench Width 3' Trench Depth 30" Gravel Depth 12"

☑ New System ☐ Repair System Type: I, (II), II, IV, V, VI

System Description: CONV.

Repair System Description: CONV.

Maintenance Agreement Required: ☐ Yes ☐ No

☑ House/Mod. Home No. Bedrooms 3

☐ Mobile Home No. Bathrooms 3.5

☐ Business No. Employees _____

☐ Other _____

☐ Slab ☐ Crawl Space ☐ Basement w/plumbing ☑ Basement wo/plumbing

Garbage Disposal: ☐ Yes ☑ No


Auto. Dishwasher: ☑ Yes ☐ No

Auto. Washing Machine: ☑ Yes ☐ No

Other _____

Comments TRENCH DEPTH 30" -

INITIAL SITE SKETCH 368

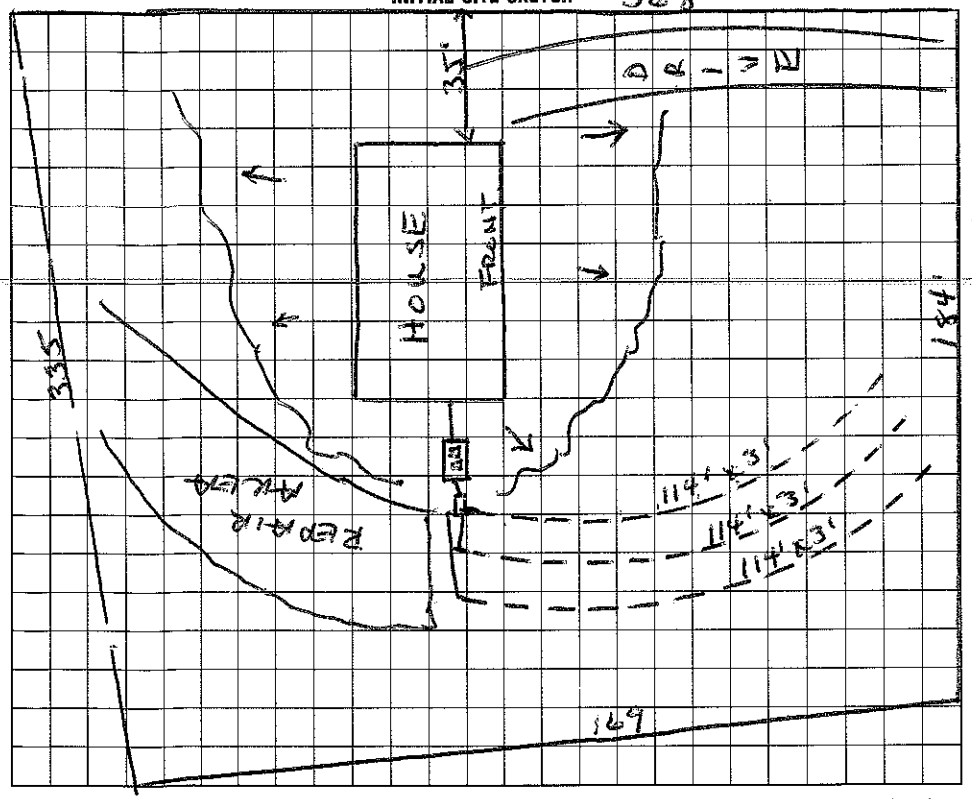

AS BUILT SKETCH

backfilled as shown

I understand that this permit can be suspended or revoked if any false information is supplied toward securing the permit/any unauthorized changes are made to the site/any unauthorized changes are made in the installation of the system. Improvement Permit is valid for 60 months from date of issuance.

Signed: Susan Haire

Improvement Permit by: Wesley Sparks R.S. date 7/30/93

Existing System Inspection by: _____ date _____

Installed by: Larry Beam

Certificate of Completion by: Wesley Sparks R.S. date 3/8/94

Operation Permit by: _____ date _____

HEALTH DEPT. COPY: WHITE INSPECTION COPY (FINAL): GREEN OWNER COPY (FINAL): YELLOW INSPECTION COPY (INITIAL): PINK OWNER COPY (INITIAL): GOLD