4078596318

IREDELL COUNTY HEALTH DEPARTMENT

STATESVILLE 704-878-5305 MOORESVILLE 704-664-5281

IMPROVEMENT PERMIT / CERTIFICATE OF COMPLETION / OPERATION PERMIT / EXISTING SYSTEM INSPECTION

PROPERTY DESCRIPTION NO. Repair DATE 5/9/96 TAX MAP NO. Watershed: ☐ Yes ☐ No

OWNER OR CONTRACTOR Randy Neill PHONE: Business Home 663-5775

ADDRESS 308 Wiggins Rd Mooresville NC 28115

LOCATION 601 W SR Wiggins - 308 Wiggins Rd on Rt

SUBDIVISION N/A BLOCK / SECTION LOT N/A LOT AREA ≈2 ac SITE CLASS FS DESIGN FLOW 360 L.T.A.R. .55 gpd

Septic Tank: Precast Gallons; STB Date

Pump Tank: Gallons; PT Date

Pump Make: Model Serial No.

Nitrification Field: No Fields 1 Square Feet 900 Linear Feet 300

No Lines 2 Trench Width 36" Max Trench Bottom Depth 36" Gravel Depth 12"

☐ New System ☑ Repair System Type: I II III IV V VI

System Description: Gravity Corrected

Repair System Description:

Maintenance Agreement Required: ☐ Yes ☐ No

☑ House/Mod. Home No. Bedrooms 3

☐ Mobile Home No. Bathrooms 2

☐ Business No. Employees

☐ Other


☐ Slab ☐ Crawl Space ☐ Basement w/plumbing ☐ Basement wo/plumbing

Water Supply: ☑ Individual ☐ Community ☐ Public


Comments: Divert storm drains away from system. Bull Run valve may be installed.

Comments:

INITIAL SITE SKETCH

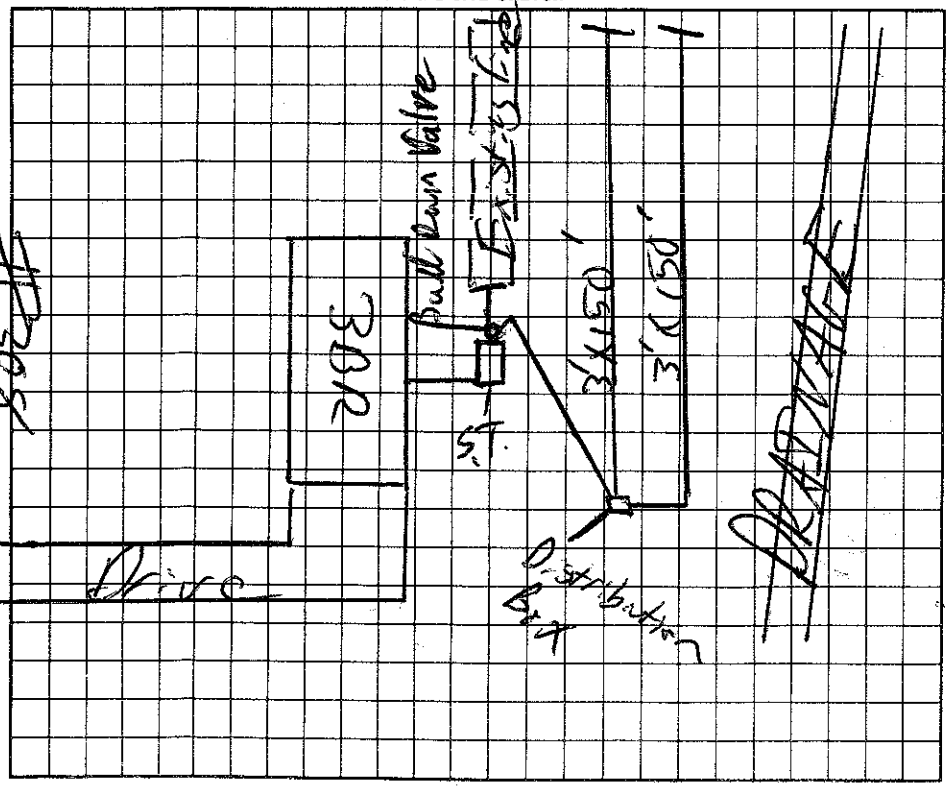

AS BUILT SKETCH

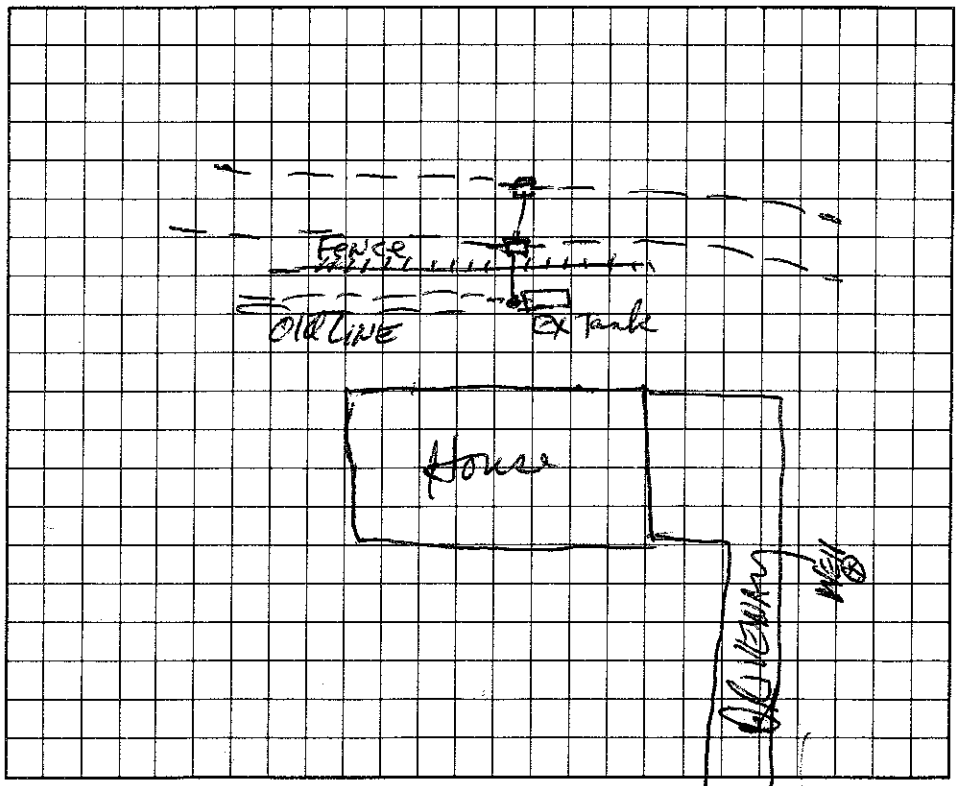

I understand that this permit can be suspended or revoked if any false information is supplied toward securing the permit/any unauthorized changes are made to the site/any unauthorized changes are made in the installation of the system.

Signed: Randy Neill

Improvement Permit by: [illegible] date 5/9/96

Existing System Inspection by: [illegible] date 5/9/96

Installed by: Larry Beam

Certificate of Completion by: [illegible] date

Operation Permit by: [illegible] date 10-17-96

HEALTH DEPT. COPY: WHITE INSPECTION COPY (FINAL): GREEN OWNER COPY (FINAL): YELLOW INSPECTION COPY (INITIAL): PINK OWNER COPY (INITIAL): GOLD