4678616737

IREDELL COUNTY HEALTH DEPARTMENT

STATESVILLE 704-878-5305 MOORESVILLE 704-664-5281

IMPROVEMENT PERMIT / CERTIFICATE OF COMPLETION / OPERATION PERMIT / EXISTING SYSTEM INSPECTION

PROPERTY DESCRIPTION NO. 25045 DATE 9/4/96 TAX MAP NO. IP A 37 Watershed: [X] Yes [ ] No

OWNER OR CONTRACTOR Alton Overcash PHONE: Business Home 663-3594

ADDRESS 182 Mc Knight Ln. Mooresville, NC. 28115

LOCATION 150 E TL of Mc Knight Ln. to the end.

SUBDIVISION N/A BLOCK / SECTION LOT LOT AREA ~7AC SITE CLASS. PS DESIGN FLOW 360 L.T.A.R. .3

Septic Tank: 1000 Gallons; STB 794 Date 12/23/96

Pump Tank: Gallons; PT Date

Pump Make: Model Serial No.

Nitrification Field: No Fields 1 Square Feet 1200 Linear Feet 400

No Lines 4 Trench Width 36" Max Trench Bottom Depth 30" Gravel Depth 12"

[X] New System [ ] Repair System Type: I. II. III. IV. V. VI

System Description: CONV - CRAW - DIST BOX

Repair System Description: Same

Maintenance Agreement Required: [ ] Yes [X] No

[X] House/Mod. Home No. Bedrooms 3

[ ] Mobile Home No. Bathrooms 3

[ ] Business No. Employees

[ ] Other


[ ] Slab [ ] Crawl Space [X] Basement w/plumbing [ ] Basement wo/plumbing

Water Supply: [X] Individual [ ] Community [ ] Public EXISTING.

Comments:

Comments:

INITIAL SITE SKETCH

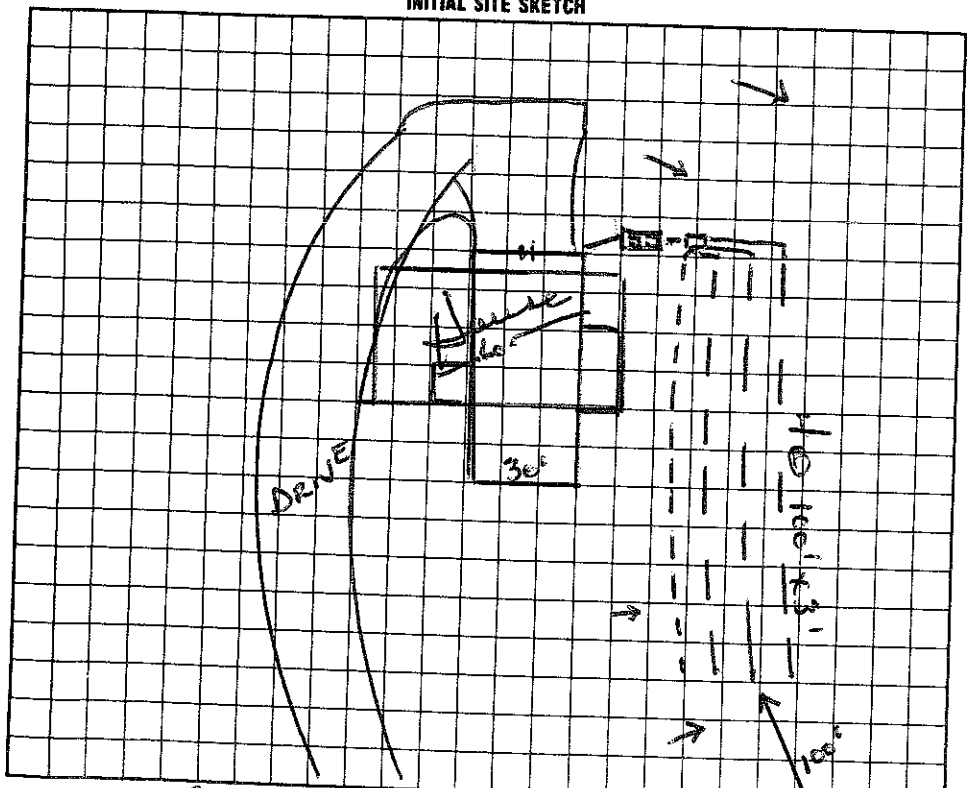

AS BUILT SKETCH

I understand that this permit can be suspended or revoked if any false information is supplied toward securing the permit/any unauthorized changes are made to the site/any unauthorized changes are made in the installation of the system.

Signed:

Improvement Permit by: Wesley Sparks RS. date 9/4/96

Existing System Inspection by: Contractor/Wesley Sparks date 9/4/96

Installed by: Julian Bowley

Certificate of Completion by: Wesley Sparks RS. date 4/7/97

Operation Permit by: Wesley Sparks RS. date 4/7/97

HEALTH DEPT. COPY: WHITE INSPECTION COPY (FINAL): GREEN OWNER COPY (FINAL): YELLOW INSPECTION COPY (INITIAL): PINK OWNER COPY (INITIAL): GOLD

WELL