4678637885

IREDELL COUNTY HEALTH DEPARTMENT

STATESVILLE 704-878-5305 MOORESVILLE 704-664-5281

IMPROVEMENT PERMIT / CERTIFICATE OF COMPLETION / OPERATION PERMIT / EXISTING SYSTEM INSPECTION

PROPERTY DESCRIPTION NO. Repair DATE 10/30/95 TAX MAP NO. N/A Watershed: ☒ Yes ☐ No

OWNER OR CONTRACTOR Perry A. Windsor PHONE: Business _____ Home 638-5056

ADDRESS Scottish Dr. Mooresville NC. 28115

LOCATION 1500 ft Scottish Dr. to last house on (R)

SUBDIVISION Scottish Downs BLOCK / SECTION _____ LOT _____ LOT AREA _____ SITE CLASS. _____ DESIGN FLOW _____ L.T.A.R. _____

Septic Tank: 1000 - Existing Gallons; STB _____ Date _____

Pump Tank: _____ Gallons; PT _____ Date _____

Pump Make: _____ Model _____ Serial No. _____

Nitrification Field: No Fields 1 Square Feet 1200 Linear Feet 400

No Lines 4 Trench Width 36" Max Trench Bottom Depth 36" Gravel Depth 6" Stone

☐ New System ☒ Repair System Type: I, II, III, IV, V, VI

System Description: GRAVITY INFILTRATOR

Repair System Description: _____

Maintenance Agreement Required: ☐ Yes ☐ No

☒ House/Mod. Home No. Bedrooms 4

☐ Mobile Home No. Bathrooms 2.5

☐ Business No. Employees _____

☐ Other _____


☐ Slab ☒ Crawl Space ☐ Basement w/plumbing ☐ Basement wo/plumbing

Water Supply: ☒ Individual ☐ Community ☐ Public

Comments: Bull Run Valve to elevate Gravity Lines Part area - Shallow - May use 400 feet of Conventional Drainfield if owner wishes.

Comments:

INITIAL SITE SKETCH

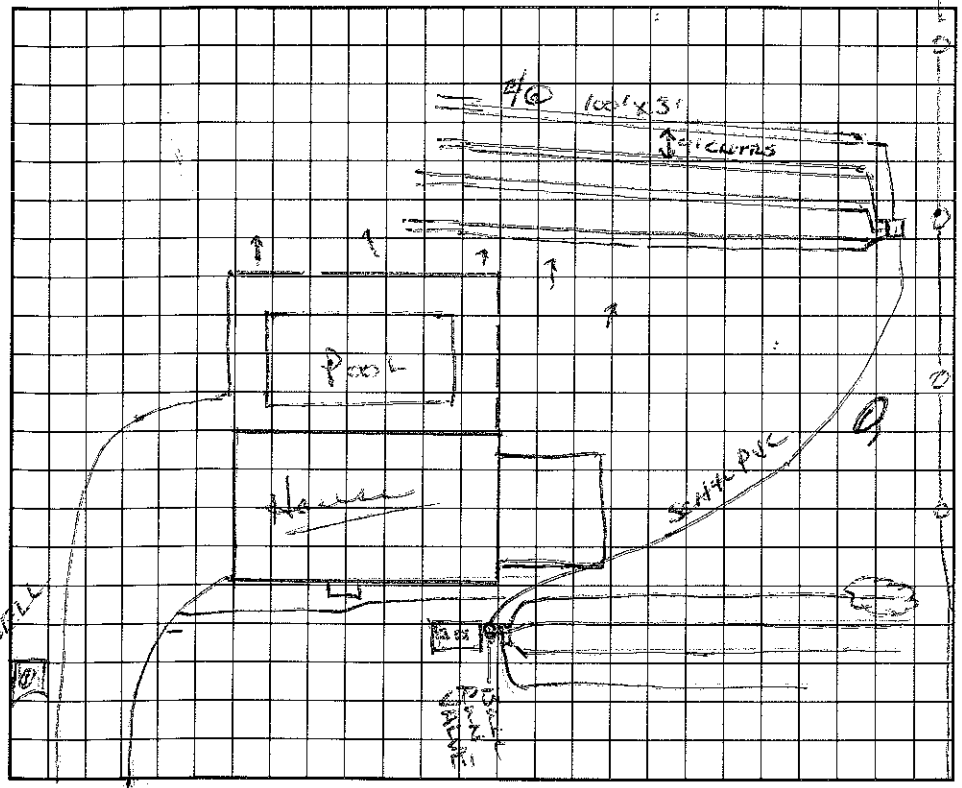

AS BUILT SKETCH

I understand that this permit can be suspended or revoked if any false information is supplied toward securing the permit/any unauthorized changes are made to the site/any unauthorized changes are made in the installation of the system.

Signed: _____ Installed by: C Wayne Dobson

Improvement Permit by: Wesley Sparks R.S. date 10/30/95

Existing System Inspection by: Construct: Wesley Sparks R.S. date 10/30/95

Certificate of Completion by: _____ date _____

Operation Permit by: Wesley Sparks R.S. date 4/19/96

HEALTH DEPT. COPY: WHITE INSPECTION COPY (FINAL): GREEN OWNER COPY (FINAL): YELLOW INSPECTION COPY (INITIAL): PINK OWNER COPY (INITIAL): GOLD