10:00 AM

IREDELL COUNTY HEALTH DEPARTMENT

Statesville Office (704) 878-5305 Mooresville Office (704) 660-3625 PERMIT # 211846

IMPROVEMENT PERMIT / AUTHORIZATION TO CONSTRUCT / OPERATION PERMIT / EXISTING SYSTEM

PIN # 4678-66-5937

APPLICANT: JOHN MEADOWS APPLICANT ADDRESS: 431 WIGGINS RD

SITE ADDRESS: SAME 431 Wiggins Rd. PHONE: 704-763-2045 ALT. PHONE:

SITE DIRECTIONS: 150, WIGGINS, ON R

SUBDIVISION: — SECTION: — LOT # — LOT AREA: 9.45 AC DESIGN FLOW: 360 L.T.A.R.: .3 (.2R)

Septic Tank 1000 (gal) STB 825 Date 6/2/15
Pump Tank 1000 (gal) PT 302 Date 6/17/15
Pump Make ZOELLER Model N-151 Serial #
Nitrification Fields 1 # Lines 3C100' Linear Ft: 300'
Trench Width 36" Max. Trench Bottom Depth * 12" * Gravel Depth —

☒ New System ☐ Repair ☐ Expansion System Type: I II ☒ III IV V VI
System Description: SHALLOW 25% RED (PM)
Repair System Description: DRIP
Maintenance Agreement Required: ☐ YES ☒ NO ☐ GRAVITY ☒ PRESSURE

☒ Residence ☐ Business ☐ Other ☐ Slab ☐ Basement w/plumbing
No. Bedrooms 3 No. Persons — No. Employees — ☒ Crawl Space ☐ Basement w/o plumbing

Water Supply: ☒ Private ☐ Public ☐ Community

Comments / Conditions: ☒ 8-10" GROUP III or IV COVER REQUIRED OVER DRAIN FIELD

Checked-fill-ok 9/9/15

INITIAL SITE SKETCH

SEE PLAN FROM ROLLANS SOIL & ENVIRONMENTAL SERVICES

AS BUILT SKETCH

8/5/15
NO UNION ON SUPPLY LINE
SL

WATER SERVED FROM MUNI HOOK UP
WELL ON
NEED TO CHECK FILL

TANKS & DRAINFIELD / SUPPLY TO LINE & FLOATS 8/5/15 OK SL

Permit can be suspended or revoked if any false information is supplied toward securing the permit / any unauthorized changes are made to the site / any unauthorized changes are made in the installation of the system. **CONTACT A LOCATOR SERVICE PRIOR TO ANY EXCAVATION**

☐ **IMPROVEMENT PERMIT** *with plat valid without expiration.* ☐ **IMPROVEMENT PERMIT** *with site plan valid for 60 mos.* ☒ **AUTHORIZATION TO CONSTRUCT** *valid for period equal to IMPROVEMENT PERMIT--not to exceed 60 mo.*

Owner / Applicant Signature: Date:

IMPROVEMENT PERMIT by: APPROVED Date: JUL 31 2015

AUTHORIZATION TO CONSTRUCT by: APPROVED Date: JUL 31 2015

Installed by: Frowin Sept RS


OPERATION PERMIT by: Marcellus Dotson Date: 9/9/15


Existing System Inspected by: Date:

Health Dept. Copy - WHITE Applicant (Final Approval) - YELLOW Applicant (Conditional Approval) - PINK

1" = 40'

APPROVED JUL 31 2015

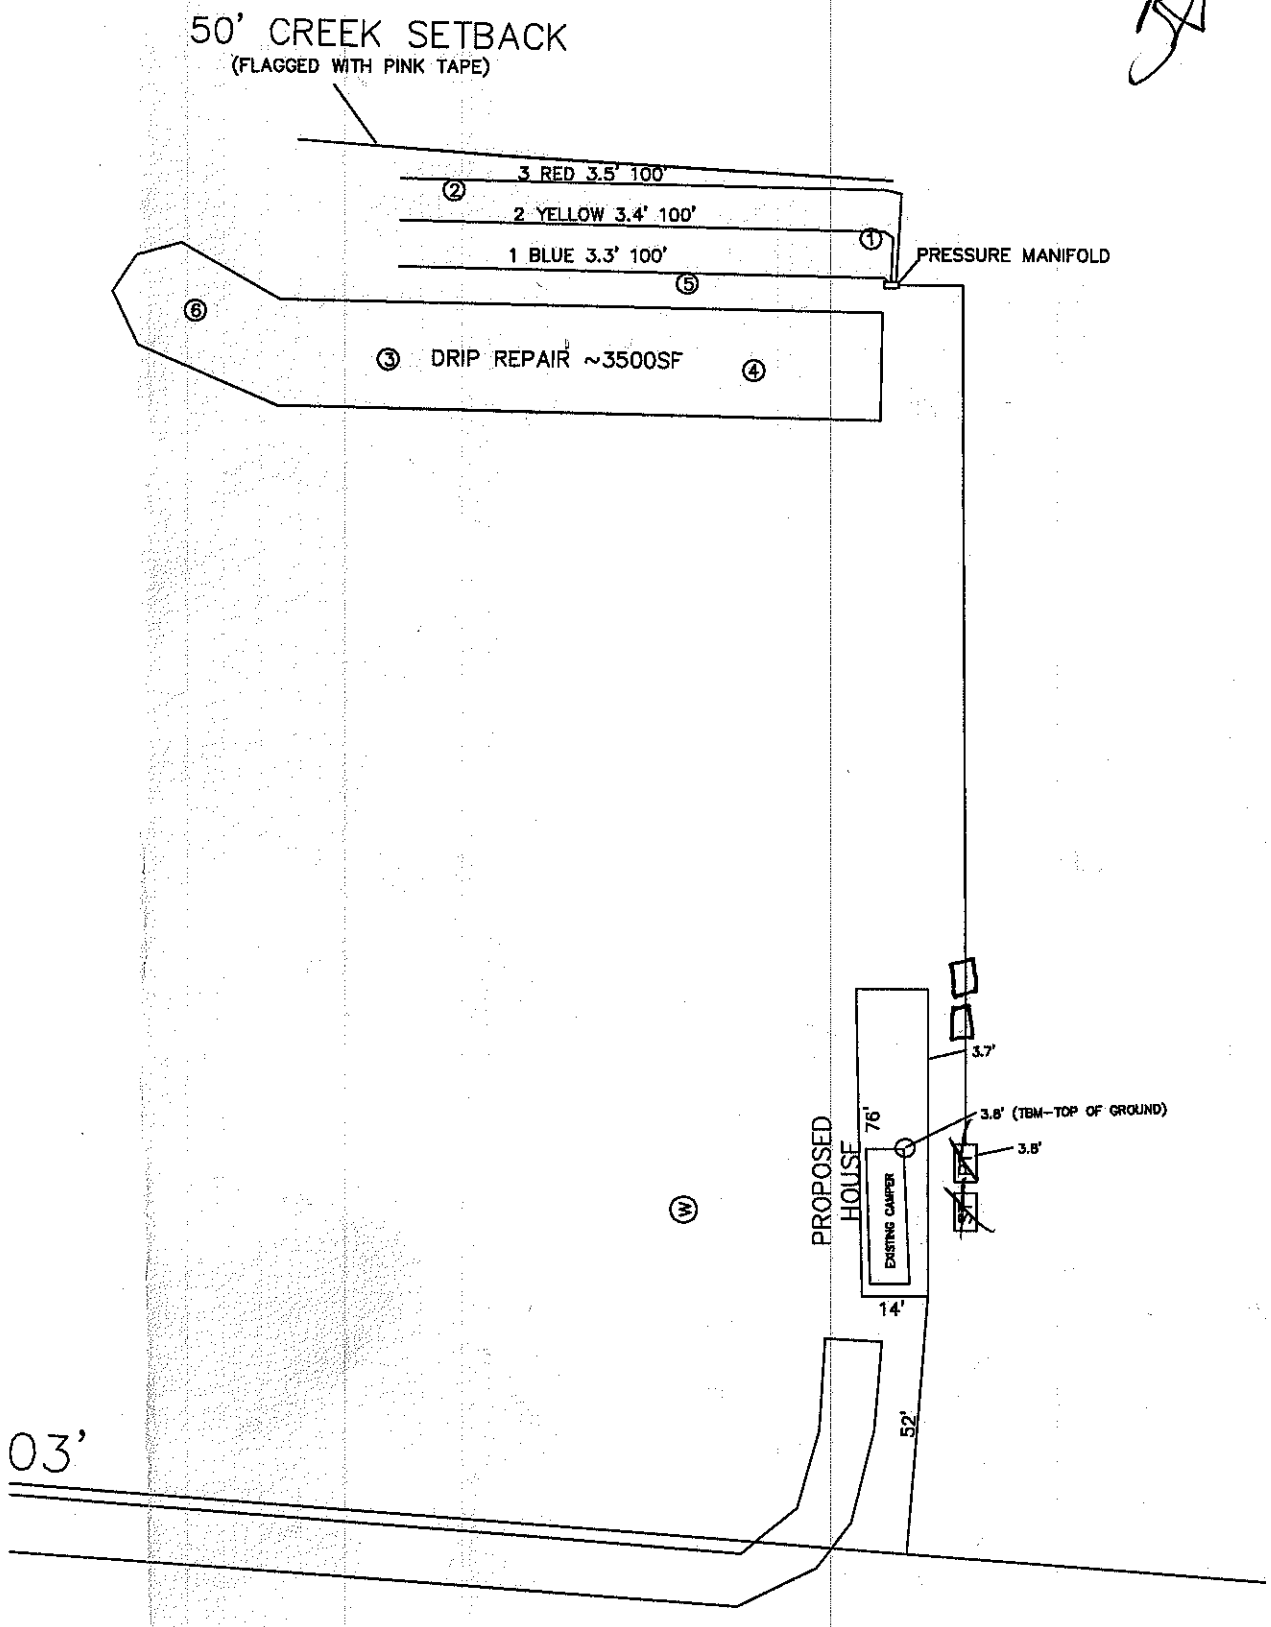

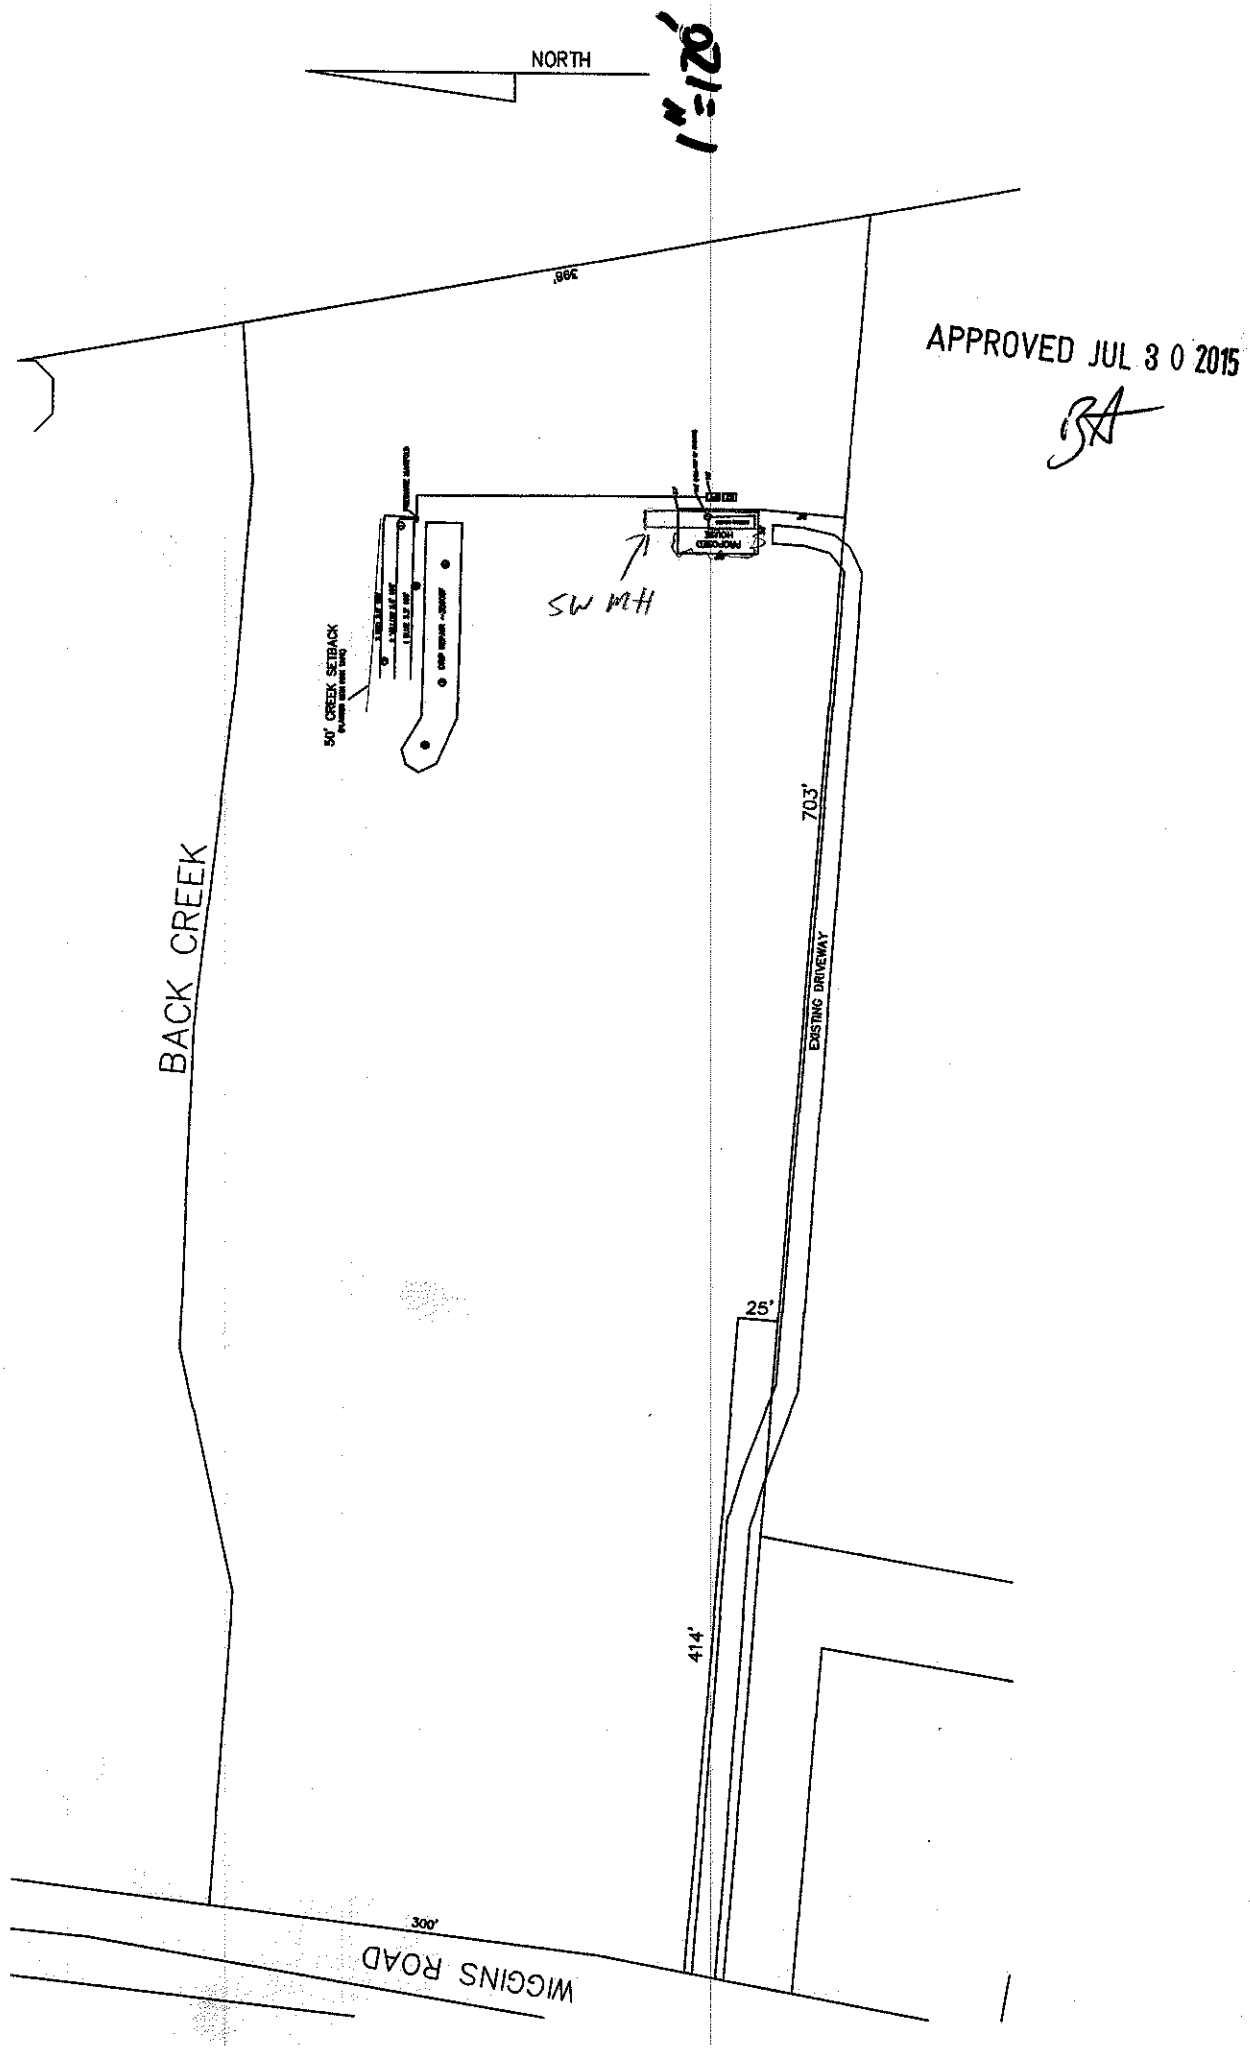
NORTH
1"=120'
APPROVED JUL 3 0 2015
SW MH
50' CREEK SETBACK
BACK CREEK
703'
EXISTING DRIVEWAY
25'
414'
300'
WIGGINS ROAD