IREDELL COUNTY HEALTH DEPARTMENT

Authorization to Construct 4678703173

STATESVILLE 704-878-5305 MOORESVILLE 704-664-5281

IMPROVEMENT PERMIT / ~~CERTIFICATE OF COMPLETION~~ / OPERATION PERMIT / EXISTING SYSTEM INSPECTION

PROPERTY DESCRIPTION NO. 23485 DATE 4/30/96 TAX MAP NO. 1P-1-20 pt of Watershed: ☑ Yes ☐ No

OWNER OR CONTRACTOR Leonard Harvey PHONE: Business Home 662-0083

ADDRESS 205 Mellar Cir. Mooresville NC 28115

LOCATION 150 E - TL Pine Ridge - 1st on left lot 201

SUBDIVISION TL Wensil BLOCK / SECTION LOT 201 LOT AREA 1.00 ac. SITE CLASS. PS DESIGN FLOW 360gpd L.T.A.R. .13gpl/ft2

Septic Tank: 1000 Gallons; STB 825 Date ~~3-25-96~~ 4/1/96 ☑ New System ☐ Repair System Type: I (II) III. IV. V. VI

Pump Tank: ____ Gallons; PT ____ Date ____ System Description: Gravity Conventional

Pump Make: ____ Model ____ Serial No. ____ Repair System Description: Gravity Chamber

Nitrification Field: No Fields 1 Square Feet 1200 Linear Feet 400 Maintenance Agreement Required: ☐ Yes ☑ No

No Lines 3 Trench Width 36" Max Trench Bottom Depth 36" Gravel Depth 12" ☐ Slab ☑ Crawl Space ☐ Basement w/plumbing ☐ Basement wo/plumbing

☑ House/Mod. Home No. Bedrooms 3

☐ Mobile Home No. Bathrooms 1

☐ Business No. Employees ____


☐ Other ____

Water Supply: ☑ Individual ☐ Community ☐ Public

Comments: System may be pushed back to avoid taking out trees.

Comments:

INITIAL SITE SKETCH

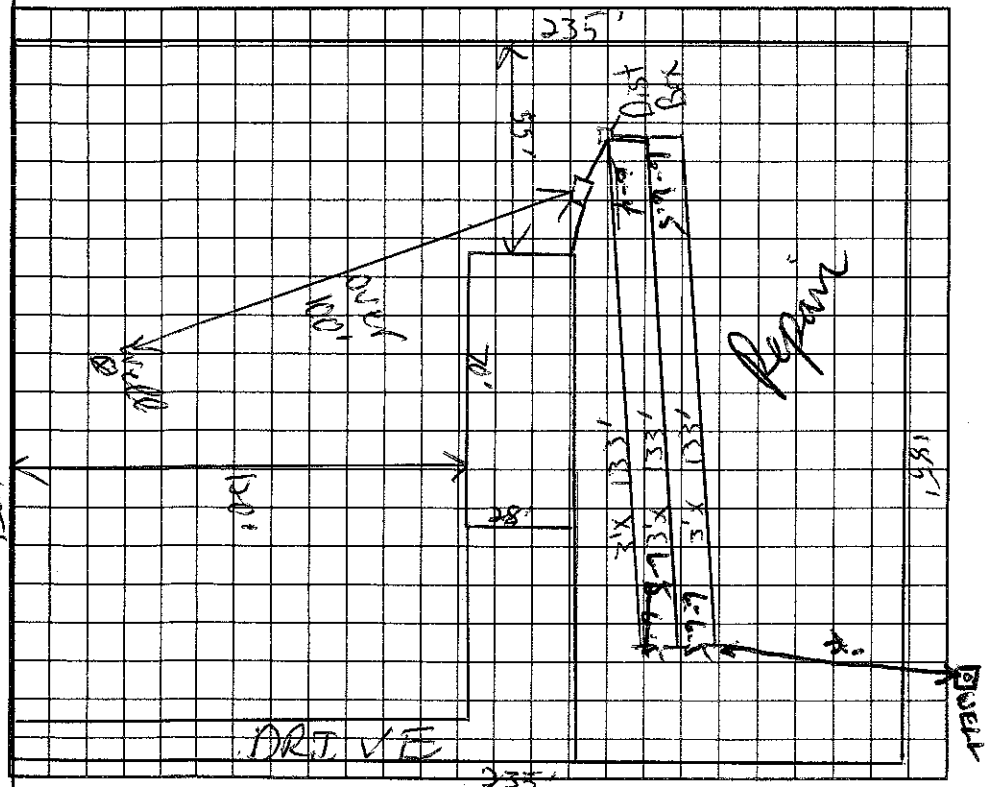

AS BUILT SKETCH

PINERIDGE DR. 155'

I understand that this permit can be suspended or revoked if any false information is supplied toward securing the permit/any unauthorized changes are made to the site/any unauthorized changes are made in the installation of the system.

Signed: Darlene Harvey

Installed by: Wayne Clontz

Improvement Permit by: C. Brookshire EHST date 4/30/96

Authorization to Construct ~~Existing System Inspection~~ by: C. Brookshire EHST date 4/30/96

Certificate of Completion by: ____ date ____

Operation Permit by: Wesley Sparks RS. date 8/6/96

HEALTH DEPT. COPY: WHITE INSPECTION COPY (FINAL): GREEN OWNER COPY (FINAL): YELLOW INSPECTION COPY (INITIAL): PINK OWNER COPY (INITIAL): GOLD

~~Authorization~~ to Construct is valid for 60 months from issue date