# IREDELL COUNTY HEALTH DEPARTMENT

STATESVILLE 704-878-5305 MOORESVILLE 704-664-5281

(9:30) (E)

## IMPROVEMENT PERMIT / AUTHORIZATION TO CONSTRUCT / OPERATION PERMIT / EXISTING SYSTEM INSPECTION

PERMIT# 92983 PIN# 4679025158 DATE 12/4/00

OWNER OR CONTRACTOR BEECHWOOD PARTNERS PHONE: Business 664-9080 Home

ADDRESS 225 ROLLING HILLS RD. MOORESVILLE NC 28117

LOCATION 801 N- TL TREPLETT- TL MALLARD WOOD DR. -ON RT

SUBDIVISION BEECHWOOD EST. BLOCK / SECTION LOT 11 LOT AREA .77AC SITE CLASS. RS DESIGN FLOW 360 GPD L.T.A.R. .3690/FT²

Septic Tank: 1000 Gallons; STB 160 Date 6/26/01
Pump Tank: Gallons; PT Date
Pump Make: Model Serial No.
Nitrification Field: No Fields 1 Square Feet 1200 Linear Feet 400
No Lines 4 @ 100' Trench Width 36" Max Trench Bottom Depth 36" Gravel Depth

☑ New System ☐ Repair System Type: I (II) III, IV, V, VI
System Description: GRAVITY CONVENTIONAL
Repair System Description: GRAV. 25% REDUCTION
Maintenance Agreement Required: ☐ Yes ☑ No


☑ House/Mod. Home No. Bedrooms 3
☐ Mobile Home No. Bathrooms 2
☐ Business No. Employees
☐ Other
☐ Slab ☑ Crawl Space ☐ Basement w/plumbing ☐ Basement wo/plumbing

Water Supply: ☑ Individual ☐ Public ☐ Community


Comments:/Conditions: 1) KEEP WELL 100' FROM SEPTIC SYSTEM AND REPAIR
9/7/01 MH fills building window for this permit.

Comments:/Conditions: REPAIR & INITIAL SYSTEM CHANGED

INITIAL SITE SKETCH 1"=50'

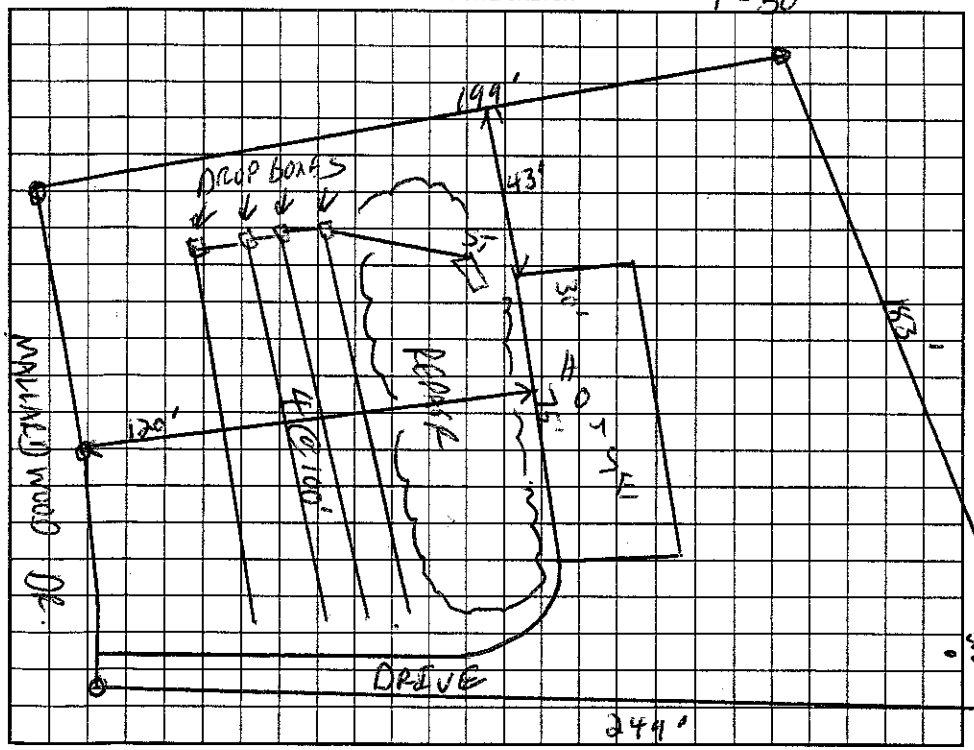


AS-BUILT SKETCH

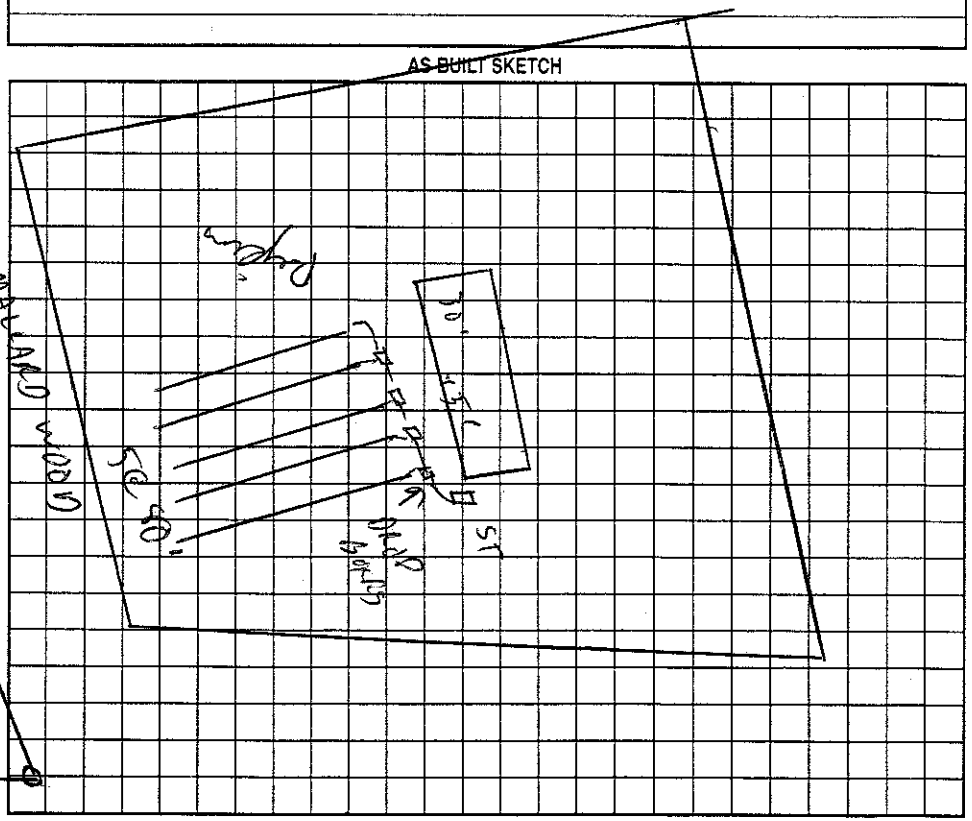


Permit can be suspended or revoked if any false information is supplied toward securing the permit/any unauthorized changes are made to the site/any unauthorized changes are made in the installation of the system. Improvement Permit with plat valid without expiration. Improvement Permit with site plan valid for sixty months. Authorization to Construct is valid for a period equal to that of Improvement Permit – not to exceed sixty months.

Signed: [signature] date 12/11/00 Installed by: GARY LEATHERMAN

Improvement Permit by: C. Beth Teem RS date 12/8/00 Operation Permit by: C. [signature] RS date 9/12/01

Authorization to Construct by: Whitney Sparks RS. date 9/7/01 Existing System Inspection by: date

HEALTH DEPT. COPY: WHITE OWNER COPY (FINAL): YELLOW OWNER COPY (INITIAL): PINK