3.00

IREDELL COUNTY HEALTH DEPARTMENT

STATESVILLE 704-878-5305 MOORESVILLE 704-664-5281

IMPROVEMENT PERMIT / AUTHORIZATION TO CONSTRUCT / OPERATION PERMIT / EXISTING SYSTEM INSPECTION

PERMIT# 92992 PIN# 4679029878 PT 4679-01-6317 DATE 1/27/01

OWNER OR CONTRACTOR BEECHWOOD PARTNERS PHONE: Business 664-9080 Home

ADDRESS 225 ROLLING HILLS RD. MOORESVILLE NC 28117

LOCATION 801 N - TC TRIPLETT - TL MALLARD WOOD - AT END Initial / Repair

SUBDIVISION BEECHWOOD EST. BLOCK / SECTION LOT 14 LOT AREA 2.78 AC SITE CLASS. PS DESIGN FLOW 360GPD L.T.A.R. - 3 bdrm .15 gpd/ft²

Septic Tank: 1000 Gallons; ST# 1012 Date 9/21/01

Pump Tank: 1000 Gallons; PT Date 9/4/00

Pump Make: Hydromatic Model SHEF50A Serial No.

Nitrification Field: No Fields 1 Square Feet 900 Linear Feet 300

No Lines 4@75' Trench Width 36" Max Trench Bottom Depth 36" Gravel Depth NA

☑ New System ☐ Repair System Type: I, II, III, IV, V, VI

System Description: PUMP 25% REDUCTION

Repair System Description: LPP

Maintenance Agreement Required: ☐ Yes ☑ No

☑ House/Mod. Home No. Bedrooms 3

☐ Mobile Home No. Bathrooms 3

☐ Business No. Employees

☐ Other


☐ Slab ☑ Crawl Space ☐ Basement w/plumbing ☐ Basement wo/plumbing

Water Supply: ☑ Individual ☐ Public ☐ Community


Comments/Conditions: 1) WHERE SUPPLY LINE CROSSES CREEK, SUPPLY LINE SHALL BE SLEEVED WITH DUCTILE IRON - 10 TO 10 TEN FEET ON EITHER SIDE OF CREEK. 2) CALL HEALTH DEPT. BEFORE INSTALLATION

Comments/Conditions: Building/house plans reviewed 8/27/2001 JJ/MD.

INITIAL SITE SKETCH 1"=100'

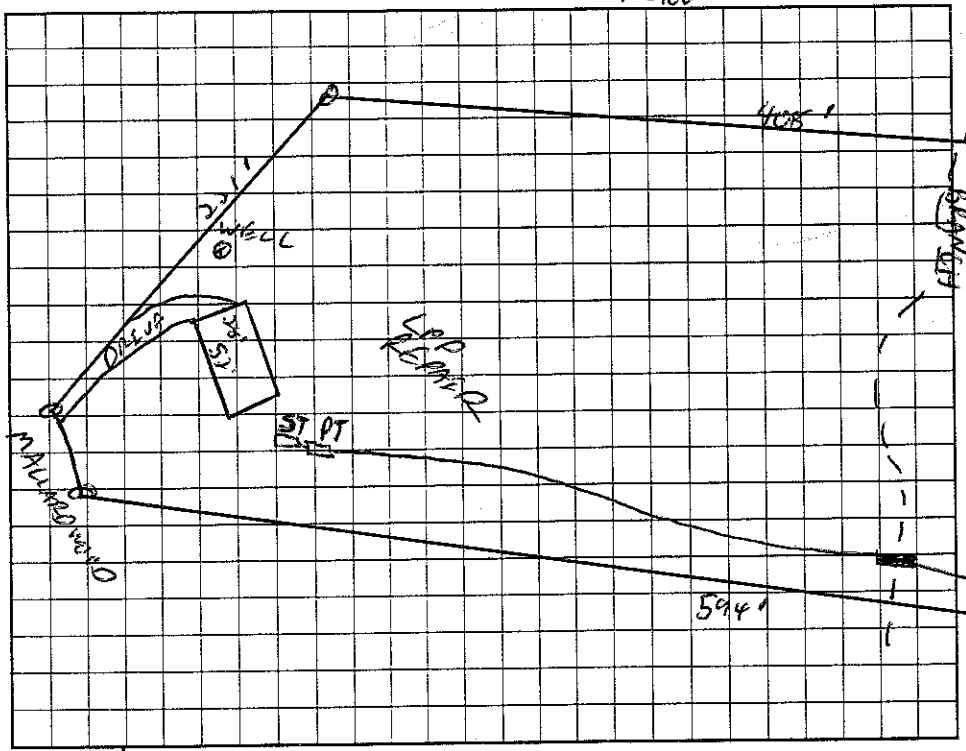

AS BUILT SKETCH

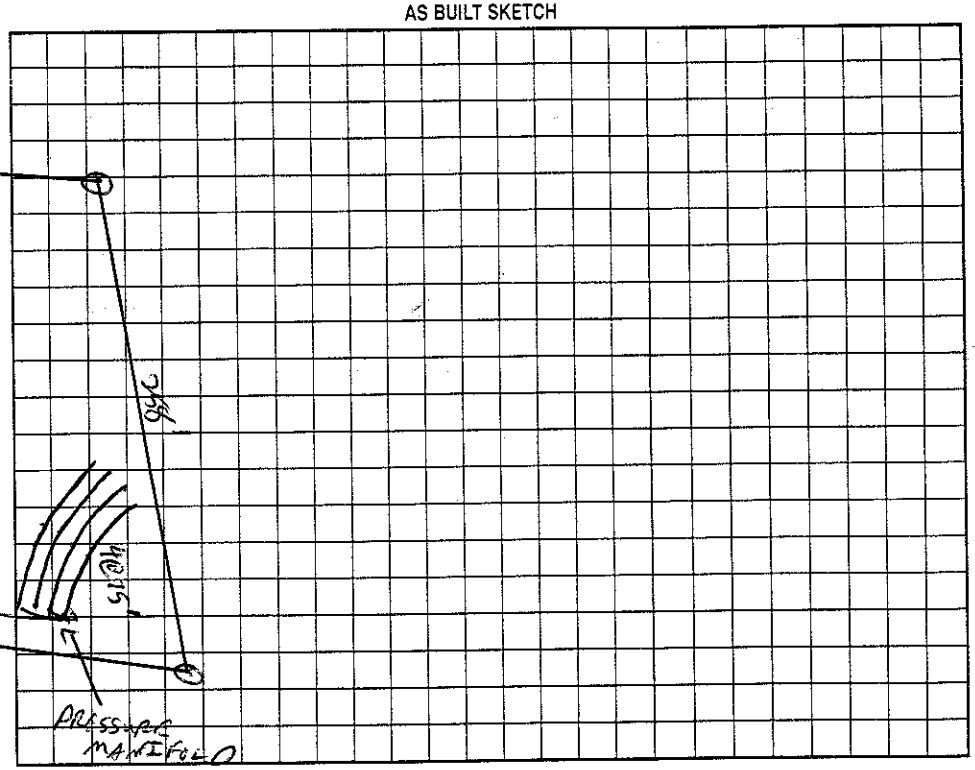

Permit can be suspended or revoked if any false information is supplied toward securing the permit/any unauthorized changes are made to the site/any unauthorized changes are made in the installation of the system. Improvement Permit with plat valid without expiration. Improvement Permit with site plan valid for sixty months. Authorization to Construct is valid for a period equal to that of Improvement Permit – not to exceed sixty months.

Signed: Gene E Miller date 1/29/01

Improvement Permit by: C. Bryan RS date 1/27/01

Authorization to Construct by: Marion H. Dotson RS date 8/27/01

Installed by: A-1 Backhoe

Operation Permit by: RSI date 9/26/01

Existing System Inspection by: date

HEALTH DEPT. COPY: WHITE OWNER COPY (FINAL): YELLOW OWNER COPY (INITIAL): PINK