IREDELL COUNTY HEALTH DEPARTMENT

STATESVILLE 704-878-5305 MOORESVILLE 704-664-5281

IMPROVEMENT PERMIT / AUTHORIZATION TO CONSTRUCT / OPERATION PERMIT / EXISTING SYSTEM INSPECTION

5000 gal 4100

PERMIT# 124942 PIN# 4779 01 7669 DATE 11/22/04

OWNER OR CONTRACTOR Fleetwood - Trentmen PHONE: Business 704-902-7773 Home

ADDRESS 1040 Charlotte Hwy Trentmon, NC. 28166

LOCATION 80 I N TL Triplett Rd TL Maplewood on (L) off Cul de sac

SUBDIVISION Beechwood Est BLOCK / SECTION LOT 15 LOT AREA 1.06AC SITE CLASS. PS DESIGN FLOW 480 L.T.A.R. .3

Septic Tank: 1000 Gallons; STB 1012 Date 6/16/04

Pump Tank: 1000 Gallons; PT 19 Date 9/18/04

Pump Make: Goulds Model WE0311M Serial No J043675

Nitrification Field: No Fields 1 Square Feet 1200 ± Linear Feet 400 ±

No Lines 5@80' Trench Width 3' Max Trench Bottom Depth 3' Gravel Depth No

☒ New System ☐ Repair System Type: I, II, III, IV, V, VI

System Description: PM = 25% Reduced

Repair System Description: 16" PPBPS

Maintenance Agreement Required: ☐ Yes ☒ No

☒ House/Mod. Home No. Bedrooms 4

☐ Mobile Home No. Bathrooms 2

☐ Business No. Employees

☐ Other


☐ Slab ☒ Crawl Space ☐ Basement w/plumbing ☐ Basement wo/plumbing

Water Supply: ☒ Individual ☐ Public ☐ Community


Comments/Conditions: Note 11' from foundation due to positive drainage issues.

Comments/Conditions: 400 @ 100' Tank location changed thus

INITIAL SITE SKETCH

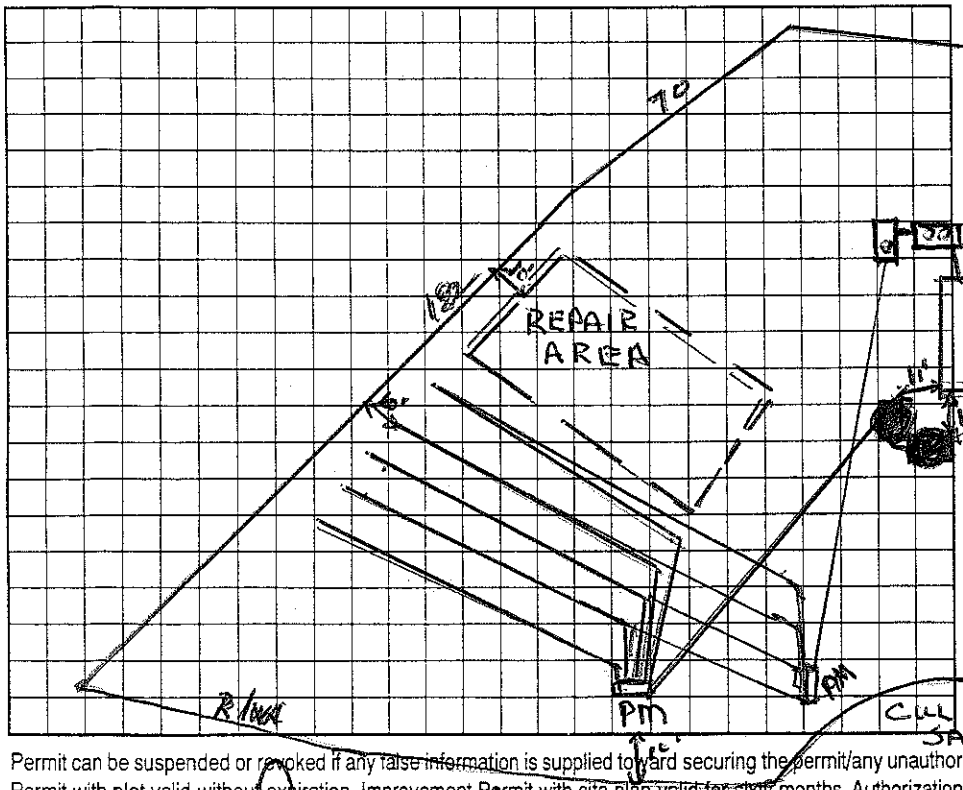

AS BUILT SKETCH

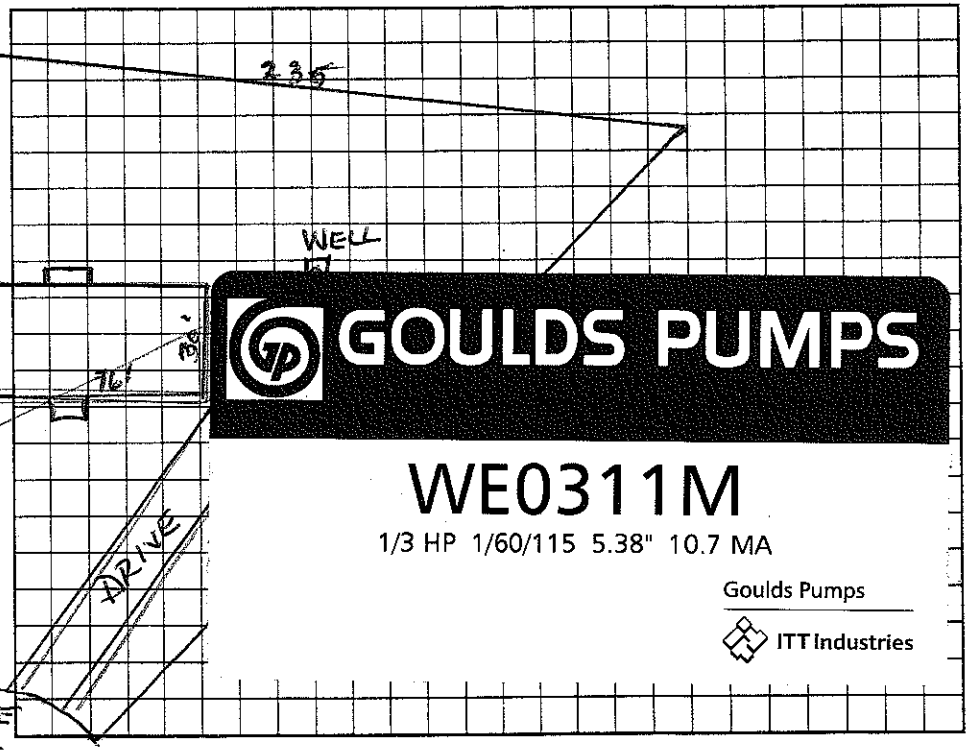

Permit can be suspended or revoked if any false information is supplied toward securing the permit/any unauthorized changes are made to the site/any unauthorized changes are made in the installation of the system. Improvement Permit with plat valid without expiration. Improvement Permit with site plan valid for sixty months. Authorization to Construct is valid for a period equal to that of Improvement Permit – not to exceed sixty months.

Signed: ✱ Dennis Gallihar date 11-29-04 Installed by: A-1 Backhoe

Improvement Permit by: Wesley Sparks RS. date 11/22/04 Operation Permit by: Wesley Sparks RS. date 12/17/04

Authorization to Construct by: Wesley Sparks RS. date 11/24/04 Existing System Inspection by: date

HEALTH DEPT. COPY: WHITE OWNER COPY (FINAL): YELLOW OWNER COPY (INITIAL): PINK