IREDELL COUNTY HEALTH DEPARTMENT

STATESVILLE 704-878-5305 MOORESVILLE 704-664-5281

IMPROVEMENT PERMIT / AUTHORIZATION TO CONSTRUCT / OPERATION PERMIT / EXISTING SYSTEM INSPECTION

PERMIT# 142460 PIN# 4679 01 8839 DATE 5/29/07

OWNER OR APPLICANT Beechwood Partners LLC PHONE: Business 704-664-9080 Home

ADDRESS 255 Rolling Hills Rd. Mooresville, NC. 28117

LOCATION 801 N TL Triplett Rd. TL Mallard Wood Dr. 2ND on (L) past Woodbine Ct.

SUBDIVISION Beechwood Est BLOCK SECTION LOT 16 LOT AREA .81 AC SITE CLASS PS DESIGN FLOW 480 L.T.A.R. .3

Septic Tank: 1000 Gallons; STB 750 Date 2/24/08

Pump Tank: 1000 Gallons; PT 363 Date 2/18/08

Pump Make: ZOELLER Model BN1512 Serial No. 3/2008

Nitrification Field: No Fields 1 Square Feet 400 Linear Feet 400 300

No Lines 3 @ 100 Trench Width 3' Max Trench Bottom Depth 3'

☒ New System ☐ Repair ☐ Expansion System Type: I II ⓘ IV V VI

System Description: PM → 25% REDUCTION

Repair System Description: 50% Reduction

Maintenance Agreement Required: ☐ Yes ☒ No

☒ House/Mod. Home No. Bedrooms 3

☐ Mobile Home No. Persons

☐ Business No. Employees

☐ Other

Water Supply: ☒ Individual ☐ Public ☐ Community


Gravel Depth No ☐ Gravity ☒ Pressure ☐ Slab ☒ Crawl Space ☐ Basement w/plumbing ☐ Basement wo/plumbing

Comments:/Conditions:

Comments:/Conditions:

1" = 50'

INITIAL SITE SKETCH

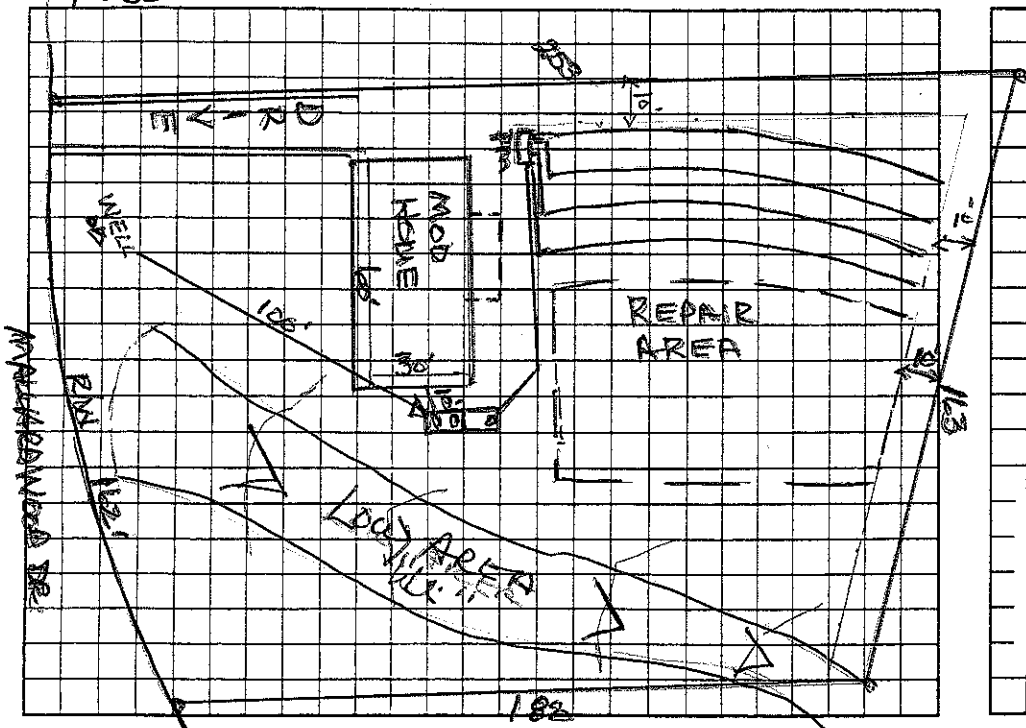

AS BUILT SKETCH

The proposed / existing GARAGE ADDITION addition does not appear to impact the existing septic system.

**NOTE: 15' FROM SIDE PROPERTY LINE

Wesley Sparks R.S.

Date: 6/29/07

ICHD-Environmental Health Division

Permit can be suspended or revoked if any false information is supplied toward securing the permit/any unauthorized changes are made to the site/any unauthorized changes are made in the installation of the system. Improvement Permit with plat valid without expiration ☐ Improvement Permit with site plan valid for sixty months ☐ Authorization to Construct is valid for a period equal to that of Improvement Permit – not to exceed sixty months.

Signed: [signature] date 6-28-07 Installed by: Chee Trading

Improvement Permit by: Wesley Sparks R.S. date 5/29/07 Operation Permit by: Wesley Sparks RS date 5/21/08

Authorization to Construct by: Wesley Sparks R.S. date 4/21/08 Existing System Inspection by: date

HEALTH DEPT. COPY: WHITE OWNER COPY (FINAL): YELLOW OWNER COPY (INITIAL): PINK