#575

IREDELL COUNTY HEALTH DEPARTMENT

STATESVILLE 704-878-5305 MOORESVILLE 704-664-5281

IMPROVEMENT PERMIT / AUTHORIZATION TO CONSTRUCT / OPERATION PERMIT / EXISTING SYSTEM INSPECTION

PERMIT# N/A PIN# 4679 02 9878 Pt. 4679-01-9478 DATE 2/21/03

OWNER OR CONTRACTOR KEITH - MOLLY COX PHONE: Business Home 704-6580062

ADDRESS 130 WOODBINE CT. MOORESVILLE, NC. 28115

LOCATION 115 N TR MAZEPPA RD. TR TRIPLETT RD TR MALLARD WOOD TL WOODBINE TO LOT ON (R) AT CUL DE SAC #130

SUBDIVISION BEECHWOOD EST. BLOCK / SECTION LOT 20+P/O 21 LOT AREA ~1.66AC SITE CLASS. DESIGN FLOW 600 L.T.A.R. .35

Septic Tank: 1500 Gallons; STB 338 Date 2/12/03
Pump Tank: 1500 Gallons; PT 338 Date 2/5/03
Pump Make: MYERS Model ME 100 S2 Serial No. (299) 12/02 394
Nitrification Field: No Fields 1 Square Feet 584 Linear Feet 292
No Lines 5 Trench Width 2' Max Trench Bottom Depth 36" Gravel Depth No

☐ New System ☒ Repair System Type: I, II, III, (IV) V, VI
System Description:
Repair System Description: PRESDOSED - 16" PPBRS
Maintenance Agreement Required: ☒ Yes ☐ No
☐ Slab ☒ Crawl Space ☐ Basement w/plumbing ☐ Basement wo/plumbing


☒ House/Mod. Home No. Bedrooms 5
☐ Mobile Home No. Bathrooms 3
☐ Business No. Employees
☐ Other

Water Supply: ☒ Individual ☐ Public ☐ Community


Comments:/Conditions:

Comments:/Conditions:

INITIAL SITE SKETCH

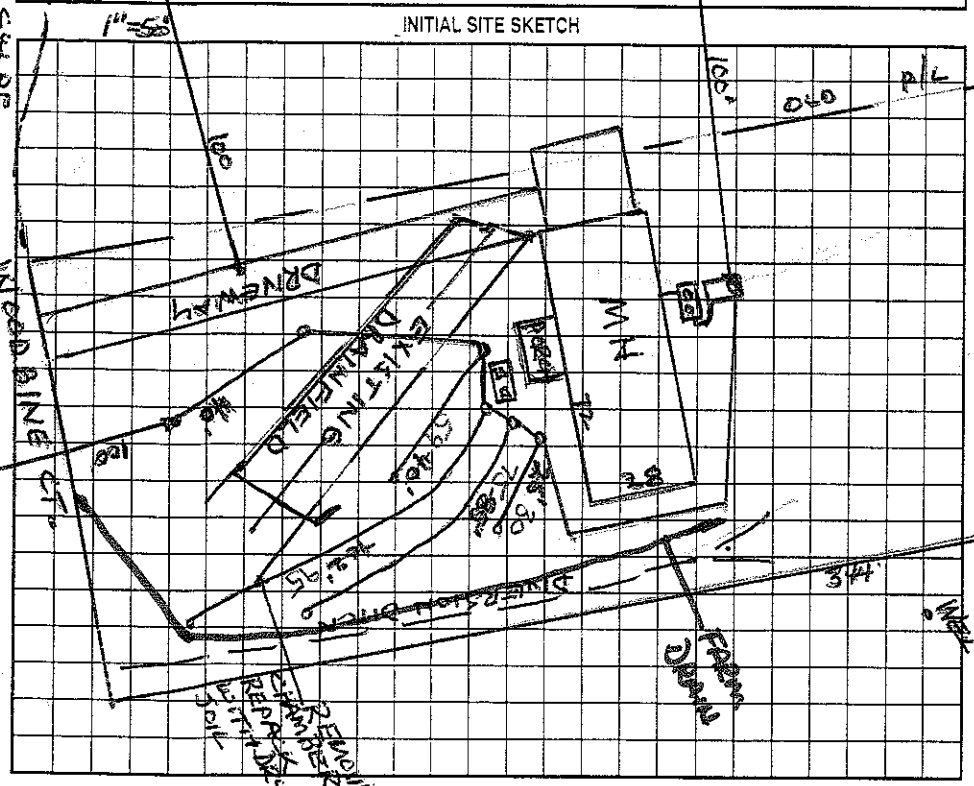

AS BUILT SKETCH

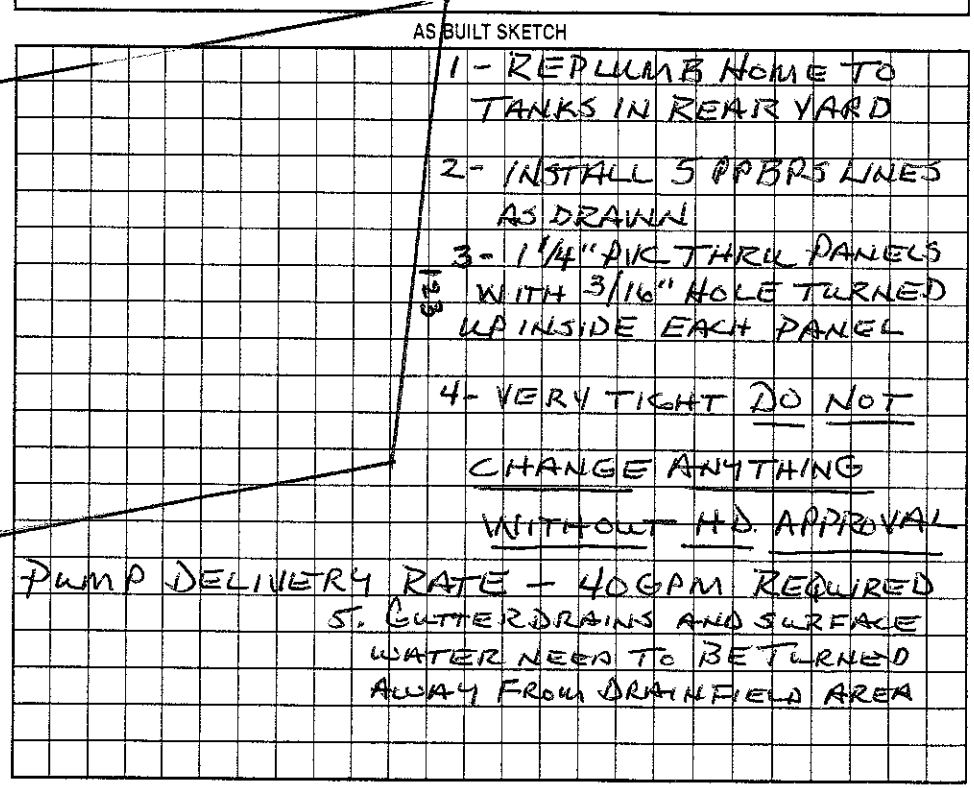

Permit can be suspended or revoked if any false information is supplied toward securing the permit/any unauthorized changes are made to the site/any unauthorized changes are made in the installation of the system. Improvement Permit with plat valid without expiration. Improvement Permit with site plan valid for sixty months. Authorization to Construct is valid for a period equal to that of Improvement Permit – not to exceed sixty months.

Signed: Carl Bridgman date

Improvement Permit by: Wesley Sparks RS. date 2/21/03

Authorization to Construct by: Wesley Sparks RS. date 2/21/03

Installed by: James Russell

Operation Permit by: Wesley Sparks RS date 1/24/05

Existing System Inspection by: date

HEALTH DEPT. COPY: WHITE OWNER COPY (FINAL): YELLOW OWNER COPY (INITIAL): PINK