IREDELL COUNTY HEALTH DEPARTMENT

STATESVILLE 704-878-5305 MOORESVILLE 704-664-5281

IMPROVEMENT PERMIT / AUTHORIZATION TO CONSTRUCT / OPERATION PERMIT / EXISTING SYSTEM INSPECTION

PERMIT# 93009 PIN# 4679029878 PT DATE 1/9/01

OWNER OR CONTRACTOR BEECHWOOD PARTNERS PHONE: Business 664-9080 Home

ADDRESS 225 ROLLING HILLS RD. MOORESVILLE NC 28117

LOCATION 801 N- TL TRIPLETT- TL MALLARD WOOD- TL WOODBINE -ON RT / 130 WOODBINE CT

SUBDIVISION BEECHWOOD EST. BLOCK / SECTION LOT 20 LOT AREA 1.94AC±SOME OF 21 SITE CLASS. RS DESIGN FLOW 360GPD L.T.A.R. .36PD/FT²

Septic Tank: 1000 Gallons; STB 865 Date 1/8/01

Pump Tank: Gallons; PT Date

Pump Make: Model Serial No.

Nitrification Field: No Fields 1 Square Feet 900 Linear Feet 300

No Lines 3@100' Trench Width 36" Max Trench Bottom Depth 36" Gravel Depth N/A

☑ New System ☐ Repair System Type: I, II, (III), IV, V, VI

System Description: GRAVITY 25% REDUCTION

Repair System Description: LP PANEL

Maintenance Agreement Required: ☐ Yes ☑ No

☑ House/Mod. Home No. Bedrooms 3

☑ Mobile Home No. Bathrooms 3

☐ Business No. Employees

☐ Other


☐ Slab ☐ Crawl Space ☑ Basement w/plumbing ☐ Basement wo/plumbing

Water Supply: ☑ Individual ☐ Public ☐ Community


Comments:/Conditions: 35FT NEW LOT LINE

Comments:/Conditions: SOME OF LOT (21)

INITIAL SITE SKETCH

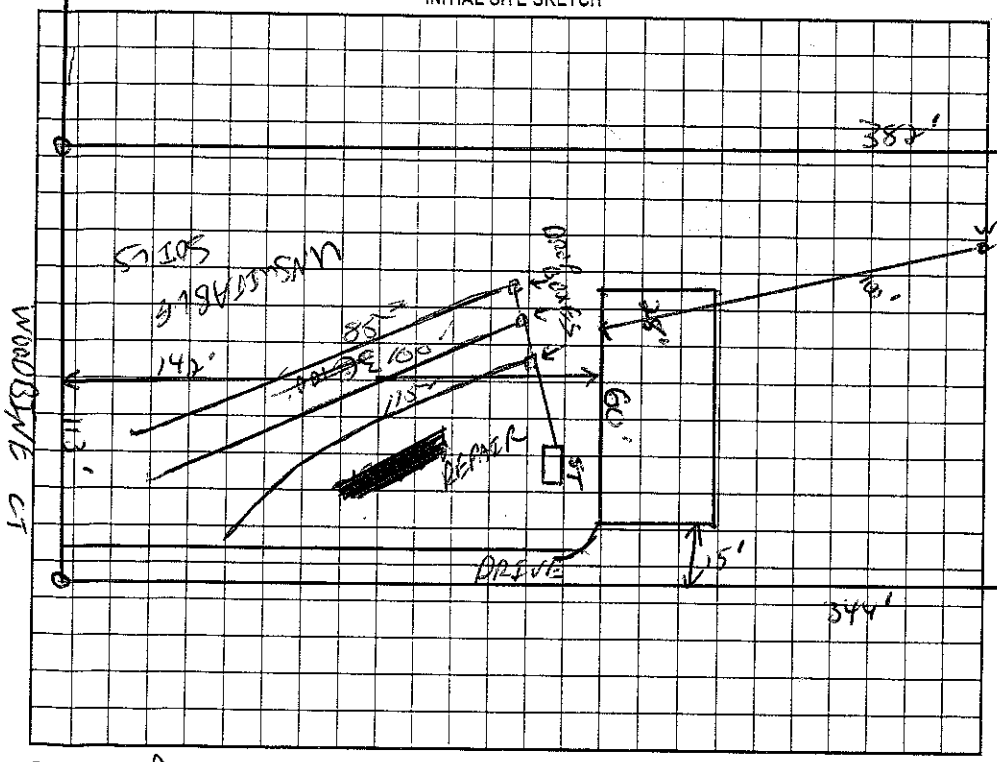

AS BUILT SKETCH

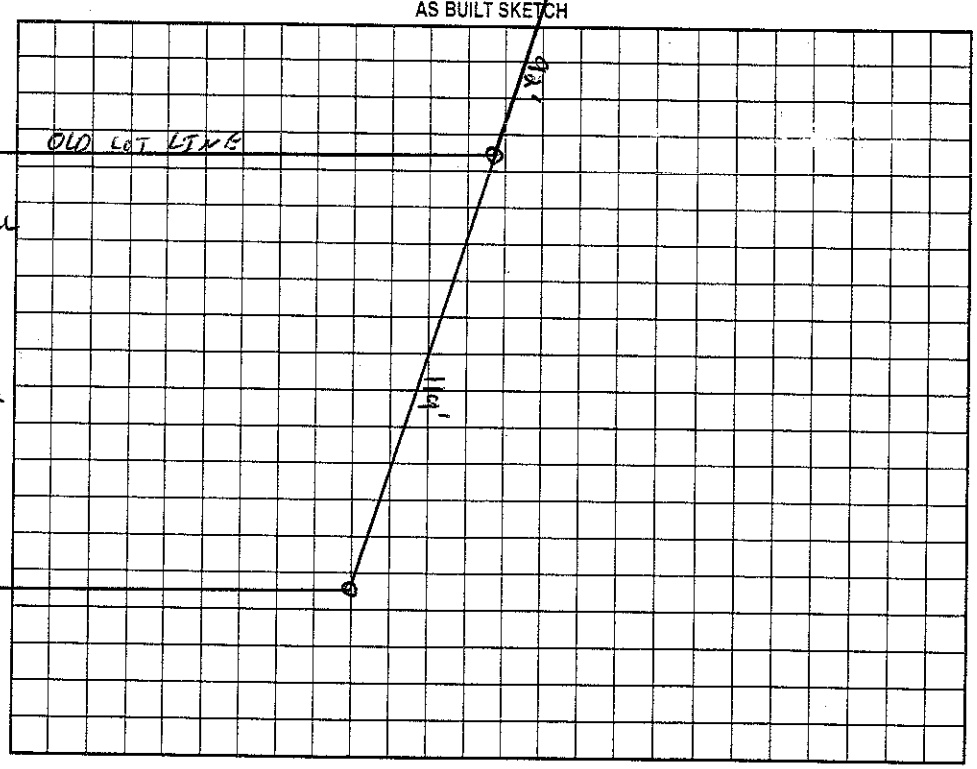

Permit can be suspended or revoked if any false information is supplied toward securing the permit/any unauthorized changes are made to the site/any unauthorized changes are made in the installation of the system. Improvement Permit with plat valid without expiration. Improvement Permit with site plan valid for sixty months. Authorization to Construct is valid for a period equal to that of Improvement Permit – not to exceed sixty months.

Signed: date 1/29/01

Improvement Permit by: date 1/9/01

Authorization to Construct by: date 4/20/01

Installed by: Piedmont Septic

Operation Permit by: date 5/10/01

Existing System Inspection by: date

HEALTH DEPT. COPY: WHITE OWNER COPY (FINAL): YELLOW OWNER COPY (INITIAL): PINK