IREDELL COUNTY HEALTH DEPARTMENT

Paid 125.00 3:30

STATESVILLE 704-878-5305 MOORESVILLE 704-664-5281

IMPROVEMENT PERMIT / AUTHORIZATION TO CONSTRUCT / OPERATION PERMIT / EXISTING SYSTEM INSPECTION

PERMIT# 092995 PIN# 4679 02 9878 (pt) 4679-01-9974 DATE Nov. 29, 00

OWNER OR CONTRACTOR Beechwood Partners / Southern Luxury Desc. Homes PHONE: Business 664-9080 Home

ADDRESS 255 Rolling Hills Rd. Mooresville NC 28117

LOCATION 80 N TL Triplett Rd. TL Mallardwood Dr. TL Woodbine Ct. on Right - corner lot

SUBDIVISION Beechwood Est. BLOCK / SECTION LOT 17 LOT AREA .81 Ac SITE CLASS. 85 DESIGN FLOW 360 gpd L.T.A.R. .3

Septic Tank: 1000 Gallons; STB 825 Date 11/1/00
Pump Tank: 1000 Gallons; PT 307 Date 10/17/00
Pump Make: ZOELLER Model N-137C Serial No. 10100
Nitrification Field: No Fields 1 Square Feet 900 Linear Feet 300
No Lines 2 Trench Width 36" Max Trench Bottom Depth 36"

☑ New System ☐ Repair System Type: I, II, (III), IV, V, VI
System Description: PM Innovative - 25% Reduction
Repair System Description: Same
Maintenance Agreement Required: ☐ Yes ☑ No
Gravel Depth N/A


☐ House/Mod. Home No. Bedrooms 3
☑ Mobile Home DW No. Bathrooms 2
☐ Business No. Employees
☐ Other
☐ Slab ☑ Crawl Space ☐ Basement w/plumbing ☐ Basement wo/plumbing

Water Supply: ☑ Individual ☐ Public ☐ Community


Comments:/Conditions:

Comments:/Conditions: 12/29/00 - No water from well

INITIAL SITE SKETCH

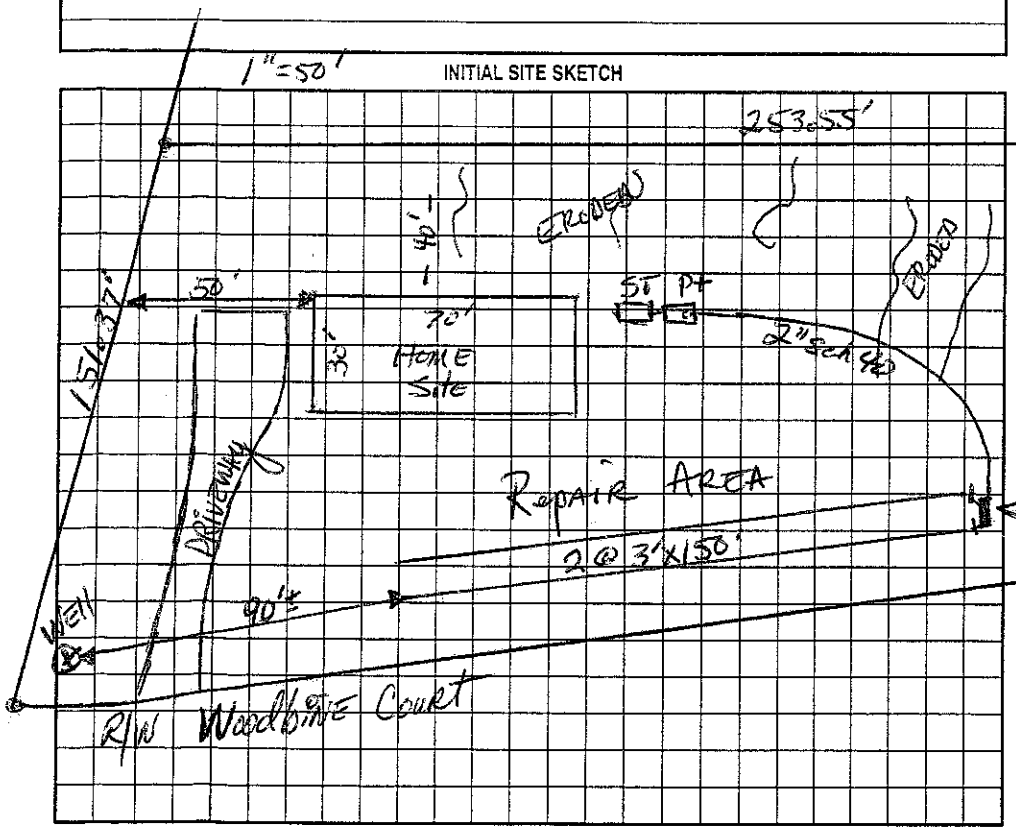

AS BUILT SKETCH

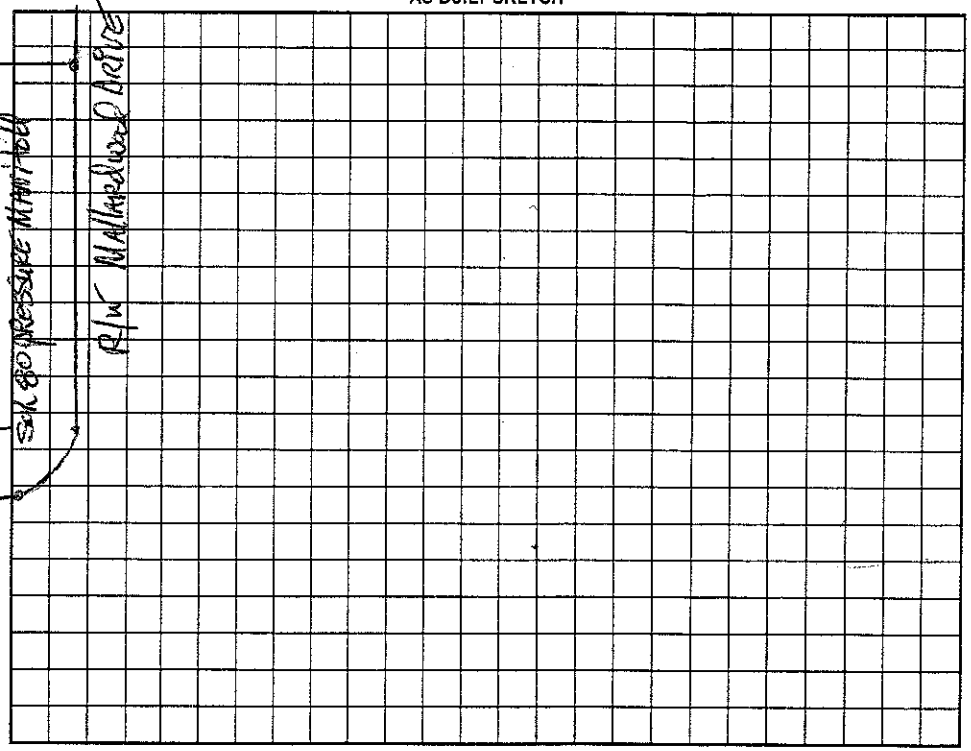

Permit can be suspended or revoked if any false information is supplied toward securing the permit/any unauthorized changes are made to the site/any unauthorized changes are made in the installation of the system. Improvement Permit with plat valid without expiration. Improvement Permit with site plan valid for sixty months. Authorization to Construct is valid for a period equal to that of Improvement Permit – not to exceed sixty months.

Signed: date 11/30/00 Installed by: Randy Melton - Piedmont Septic Tank

Improvement Permit by: date 11-29-00 Operation Permit by: Wesley Sparks RS. date 1/2/01

Authorization to Construct by: date 12/6/00 Existing System Inspection by: date

HEALTH DEPT. COPY: WHITE OWNER COPY (FINAL): YELLOW OWNER COPY (INITIAL): PINK