IREDELL COUNTY HEALTH DEPARTMENT

ATESVIL[illegible]378-5305 MOORESVILLE 704-664-5281

IMPROVEMENT PERMIT / AUTHORIZATION TO CON[illegible] / OPERATION PERMIT / EXISTING SYSTEM INSPECTION

PERMIT# 42986 PIN# [redacted] PT [redacted] 4699026195 DATE 9/7/04

OWNER OR CONTRACTOR Fleetwood Homes PHONE: Business 828-902-7773 Home

ADDRESS 1040 Charlotte Hwy Troutman NC

LOCATION 80 N, TL Tripplett, TL Mallard Wood on RT

SUBDIVISION Beechwood Est. BLOCK / SECTION LOT 9 LOT AREA 1.11 Ac SITE CLASS PS DESIGN FLOW 480 L.T.A.R. 0.3

Septic Tank: 1000 Gallons; STB 1012 Date 5/4/07

Pump Tank: Gallons; PT Date

Pump Make: Model Serial No.

Nitrification Field: No Fields 1 Square Feet 1200 Linear Feet 400

No Lines 5 @ 80' Trench Width 36" Max Trench Bottom Depth 36" Gravel Depth —

☒ New System ☐ Repair System Type: I, II, III, IV, V, AT

System Description: Gravity 25% Reduct.

Repair System Description: Panel Block

Maintenance Agreement Required: ☐ Yes ☒ No

☐ House/Mod. Home No. Bedrooms 4

☒ Mobile Home No. Bathrooms

☐ Business No. Employees

☐ Other

☐ Slab ☒ Crawl Space ☐ Basement w/plumbing ☐ Basement wo/plumbing

Water Supply: ☒ Individual ☐ Public ☐ Community


Comments:/Conditions:

Drive & Tank Location Switched


Comments:/Conditions:

1"=50'

INITIAL SITE SKETCH

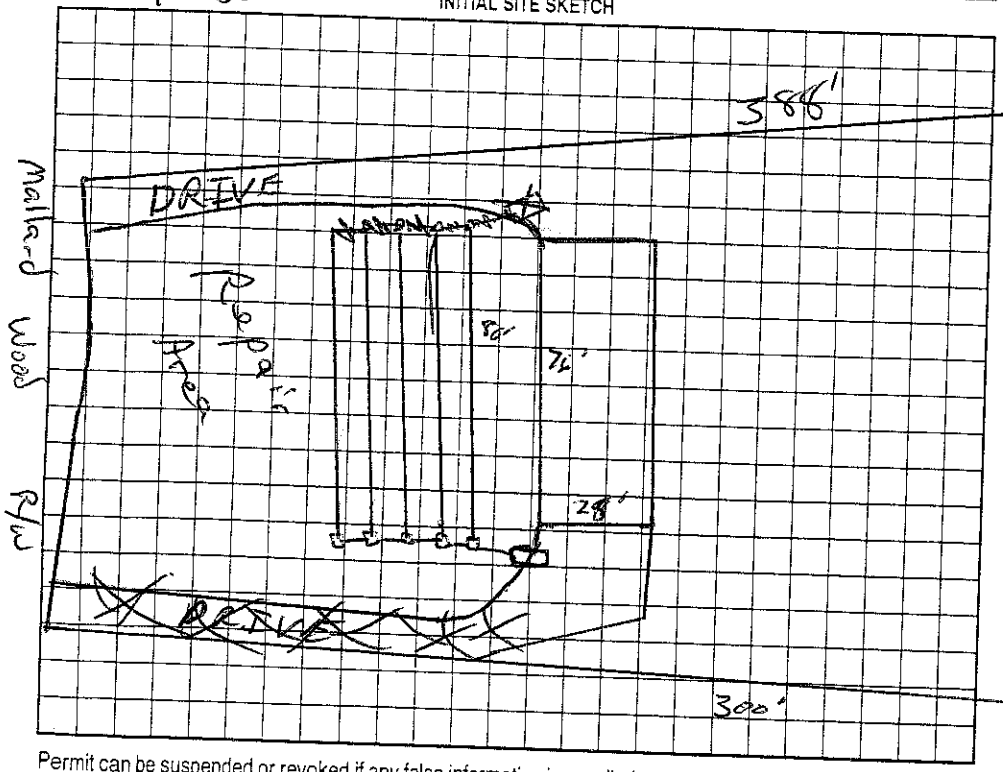

AS BUILT SKETCH

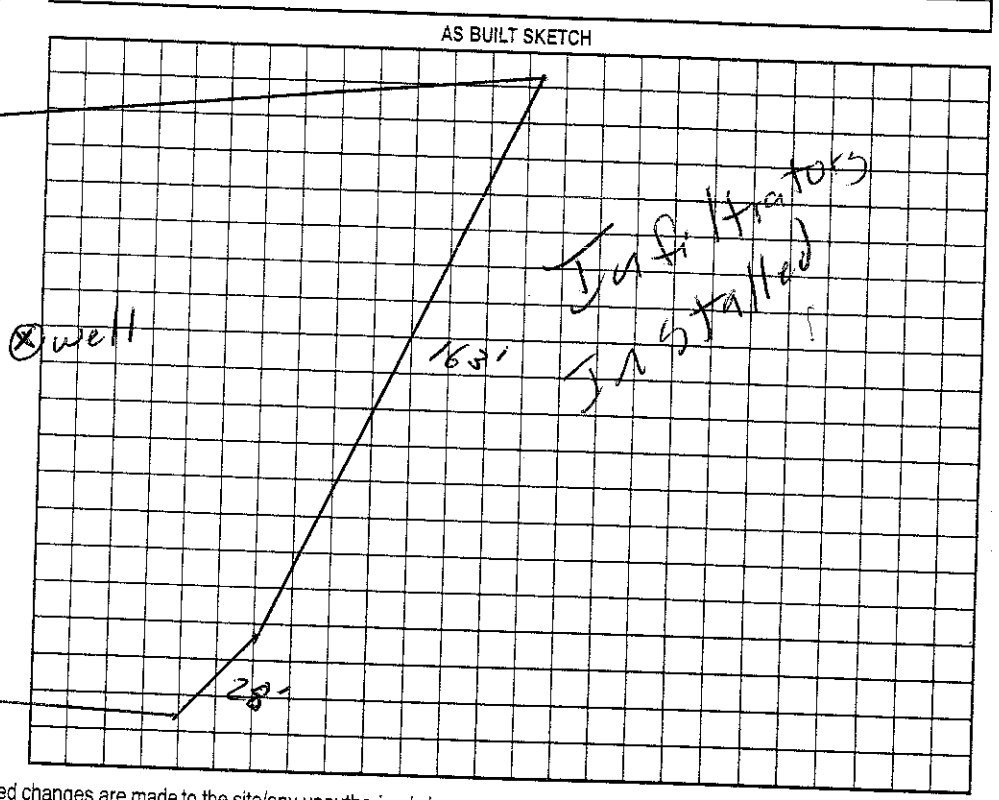

Permit can be suspended or revoked if any false information is supplied toward securing the permit/any unauthorized changes are made to the site/any unauthorized changes are made in the installation of the system. Improvement Permit with plat valid without expiration. Improvement Permit with site plan valid for sixty months. Authorization to Construct is valid for a period equal to that of Improvement Permit – not to exceed sixty months.

Signed: David Lykins date 9/9/04

Improvement Permit by: RS date 9/7/04

Authorization to Construct by: RS date 9/7/04

Installed by: A-1 Backhoe

Operation Permit by: RS date 9/16/04

Existing System Inspection by: date

HEALTH DEPT. COPY: WHITE OWNER COPY (FINAL): YELLOW OWNER COPY (INITIAL): PINK