# IREDELL COUNTY HEALTH DEPARTMENT

STATESVILLE 704-878-5305 MOORESVILLE 704-664-5281

## IMPROVEMENT PERMIT / AUTHORIZATION TO CONSTRUCT / OPERATION PERMIT / EXISTING SYSTEM INSPECTION

PERMIT# 92986 PIN# ~~4679-02-9875~~ PT DATE 1/6/01

OWNER OR CONTRACTOR BEECHWOOD FARMERS PHONE: Business 664-9080 Home

ADDRESS 225 ROLLING HILLS RD MOORESVILLE

LOCATION 801 N - TL TREPLETT - TL MALLARD WOOD - ON RT


SUBDIVISION BEECHWOOD EST BLOCK / SECTION LOT 9 LOT AREA 1.11 SITE CLASS. B DESIGN FLOW 360GPD L.T.A.R. .30PD/FT²

| | | | |
|---|---|---|---|
| Septic Tank: 1000 Gallons; STB Date | ☑ New System ☐ Repair System Type: I, II, III, IV, V, VI | ☐ ~~House/Mod. Home~~ No. Bedrooms 3 | Water Supply: |
| Pump Tank: Gallons; PT Date | System Description: GRAVITY INNOVATIVE | ☑ ~~Mobile Home~~ No. Bathrooms 3 | ☑ ~~Individual~~ |
| Pump Make: Model Serial No. | Repair System Description: SA NE | ☐ Business No. Employees | ☐ Public |
| Nitrification Field: No Fields 1 Square Feet 900 Linear Feet 300 | Maintenance Agreement Required: ☐ Yes ☑ ~~No~~ | ☐ Other | ☐ Community |
| No Lines 4@75' Trench Width 36" Max Trench Bottom Depth 36" Gravel Depth N/A | ☐ Slab ☑ ~~Crawl Space~~ ☐ Basement w/plumbing ☐ Basement wo/plumbing | | |


Comments:/Conditions:

Comments:/Conditions:

INITIAL SITE SKETCH 1" = 50'

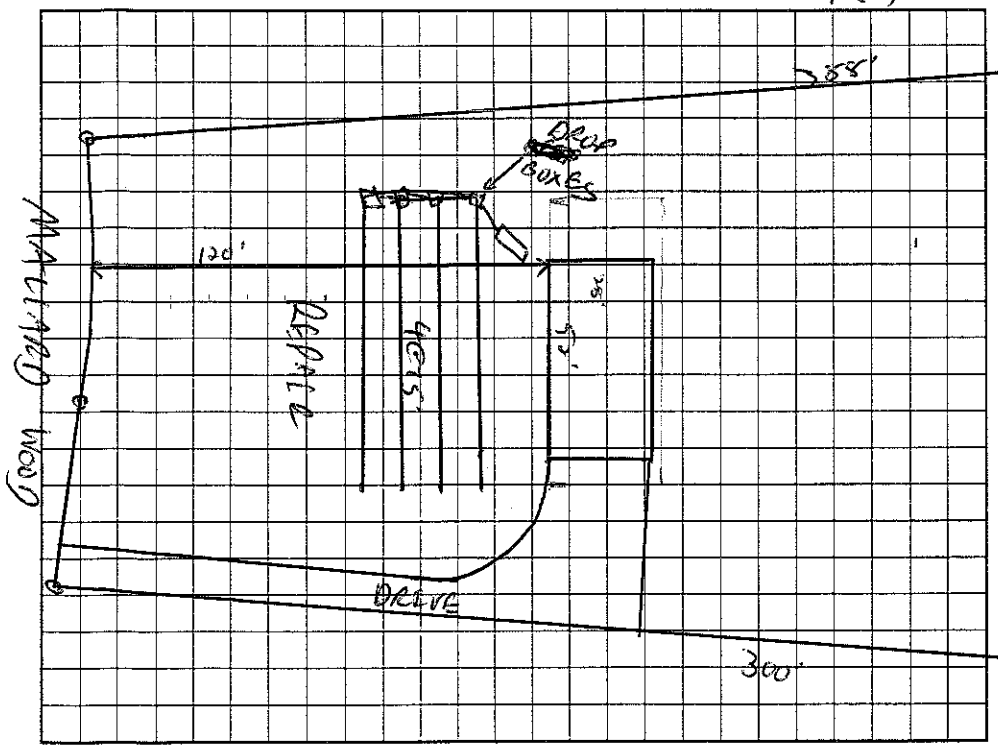


AS BUILT SKETCH

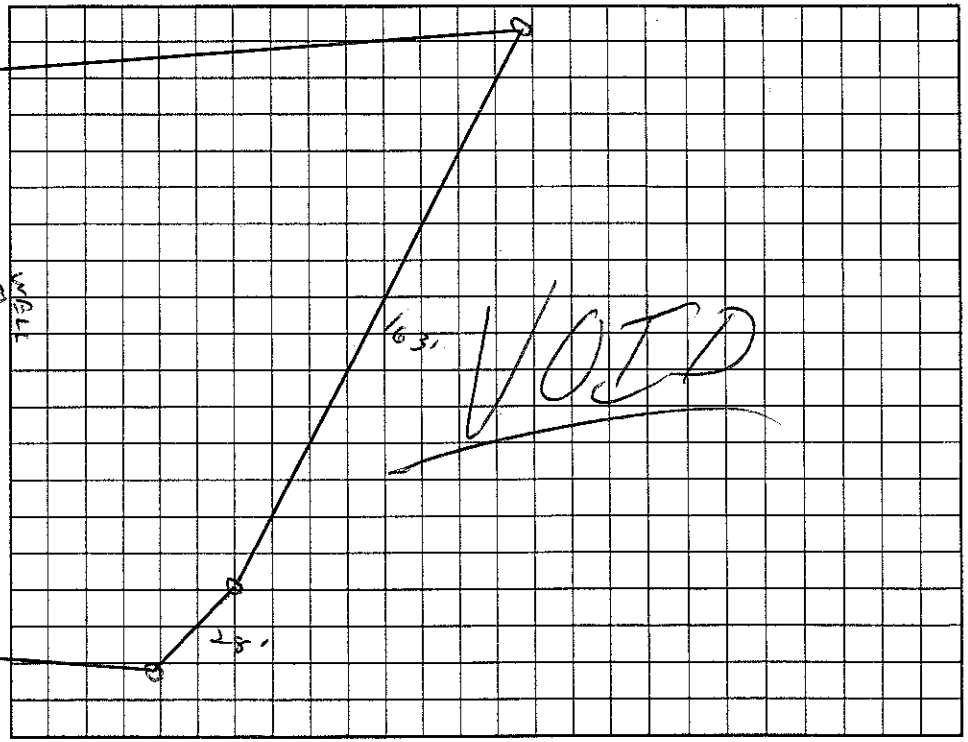


Permit can be suspended or revoked if any false information is supplied toward securing the permit/any unauthorized changes are made to the site/any unauthorized changes are made in the installation of the system. Improvement Permit with plat valid without expiration. Improvement Permit with site plan valid for sixty months. Authorization to Construct is valid for a period equal to that of Improvement Permit – not to exceed sixty months.

Signed: James E Allen date 1/29/01

Improvement Permit by: C. Sizemore ES date 1/6/01

Authorization to Construct by: date

Installed by:

Operation Permit by: date

Existing System Inspection by: date

HEALTH DEPT. COPY: WHITE OWNER COPY (FINAL): YELLOW OWNER COPY (INITIAL): PINK