10:30 - A-1

IREDELL COUNTY HEALTH DEPARTMENT

STATESVILLE 704-878-5305 MOORESVILLE 704-664-5281

IMPROVEMENT PERMIT / AUTHORIZATION TO CONSTRUCT / OPERATION PERMIT / EXISTING SYSTEM INSPECTION

PERMIT# 92987 PIN# 4679024878 PT 8288 DATE 12/7/00

OWNER OR CONTRACTOR BEECHWOOD PARTNERS PHONE: Business 664-9080 Home

ADDRESS 225 ROLLING HILLS RD - MOORESVILLE NC 28117

LOCATION ~~HIGH~~ 801 N - TL TRIPLETT - TL MALLARDWOOD - ON RT

SUBDIVISION BEECHWOOD EST BLOCK / SECTION LOT 10 LOT AREA 1.11AC SITE CLASS. RS DESIGN FLOW 360GPD L.T.A.R. .36GPD/FT²

Septic Tank: 1000 Gallons; STB 1012 Date 9/27/2000

Pump Tank: Gallons; PT Date

Pump Make: Model Serial No.

Nitrification Field: No Fields 1 Square Feet 1200 Linear Feet 400

No Lines 4@100' Trench Width 36" Max Trench Bottom Depth 36" Gravel Depth 12"

☑ New System ☐ Repair System Type: I (II) III, IV, V, VI

System Description: GRAVITY CONVENTIONAL

Repair System Description: 25% REDUCTION/GRAVITY

Maintenance Agreement Required: ☐ Yes ☑ No

☑ House/Mod. Home No. Bedrooms 3

☐ Mobile Home No. Bathrooms 3

☐ Business No. Employees

☐ Other


☐ Slab ☑ Crawl Space ☐ Basement w/plumbing ☐ Basement wo/plumbing

Water Supply: ☑ Individual ☐ Public ☐ Community


Comments:/Conditions: KEEP WELL 100' FROM SEPTIC SYSTEM

Comments:/Conditions:

INITIAL SITE SKETCH

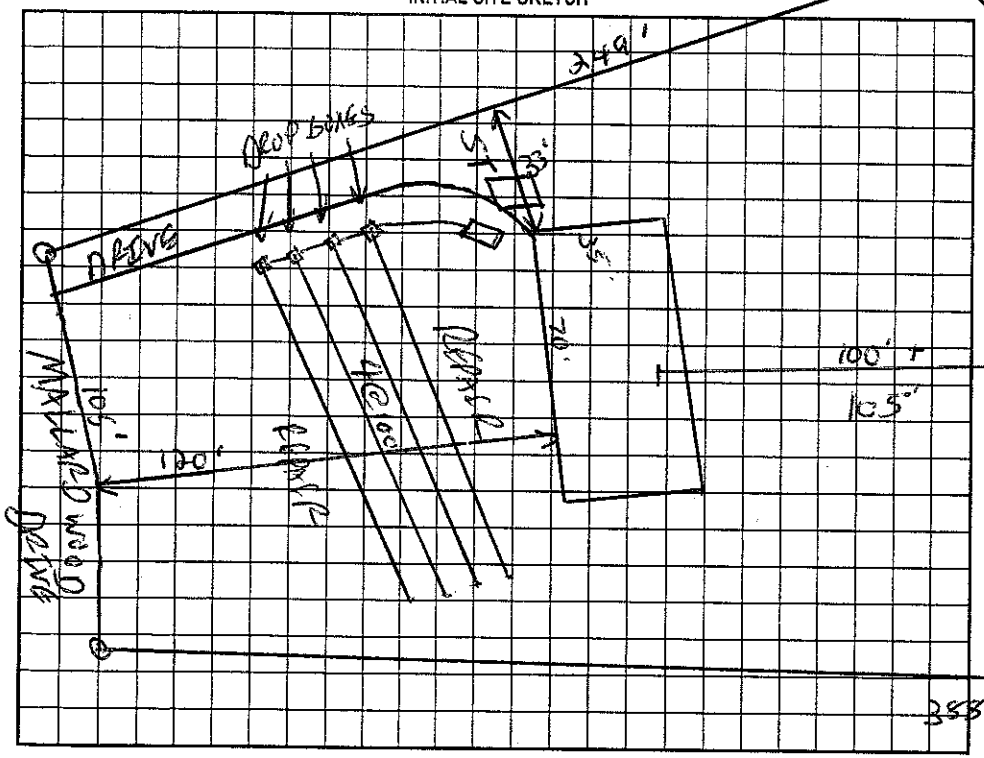

AS BUILT SKETCH

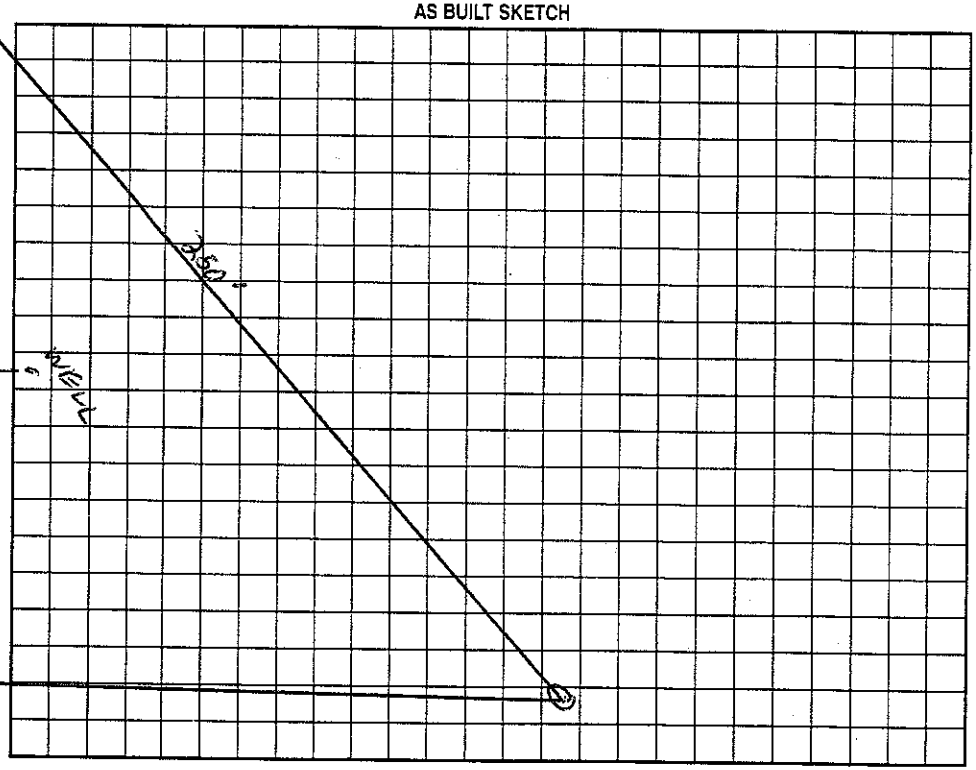

Permit can be suspended or revoked if any false information is supplied toward securing the permit/any unauthorized changes are made to the site/any unauthorized changes are made in the installation of the system. Improvement Permit with plat valid without expiration. Improvement Permit with site plan valid for sixty months. Authorization to Construct is valid for a period equal to that of Improvement Permit – not to exceed sixty months.

Signed: date 12/11/00 Installed by: A-1 Backhoe

Improvement Permit by: date 12/7/00 Operation Permit by: date 1/5/2001

Authorization to Construct by: date 1/4/01 Existing System Inspection by: date

HEALTH DEPT. COPY: WHITE OWNER COPY (FINAL): YELLOW OWNER COPY (INITIAL): PINK